


U. S. PUBLIC LAND SURVEY MONUMENT RECORD

SECTION 9 T 17 N, R 5 W, TOWN OF BURNS
LACROSSE COUNTY

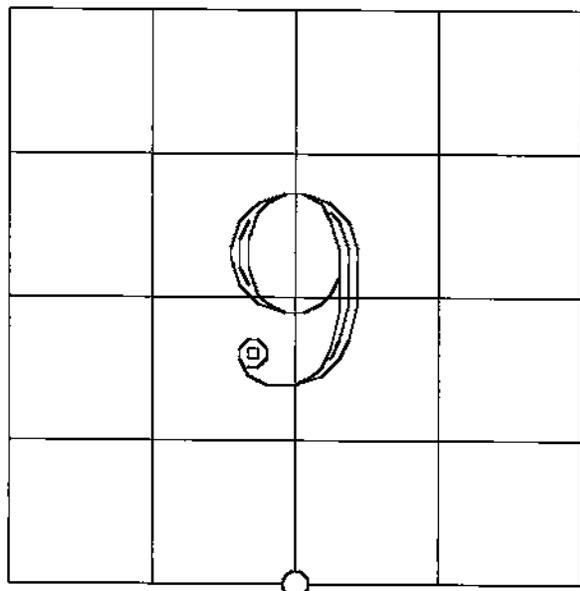

LOCATION OF LANDMARK

CREW: CHRIS FECHNER
 JOSH NAVE
 TRENT ROBBINS

DATE: 2/8/01

Describe any record evidence, monument evidence, testimonial evidence, or any other material evidence you considered and whether the monument was found or restored through acceptance of an obliterated evidence location.

WE TRAVERSED EXTENSIVELY IN THIS AREA; NORTH ONE MILE;
 SOUTH ONE MILE; WEST ONE HALF MILE AND EAST ONE HALF MILE.
 THE EXISTING FENCE OCCUPATION FIT THE RECORD MEASUREMENT
 FROM THE EAST VERY WELL. WE ALSO CHECKED INTO THE CENTER
 OF SECTION 16 OCCUPATION VERY WELL. THE EXISTING FENCE
 OCCUPATION WAS THE BEST EVIDENCE OF THE CORNER LOCATION.
 WE MONUMENTED THE CORNER WITH A 3/4" X 30" IRON BAR.

Describe or show any material discrepancy between the location of the restored corner and that of the corner previously restored or reestablished.

LACROSSE CO. COORDINATE SYSTEM

North 184632.950

East 516293.673

Theta Angle

Horiz. Order

Vert. Order

TYPE OF LANDMARK


3/4" X 30" IRON BAR

BEARINGS ARE REFERENCED TO
 LACROSSE COUNTY
 COORDINATE SYSTEM

RECORD OF DURABLE WITNESS MONUMENTS


NO	DESCRIPTION	MAGNETIC BEARING	DISTANCE
1	MAG NAIL IN 20" WHITE OAK	S 86° W	14.46'
2	MAG NAIL IN 36" RED OAK	S 5° E	19.20'
3	MAG NAIL IN 26" RED OAK	S 80°30' E	11.75'
4	WOOD FENCE POST	SE	± 0.50'

(NOT TO SCALE)

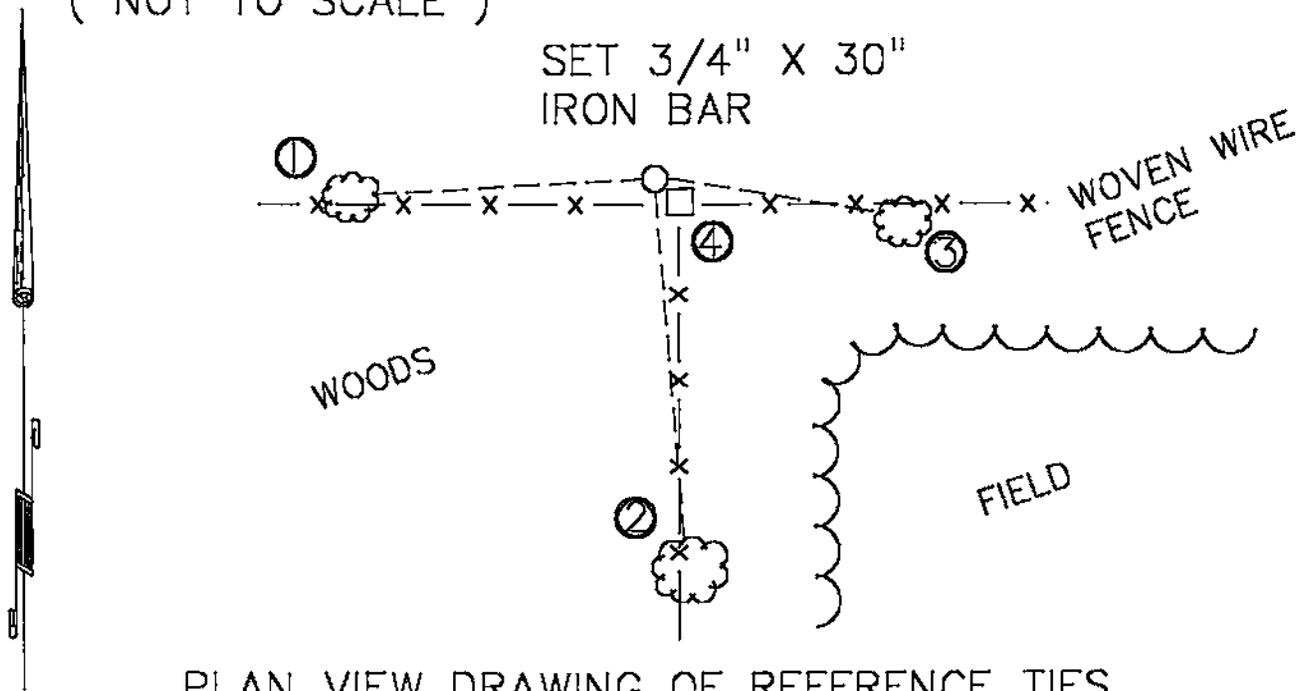

PLAN VIEW DRAWING OF REFERENCE TIES

MAP SHOWING DISTANCE AND DIRECTION TO OTHER PUBLIC LAND SURVEY CORNERS USED FOR REESTABLISHING THE CORNER

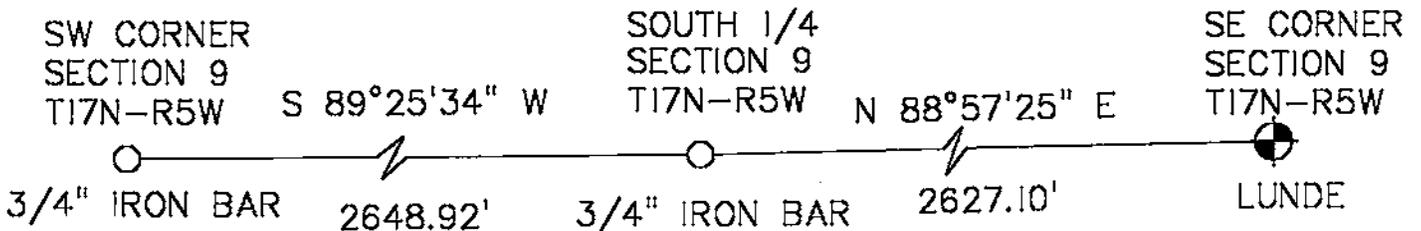

I, CHRISTOPHER W^m FECHNER

HEREBY CERTIFY THAT THE CORNER LOCATION SHOWN ON THIS RECORD WAS DETERMINED BY ME OR UNDER MY DIRECTION AND CONTROL AND THAT THIS U. S. PUBLIC LAND SURVEY MONUMENT RECORD IS CORRECT AND COMPLETE TO THE BEST OF MY KNOWLEDGE AND BELIEF.

Christopher W^m Fechner

2/08/01

Signature

Date



Seal