


U. S. PUBLIC LAND SURVEY MONUMENT RECORD

SECTION 10 T 17 N, R 5 W, TOWN OF BURNS

LA CROSSE COUNTY

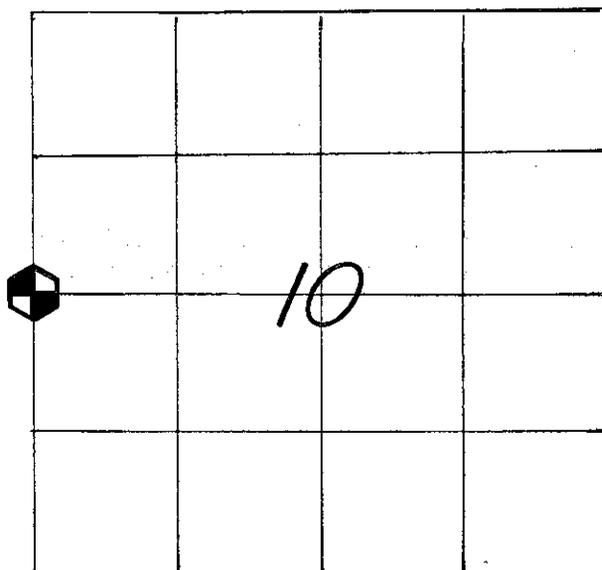

LOCATION OF LANDMARK

CREW: **BRYAN H. MEYER**
PETER F. FOLLANSBEE
 DATE: **4/22/2010**

WISCONSIN COORDINATE SYSTEM

North **717,477.696**East **1,712,669.555**

Theta Angle

Horiz. Order

Vert. Order

DATUM: **1983 ('91)**

TYPE OF LANDMARK

BRASS CAP LUNDE MARKER.

BEARINGS ARE REFERENCED TO


GRID NORTH AS PER SECTION DATA.

Describe any record evidence, monument evidence, testimonial evidence or any other material evidence you considered and whether the monument was found or restored through acceptance of an obliterated evidence location.


Describe or show any material discrepancy between the location of the restored corner and that of the corner previously restored or reestablished.

RECORD OF DURABLE WITNESS MONUMENTS

NO	DESCRIPTION	BEARING	DISTANCE
1	SET A 3/4" x 30" IRON BAR DOWN 2"s, 12' N. OF ζ	WEST \pm	32.92 FT.
2	EX. IRON PIPE AT TOP OF BACKSLOPE OF ROAD DITCH	NORTH \pm	20.28 FT.
3	SET A 3/4" x 30" IRON BAR DOWN 2"s, 12' N. OF	EAST \pm	33.05 FT.
4	EX. IRON PIPE 4.5' NORTH OF CENTERLINE	S.-EASTERLY \pm	12.60 FT.

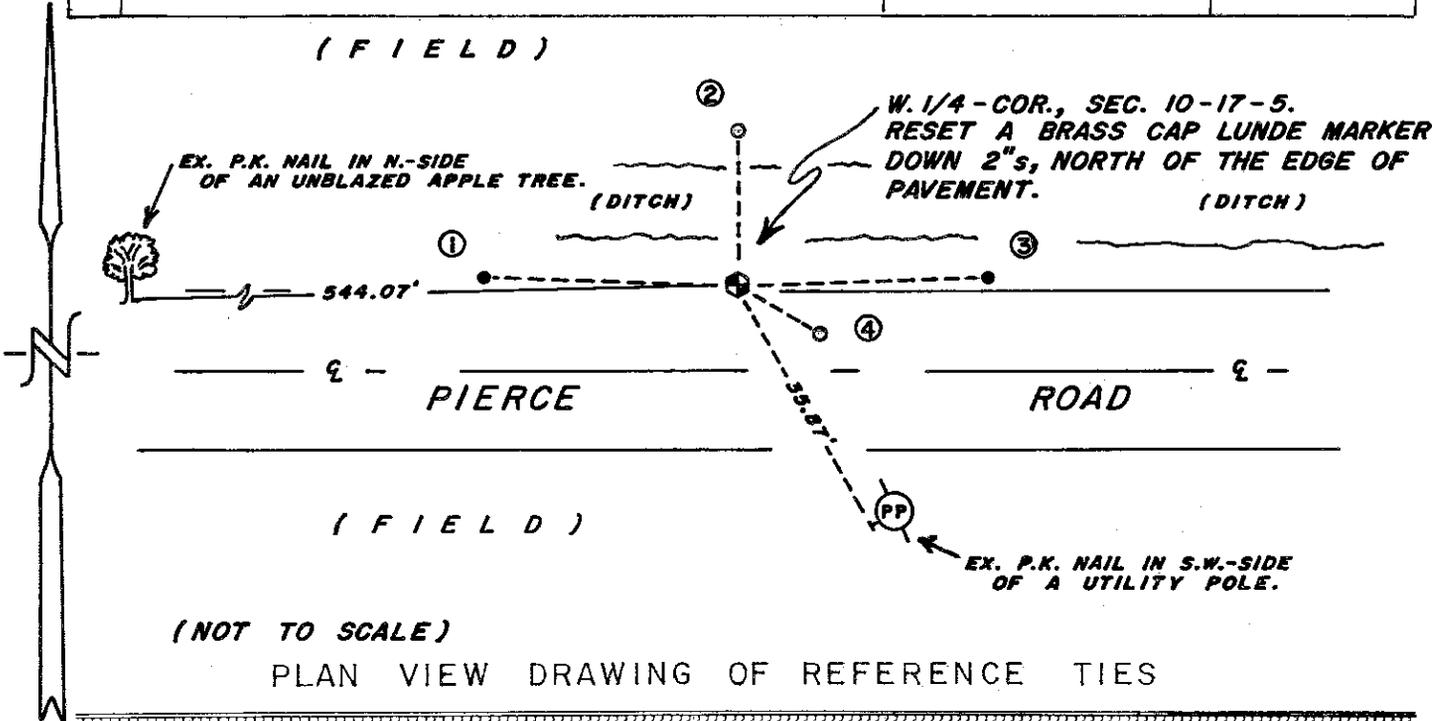

MAP SHOWING DISTANCE AND DIRECTION TO OTHER PUBLIC LAND SURVEY CORNERS USED FOR REESTABLISHING THE CORNER

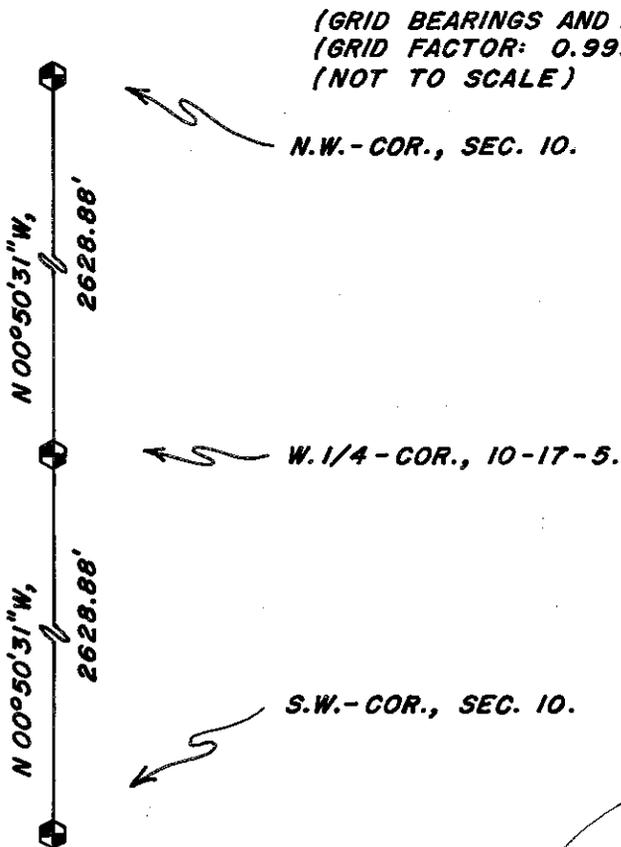

I, BRYAN H. MEYER, COUNTY SURVEYOR
 HEREBY CERTIFY THAT THE CORNER LOCATION SHOWN ON THIS RECORD
 WAS DETERMINED BY ME OR UNDER MY DIRECTION AND CONTROL AND
 THAT THIS U. S. PUBLIC LAND SURVEY MONUMENT RECORD IS CORRECT
 AND COMPLETE TO THE BEST OF MY KNOWLEDGE AND BELIEF.

Bryan H. Meyer Signature 7/14/2010 Date




Seal

21705092000

U. S. PUBLIC LAND SURVEY MONUMENT RECORD

SECTION 10 T 17 N, R 5 W, TOWN OF BURNS

LA CROSSE COUNTY

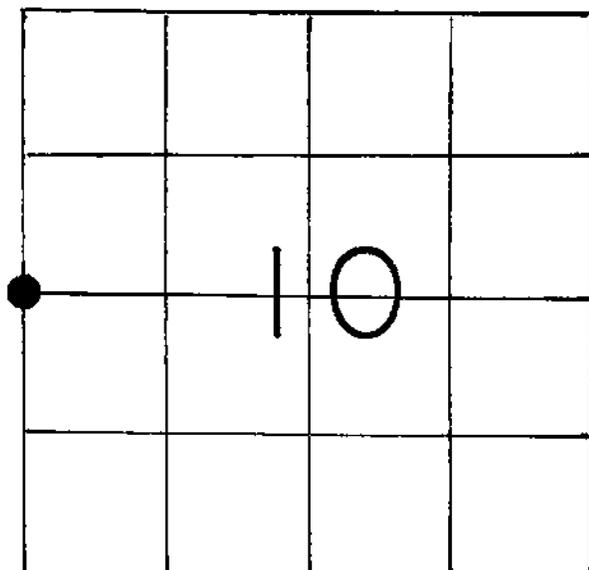

LOCATION OF LANDMARK

Crew: William C. Jung
Peter F. FollansbeeDate: 9/22/92Crew: William C. Jung
Peter F. FollansbeeDate: 6/10/02

Describe any record evidence, monument evidence, testimonial evidence or any other material evidence you considered and whether the monument was found or restored through acceptance of an obliterated evidence location.

I set this corner by single proportionate measurement.

6/10/02 - We reset the Lunde as it had been "disturbed" during road construction.

Describe or show any material discrepancy between the location of the restored corner and that of the corner previously restored or reestablished.

None known.

WISCONSIN COORDINATE SYSTEM

North

East

Theta Angle

Horiz. Order

Vert. Order

TYPE OF LANDMARK


Brass capped Lunde marker

BEARINGS ARE REFERENCED TO

True (\pm 02')

RECORD OF DURABLE WITNESS MONUMENTS

NO	DESCRIPTION	BEARING	DISTANCE
1	P.K. nail in unblazed apple tree	-----	544.07
2	Set an iron pipe 2.8' to East of tie post	-----	20.28
3	Set an iron pipe 4.5' North of centerline	True = S58°33'E	12.60
4	P.K. nail in utility pole	-----	35.87

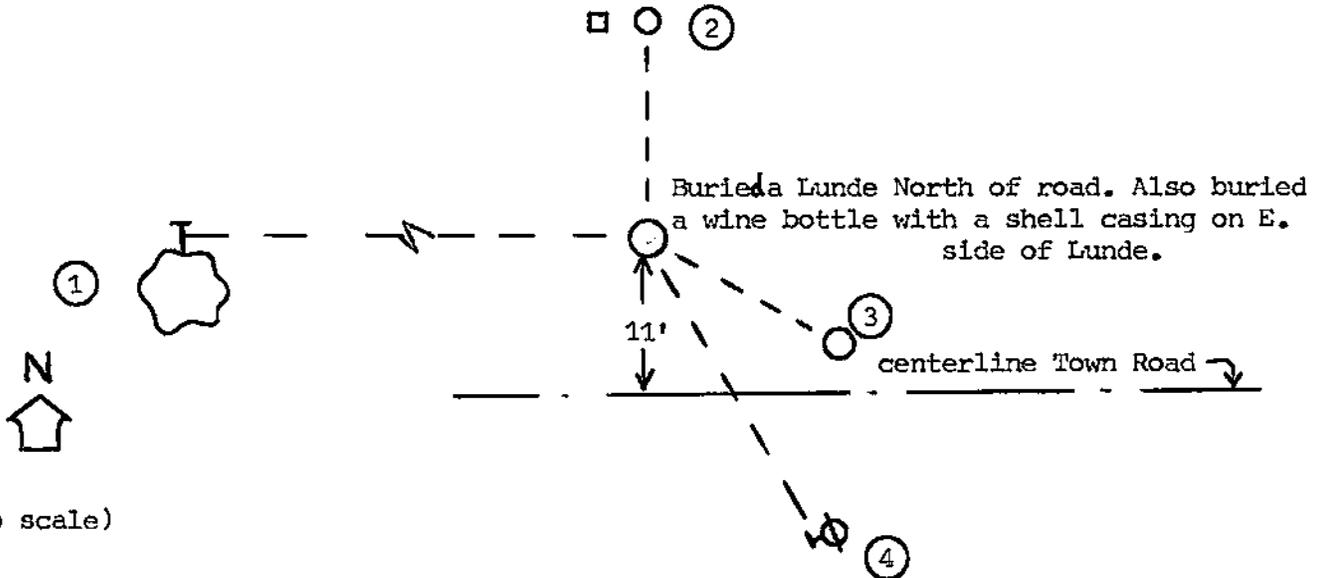


(not to scale)

PLAN VIEW DRAWING OF REFERENCE TIES

MAP SHOWING DISTANCE AND DIRECTION TO OTHER PUBLIC LAND SURVEY CORNERS USED FOR REESTABLISHING THE CORNER

(not to scale)

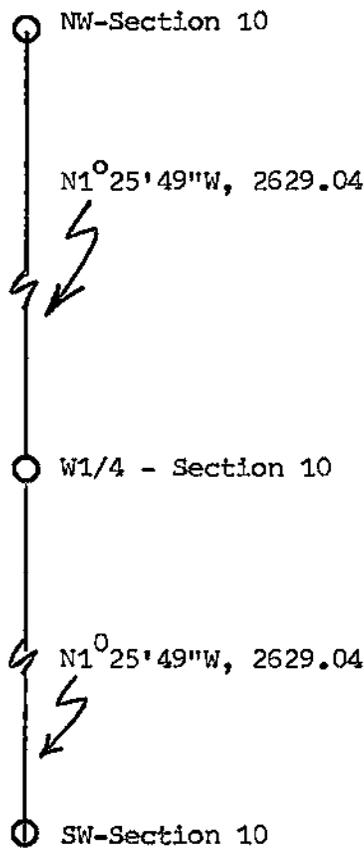

I, William C. Jung, Deputy County Surveyor,
 HEREBY CERTIFY THAT THE CORNER LOCATION SHOWN ON THIS RECORD
 WAS DETERMINED BY ME OR UNDER MY DIRECTION AND CONTROL AND
 THAT THIS U. S. PUBLIC LAND SURVEY MONUMENT RECORD IS CORRECT
 AND COMPLETE TO THE BEST OF MY KNOWLEDGE AND BELIEF.

William C. Jung 10/8/92
 Signature Date

Revised: 6/11/02 *W.C.J.*



Seal