


21705100020

U. S. PUBLIC LAND SURVEY MONUMENT RECORD

SECTION 10 T 17 N, R 5 W, TOWN OF BURNS

LA CROSSE COUNTY

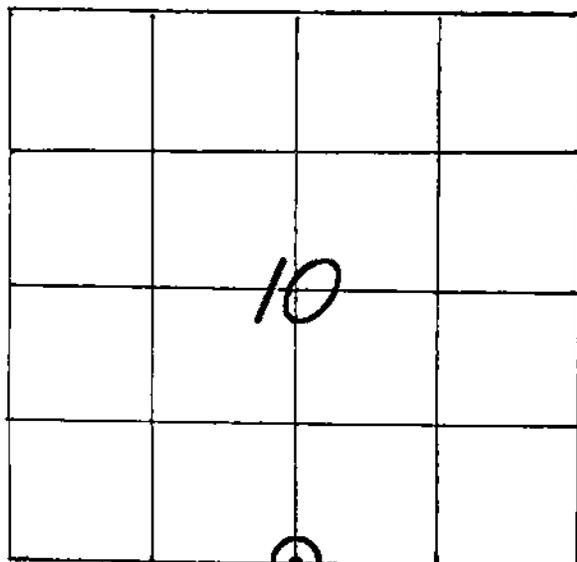

LOCATION OF LANDMARK

CREW: WILLIAM C. JUNG
 PETER F. FOLLANSBEE
 DATE: 4/14/2005

WISCONSIN COORDINATE SYSTEM

North 714,802.211

East 1,715,329.345

Theta Angle

Horiz. Order

Vert. Order

DATUM: 1983('91)

TYPE OF LANDMARK

3/4" x 30" IRON BAR WITH A RED PLASTIC CAP.

BEARINGS ARE REFERENCED TO

GRID NORTH AS PER SECTION DATA.

Describe any record evidence, monument evidence, testimonial evidence or any other material evidence you considered and whether the monument was found or restored through acceptance of an obliterated evidence location.


I accepted the occupied conditions as the best available evidence of the original government corner position and monumented the corner with an iron bar and plastic cap. The iron bar is on line with the fence to the West of the creek and with the fence to the South of the creek. The iron pipe to the South is a survey point that I set years ago. After surveying the South line of Section 10, I feel that this occupied corner fits very well.

Describe or show any material discrepancy between the location of the restored corner and that of the corner previously restored or reestablished.

NONE KNOWN.


RECORD OF DURABLE WITNESS MONUMENTS

NO.	DESCRIPTION	MAGNETIC	
		BEARING	DISTANCE
1	SET A 3/4" x 30" IRON BAR WITH A RED PLASTIC CAP	N 63° E	72.80 FT.
2	SET A 3/4" x 30" IRON BAR WITH A RED PLASTIC CAP	N 81° E	56.92 FT.
3	SET A 3/4" x 30" IRON BAR WITH A RED PLASTIC CAP	S 52° E	54.44 FT.
4	EXISTING LARGE IRON PIPE	S 01° E	33.13 FT.

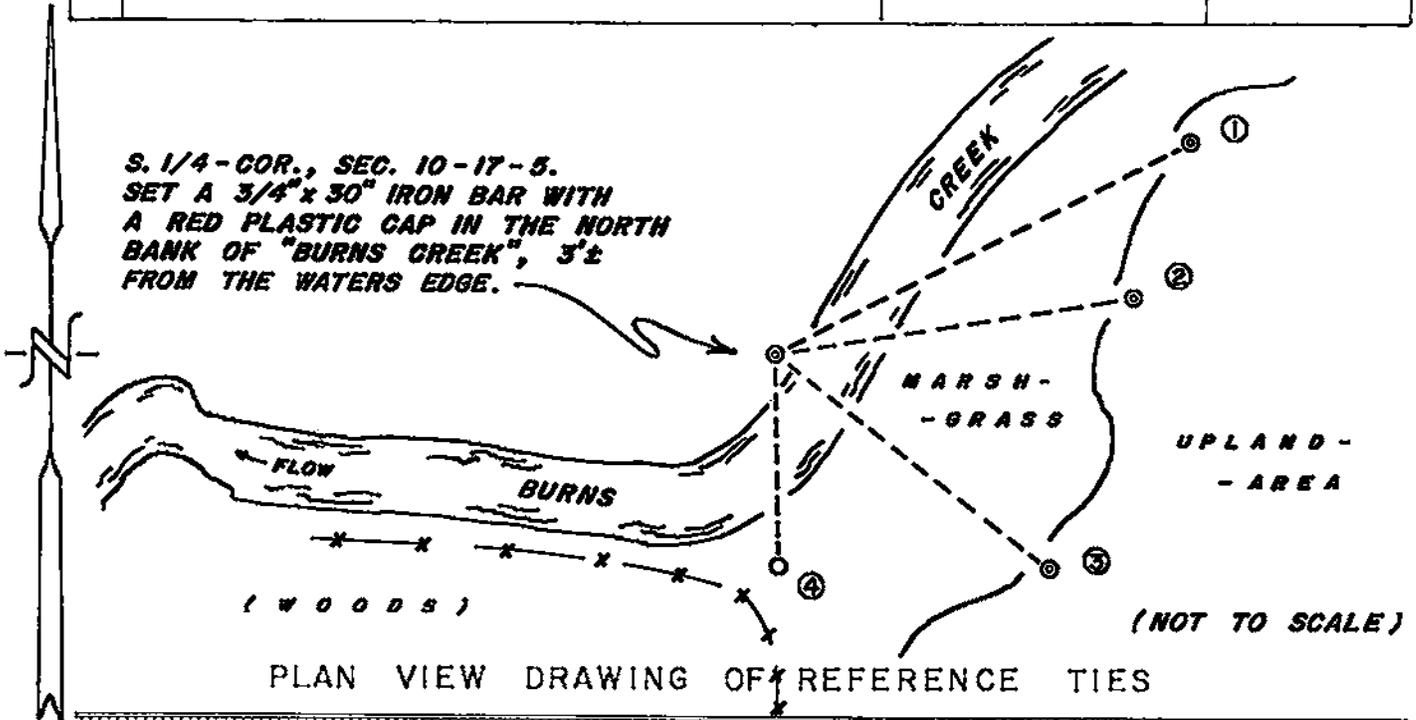

MAP SHOWING DISTANCE AND DIRECTION TO OTHER PUBLIC LAND SURVEY CORNERS USED FOR REESTABLISHING THE CORNER

(GRID BEARINGS AND DISTANCES)
 (GRID FACTOR: 0.999939)
 (NOT TO SCALE)

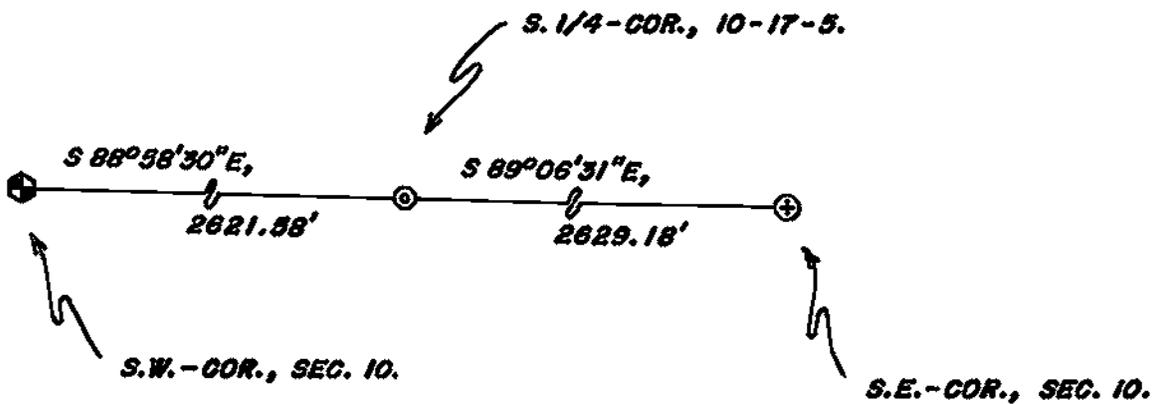

I, WILLIAM G. JUNG, COUNTY SURVEYOR
 HEREBY CERTIFY THAT THE CORNER LOCATION SHOWN ON THIS RECORD
 WAS DETERMINED BY ME OR UNDER MY DIRECTION AND CONTROL AND
 THAT THIS U. S. PUBLIC LAND SURVEY MONUMENT RECORD IS CORRECT
 AND COMPLETE TO THE BEST OF MY KNOWLEDGE AND BELIEF.

William G. Jung
 Signature

7/1/05
 Date



Seal