


21705102000

U. S. PUBLIC LAND SURVEY MONUMENT RECORD

SECTION 10 T 17 N, R 5 W, TOWN OF BURNS
 LA CROSSE COUNTY

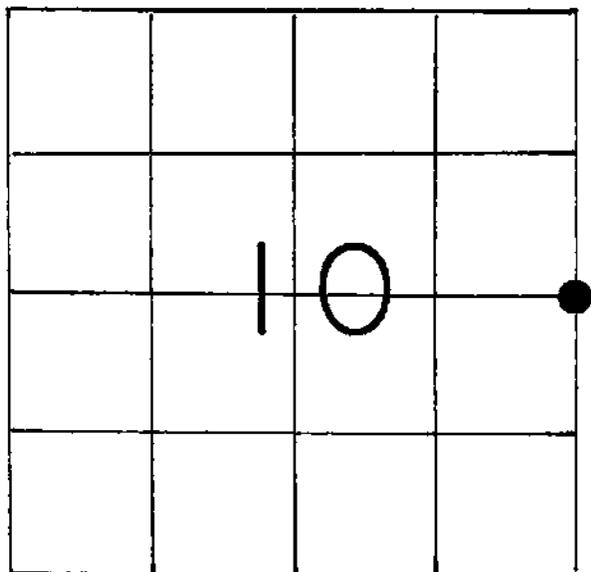

LOCATION OF LANDMARK

Crew: William C. Jung
 Peter F. Follansbee

Date: 9/22/92

WISCONSIN COORDINATE SYSTEM
North
East
Theta Angle
Horiz. Order
Vert. Order
TYPE OF LANDMARK
Brass capped Lunde marker
BEARINGS ARE REFERENCED TO
True (\pm 02')

Describe any record evidence, monument evidence, testimonial evidence or any other material evidence you considered and whether the monument was found or restored through acceptance of an obliterated evidence location.


I found an old East-West tie post where the oldest wire was tied off (this wire had barbs 3" apart). This post fell in my corner search area and was the oldest post in the fence. It was common for farmers at a location like this to tie their wire off at the government corner. Mr. Manke had no knowledge of this. The old landowners to the NW and NE who could have answered questions were both deceased. I rejected the jack oak to the SE as a possible bearing tree. I accepted the old post as the best available evidence of the original government corner position.

A Lunde was set by the post with a sign and post set to the NW and a bottle w/shell casing buried by the Lunde. The post is of course not the original but I believe it to be in the original location. Describe or show any material discrepancy between the location of the restored corner and that of the corner previously restored or reestablished.

None known.

RECORD OF DURABLE WITNESS MONUMENTS

NO	DESCRIPTION	BEARING	DISTANCE
1	Set iron pipe on South side of oak tree	True = $S87^{\circ}11'53''W$	49.73
2	P.K. nail in double blazed 4 1/2" oak	-----	5.97
3	P.K. nail in single blazed 21" jack oak	-----	46.88
4	P.K. nail in double blazed 13" jack pine	-----	32.28

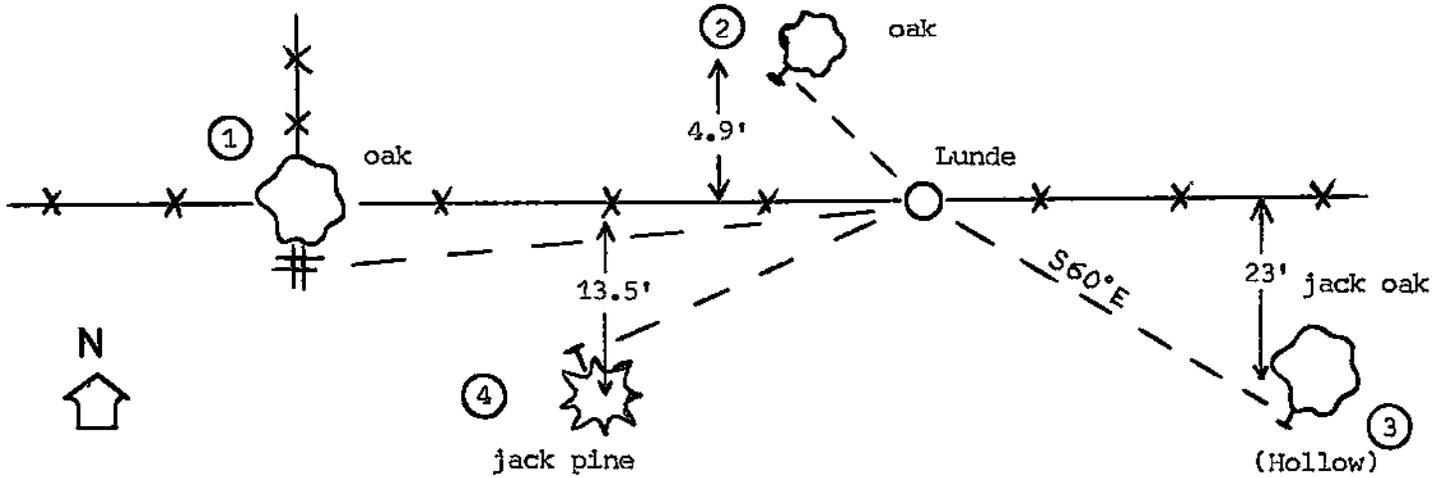


(not to scale)

PLAN VIEW DRAWING OF REFERENCE TIES


MAP SHOWING DISTANCE AND DIRECTION TO OTHER PUBLIC LAND SURVEY CORNERS USED FOR REESTABLISHING THE CORNER

(not to scale)

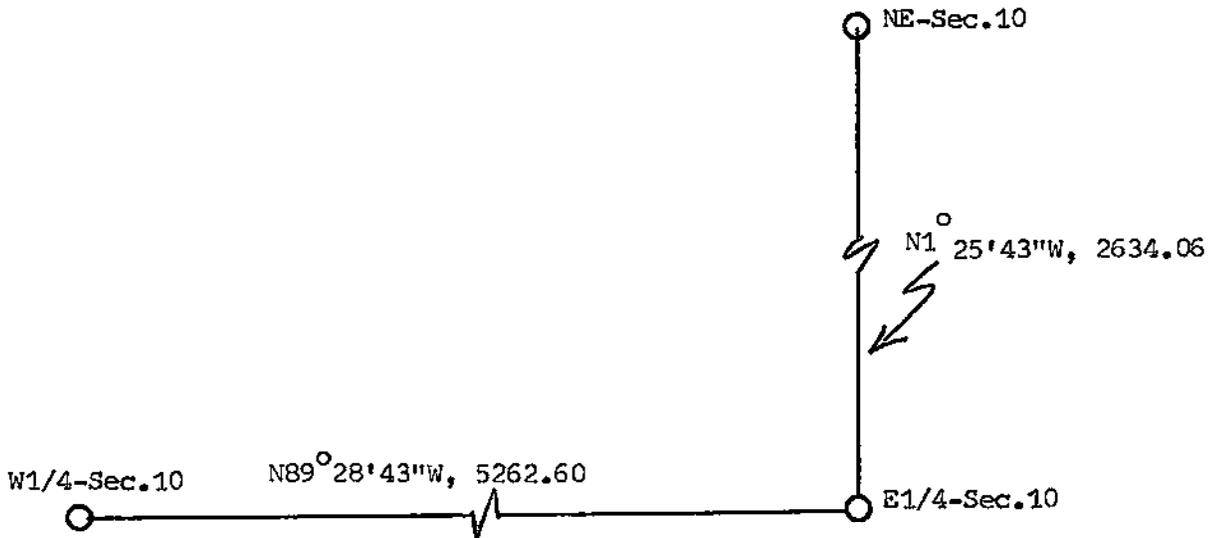

I, William C. Jung, Deputy County Surveyor,
 HEREBY CERTIFY THAT THE CORNER LOCATION SHOWN ON THIS RECORD
 WAS DETERMINED BY ME OR UNDER MY DIRECTION AND CONTROL AND
 THAT THIS U. S. PUBLIC LAND SURVEY MONUMENT RECORD IS CORRECT
 AND COMPLETE TO THE BEST OF MY KNOWLEDGE AND BELIEF.

William C. Jung 10/8/92
 Signature Date

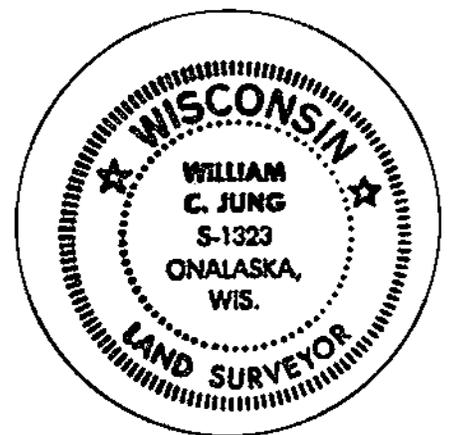

Seal