


21705110020

U. S. PUBLIC LAND SURVEY MONUMENT RECORD

SECTION 14 T 17 N, R 5 W, TOWN OF BURNS  
LA CROSSE COUNTY

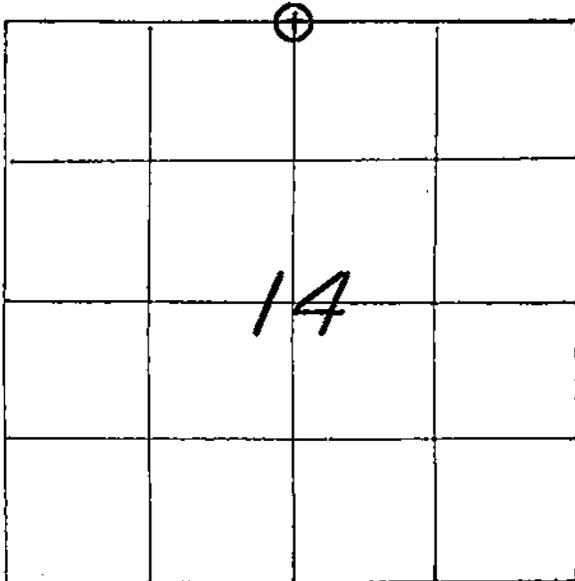

WISCONSIN COORDINATE SYSTEM
North
East
Theta Angle
Horiz. Order
Vert. Order
TYPE OF LANDMARK
<i>3/4" x 30" IRON BAR WITH AN ALUMINUM CAP.</i>
BEARINGS ARE REFERENCED TO
<i>GRID NORTH AS PER SECTION DATA.</i>

LOCATION OF LANDMARK

CREW: WILLIAM C. JUNG  
PETER F. FOLLANSBEE  
DATE: 9/09/1999

Describe any record evidence, monument evidence, testimonial evidence or any other material evidence you considered and whether the monument was found or restored through acceptance of an obliterated evidence location.

I found old tie posts at the occupied corner. The West tie post is an old steel 1<sup>5</sup>/<sub>8</sub>" round shaft. It appears to be a machinery part. The East tie post is a railroad tie post that appears to have replaced an old wood post found between the two tie posts being used. What I found is typical of what one would expect to find at an old government corner location where landowners would share fencing and use the corner as a starting point. It fits the sections very well. I accepted \*\*


Describe or show any material discrepancy between the location of the restored corner and that of the corner previously restored or reestablished.

None known.


\*\* this location as evidence of the original government corner location and monumented it with an iron bar with a cap.

RECORD OF DURABLE WITNESS MONUMENTS

NO	DESCRIPTION	BEARING	DISTANCE
1	SET A NAIL IN S.E.-SIDE OF A 12" HICKORY	S.'WESTERLY ±	37.15 FT.
2	SET A NAIL IN S.E.-SIDE OF A 16" HICKORY	S.'WESTERLY ±	23.97 FT.
3	SET A NAIL IN S.W.-SIDE OF A 15" HICKORY	S.'EASTERLY ±	47.71 FT.
4	SET A P.K. NAIL IN S.W.-SIDE OF A 17" HICKORY	S.'EASTERLY ±	25.47 FT.

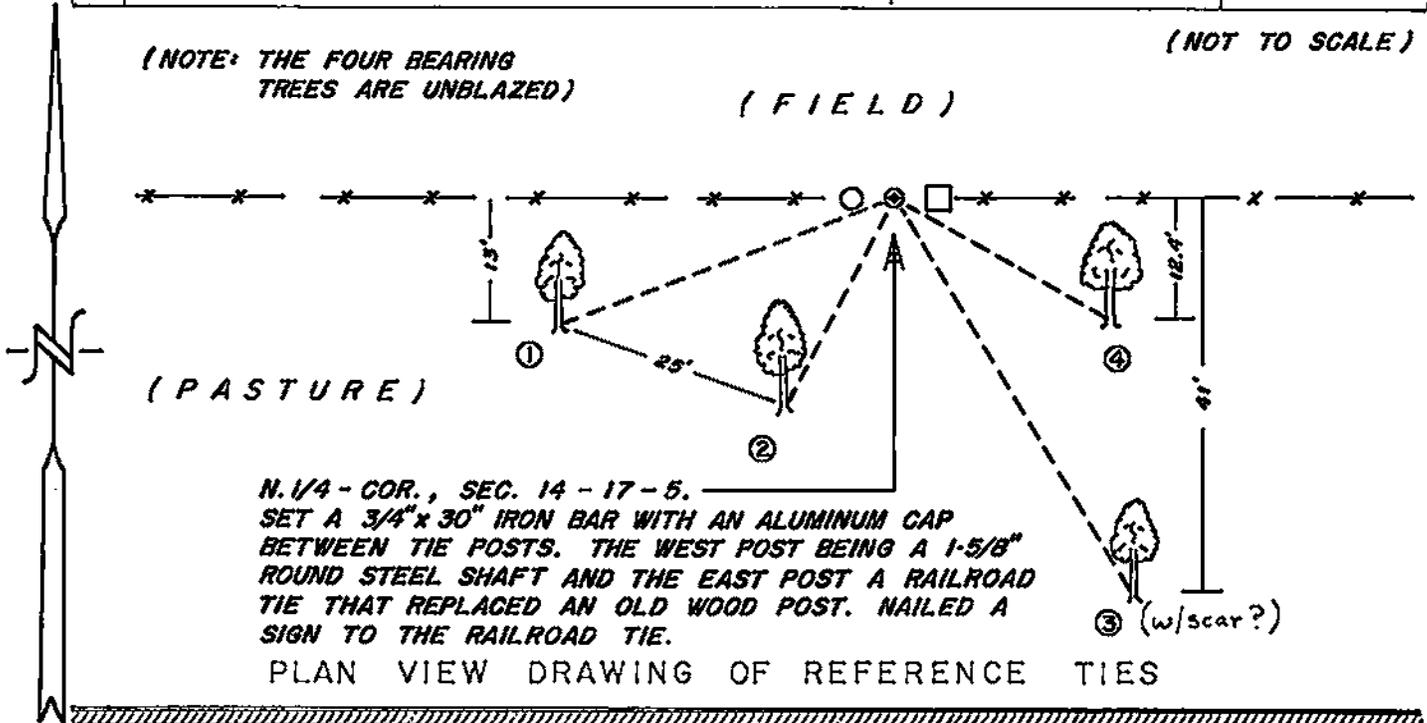


MAP SHOWING DISTANCE AND DIRECTION TO OTHER PUBLIC LAND SURVEY CORNERS USED FOR REESTABLISHING THE CORNER

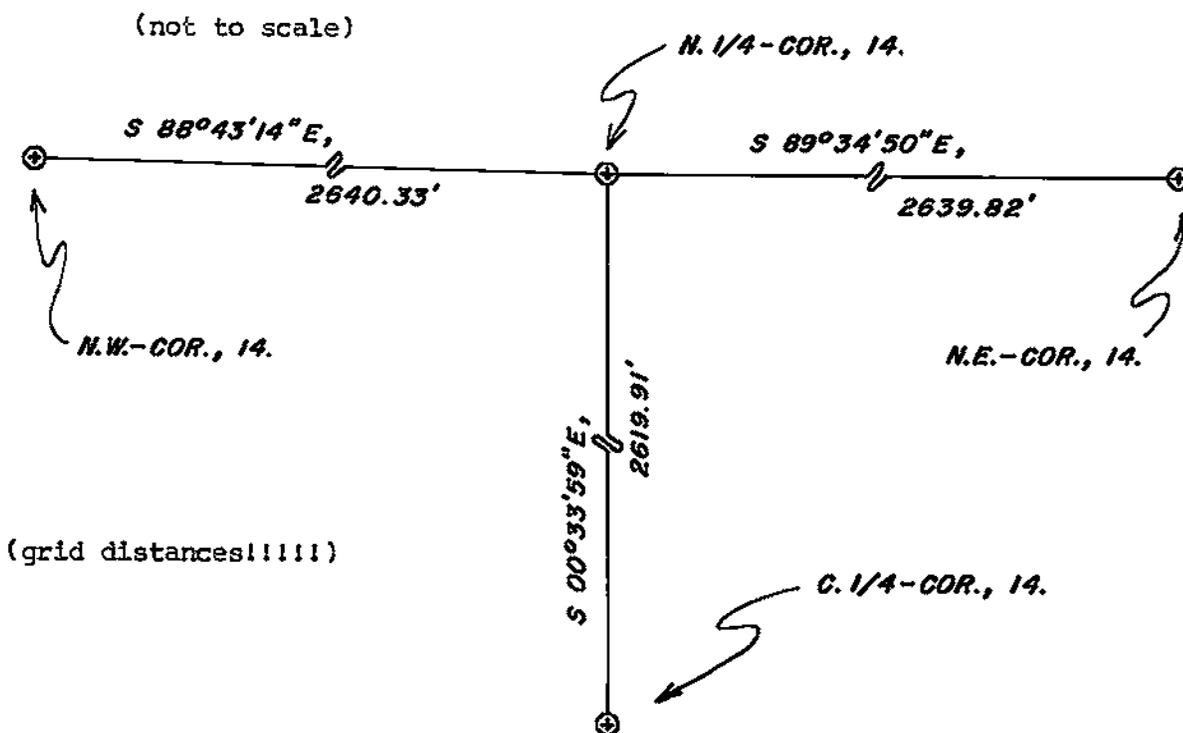

I, WILLIAM C. JUNG, COUNTY SURVEYOR  
 HEREBY CERTIFY THAT THE CORNER LOCATION SHOWN ON THIS RECORD WAS DETERMINED BY ME OR UNDER MY DIRECTION AND CONTROL AND THAT THIS U. S. PUBLIC LAND SURVEY MONUMENT RECORD IS CORRECT AND COMPLETE TO THE BEST OF MY KNOWLEDGE AND BELIEF.

William C. Jung  
 Signature

9/28/99  
 Date

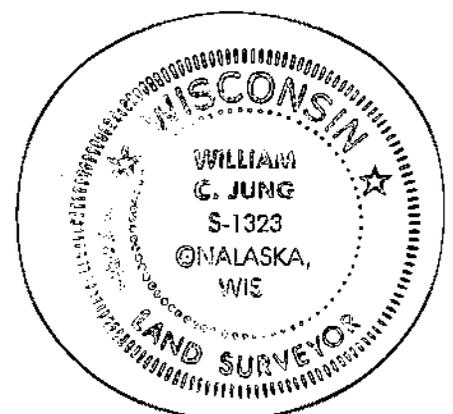

Seal