


21705112000

U. S. PUBLIC LAND SURVEY MONUMENT RECORD

SECTION 11 T 17 N, R 5 W, TOWN OF BURNS

LA CROSSE COUNTY

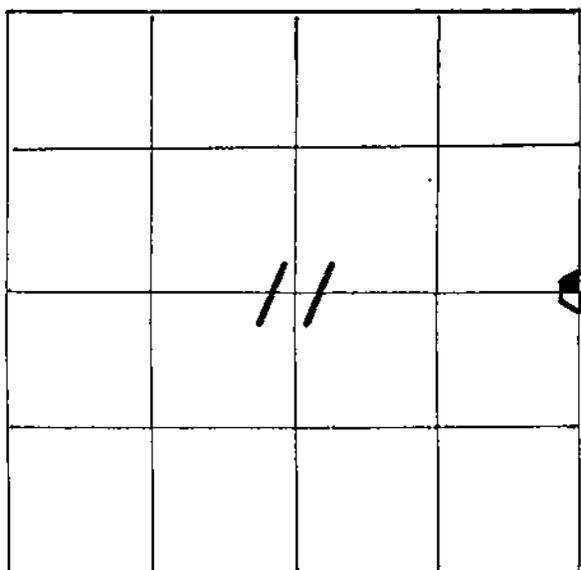

LOCATION OF LANDMARK

CREW: WILLIAM G. JUNG

PETER F. FOLLANSBEE

DATE: 9/08/1999

WISCONSIN COORDINATE SYSTEM

North

East

Theta Angle

Horiz. Order

Vert. Order

TYPE OF LANDMARK

BRASS CAP LUNDE MARKER.

BEARINGS ARE REFERENCED TO

Grid

Describe any record evidence, monument evidence, testimonial evidence or any other material evidence you considered and whether the monument was found or restored through acceptance of an obliterated evidence location.


I accepted the existing North-South fence as evidence of the original section line run and set the corner equidistant between the section corners and in the fence. A brass capped Lunde marker was set at the corner.

Describe or show any material discrepancy between the location of the restored corner and that of the corner previously restored or reestablished.


None known.

RECORD OF DURABLE WITNESS MONUMENTS

NO	DESCRIPTION	BEARING	DISTANCE
1	SET A 1/2" REBAR 4"s WEST OF THE FENCE	NORTH ±	55.88 FT.
2	SET A NAIL IN N.W.-SIDE OF A DOUBLE APPLE TREE	N.'EASTERLY ±	27.37 FT.
3	SET A NAIL IN N.E.-SIDE DOUBLE BOX ELDER	S.'EASTERLY ±	5.60 FT.
4	SET A NAIL IN W.-SIDE OF AN APPLE TREE	S.'EASTERLY ±	35.95 FT.

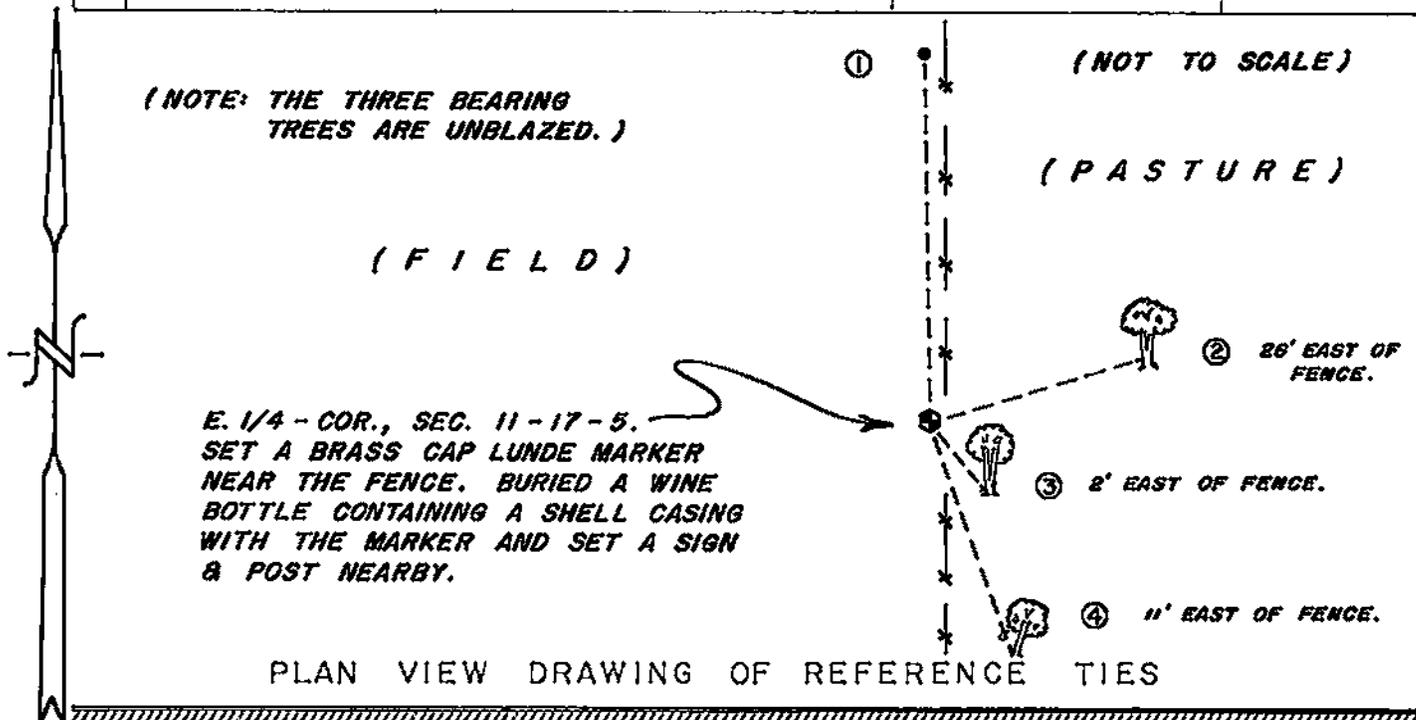


MAP SHOWING DISTANCE AND DIRECTION TO OTHER PUBLIC LAND SURVEY CORNERS USED FOR REESTABLISHING THE CORNER

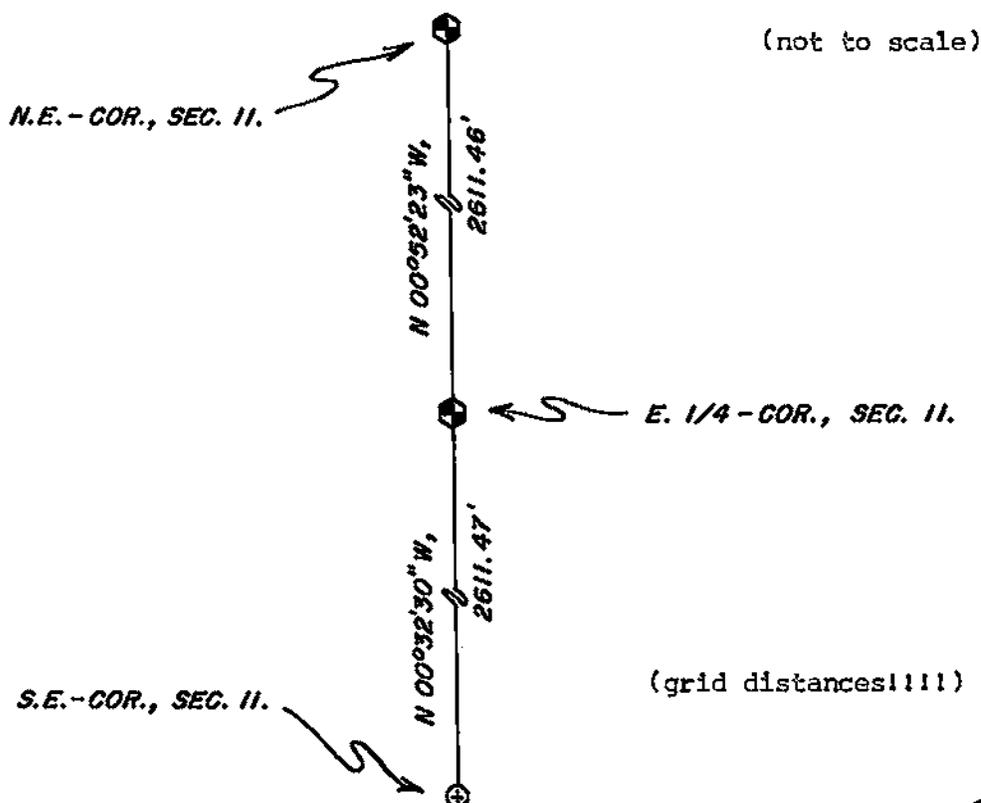

I, WILLIAM C. JUNG, COUNTY SURVEYOR
 HEREBY CERTIFY THAT THE CORNER LOCATION SHOWN ON THIS RECORD WAS DETERMINED BY ME OR UNDER MY DIRECTION AND CONTROL AND THAT THIS U. S. PUBLIC LAND SURVEY MONUMENT RECORD IS CORRECT AND COMPLETE TO THE BEST OF MY KNOWLEDGE AND BELIEF.

William C. Jung 10/1/99
 Signature Date

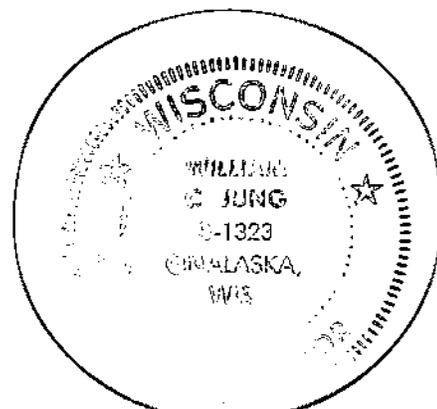

Seal