

CERTIFICATE

CERTIFIED LAND CORNER

I, Harley A. Sime, do hereby certify that on the 25 day of April 1975, I found ~~evidence~~ (no evidence) of the S.W. corner of Section 7, T.17 N, R. 4W, Fourth Principal Meridian, and I re-established said corner according to the Wisconsin Statutes as shown and described hereon.

History of original corner establishment:

Description of corner evidence found:

Accepted the occupied fence corner as the best available evidence. Said corner fits the West line of the Township.

Dated this 19 day of Jan. 1976.

Harley A. Sime
County Surveyor

Description of corner and witness monuments, references and accessories used to perpetuate the original or re-established location of this corner:

Set a Harrison marker at the fence corner, ~~up 5"~~ = 3/4" Iron Bar Set up 5".

Witnesses to corner location:






W.C. Jung - Crew Chief

Harr. up 5"

A. Luack

D. Malliet

33.00'
377'
36" Elm
n&c in blazed

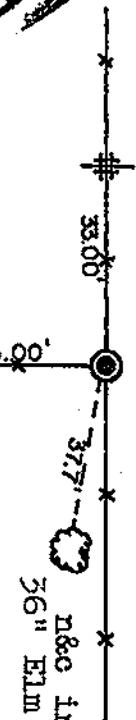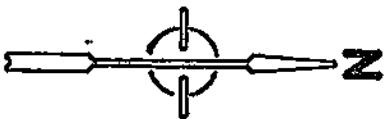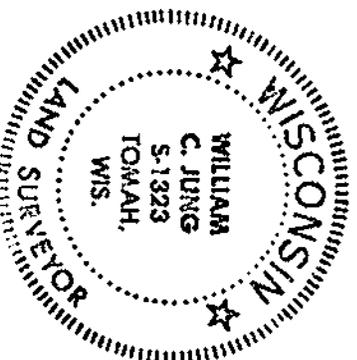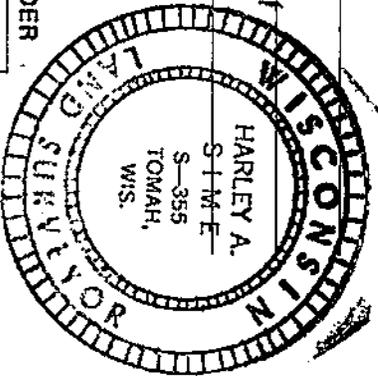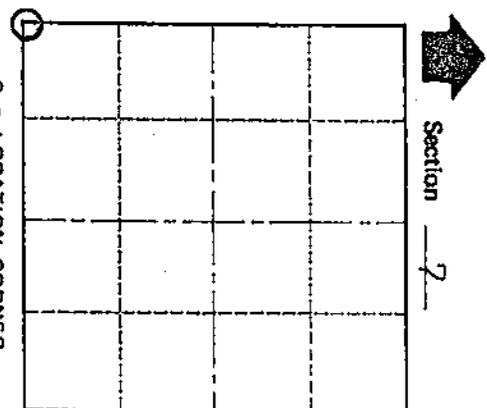

SURVEY CONTROL ORDER

Horizontal

Vertical

WISCONSIN COORDINATE SYSTEM

Control Sta. Name	East (X)	North (Y)	Elevation (Z)	Zone
Corner				

City, Village or Town Sparta

County of Monroe