

CERTIFICATE

CERTIFIED LAND CORNER

I, Harley A. Sime, do hereby certify that on the 25 day of April, 19 75, I found ~~evidence~~ (no evidence) of the N 8 corner of Section 7, T 17 N, R 4W, Fourth Principal Meridian, and I re-established said corner according to the Wisconsin Statutes as shown and described hereon.


Dated this 15 day of Jan, 19 76.

Harley A. Sime
County Surveyor
Title

History of original corner establishment:

Description of corner evidence found:

Set the corner proportionately between the section corners. While digging the hole for the Harrison, we found very old pieces of wire going East and West, and South, down in the hole.

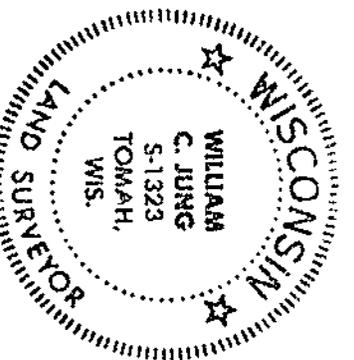




Description of corner and witness monuments, references and accessories used to perpetuate the original or re-established location of this corner:
Set a Harrison marker, down 3" in the driveway. Buried rocks around it.

Witnesses to corner location:

W.C. Jung - Crew Chief *W.C. Jung*

D. Malliet

A. Ineck

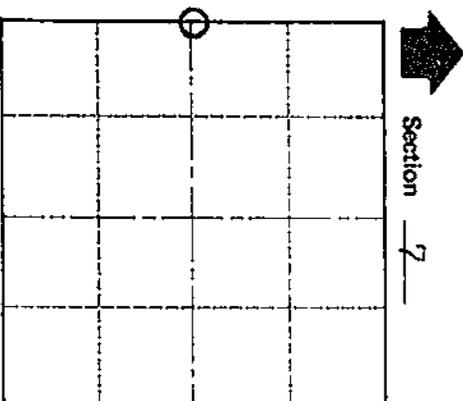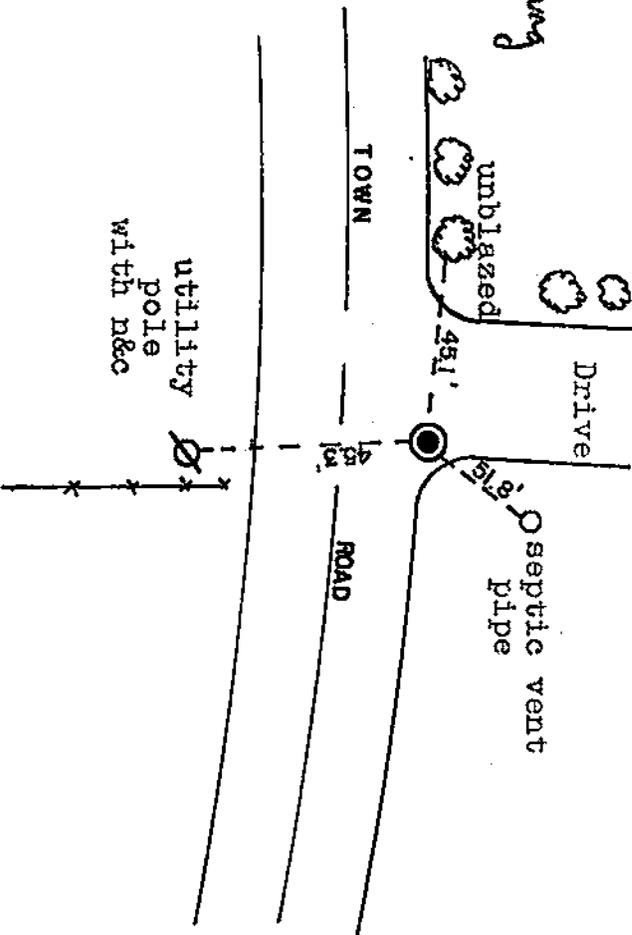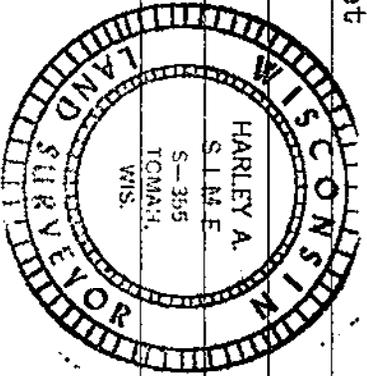

SURVEY CONTROL ORDER

Horizontal

Vertical

East (X)

North (Y)

Elevation (Z)

Zone

Corner

Control Sta. Name

WISCONSIN COORDINATE SYSTEM

City, Village or Town Sparta

County of Monroe