


21705130000

U. S. PUBLIC LAND SURVEY MONUMENT RECORD

SECTION 13 T 17 N, R 5 W, TOWN OF Burns

LA CROSSE COUNTY

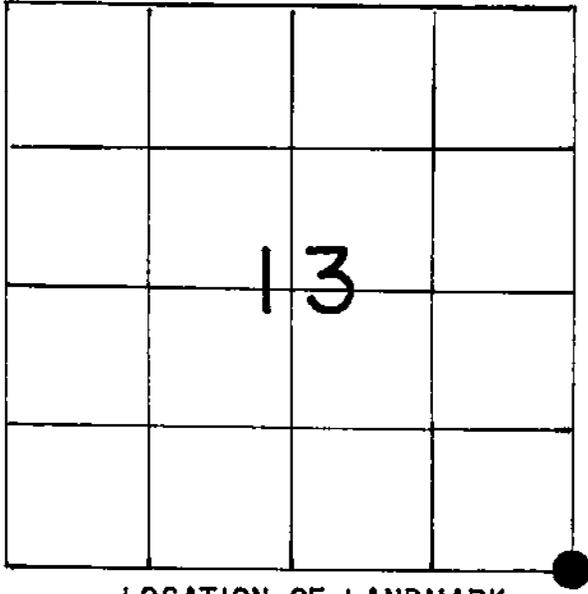

LOCATION OF LANDMARK

Crew: William C. Jung

Date: 9/23/89

Describe any record evidence, monument evidence, testimonial evidence or any other material evidence you considered and whether the monument was found or restored through acceptance of an obliterated evidence location.

I found a Harrison marker at the corner which Doug Malliet and I set in April of 1975. The North-South fence was gone as was the iron bar to the South. The marker was in good condition and has been used in other surveys since we set it in 1975.

Describe or show any material discrepancy between the location of the restored corner and that of the corner previously restored or reestablished.

None known.

WISCONSIN COORDINATE SYSTEM

North

East

Theta Angle

Horiz. Order

Vert. Order

TYPE OF LANDMARK


Harrison marker

BEARINGS ARE REFERENCED TO

True

RECORD OF DURABLE WITNESS MONUMENTS


NO	DESCRIPTION	BEARING	DISTANCE
1	Nail and cap in power pole	Magnetic =N10°W	Rec.=572.45'
2	Existing 3/4" round iron bar	West ±	11.95'
3	Survey marker warning sign and post	East±	1.3'
4			

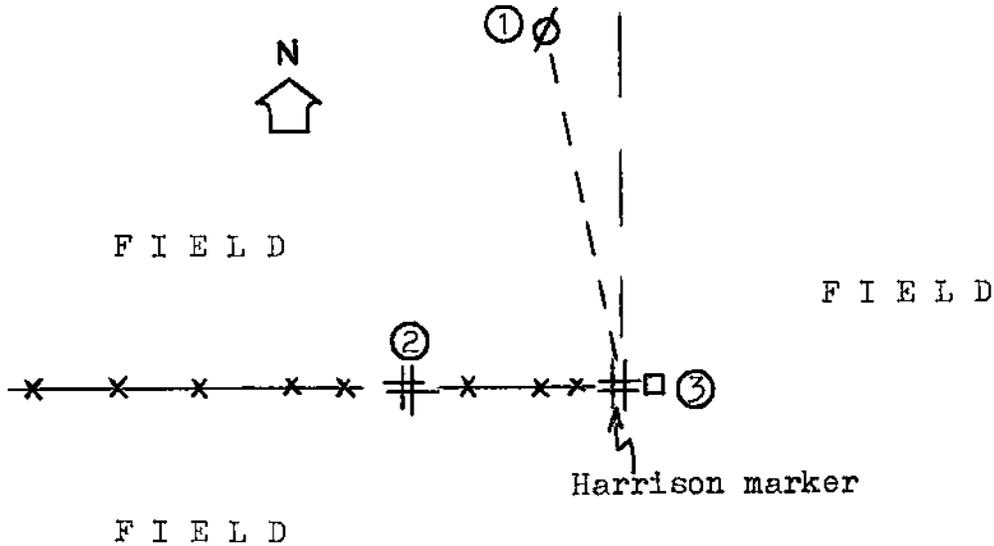

PLAN VIEW DRAWING OF REFERENCE TIES

MAP SHOWING DISTANCE AND DIRECTION TO OTHER PUBLIC LAND SURVEY CORNERS USED FOR REESTABLISHING THE CORNER


(not to scale)

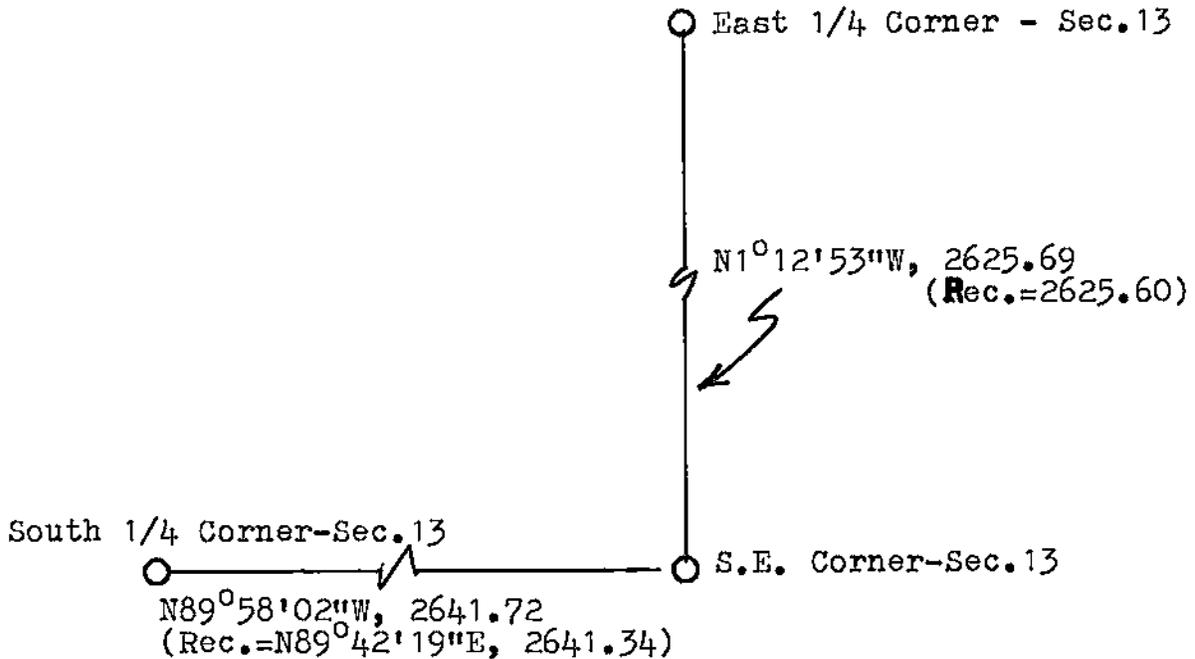

I, William C. Jung
 HEREBY CERTIFY THAT THE CORNER LOCATION SHOWN ON THIS RECORD
 WAS DETERMINED BY ME OR UNDER MY DIRECTION AND CONTROL AND
 THAT THIS U. S. PUBLIC LAND SURVEY MONUMENT RECORD IS CORRECT
 AND COMPLETE TO THE BEST OF MY KNOWLEDGE AND BELIEF.

William C. Jung
 Signature

October 17, 1989
 Date

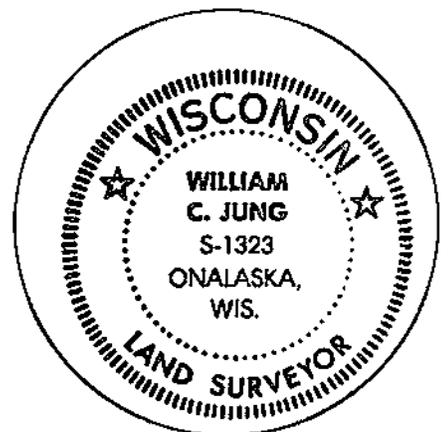

Seal

CERTIFICATE

CERTIFIED LAND CORNER

No. 774

I, Harley A. Sime, do hereby certify that on the 25 day of April 1975, I found ~~(evidence)~~ (no evidence) of the S.W. corner of Section 18, T.17 N., R. 4W. Fourth Principal Meridian, and I re-established said corner according to the Wisconsin Statutes as shown and described hereon.

Dated this 22 day of Jan. 1976.

 County Surveyor W.M.

History of original corner establishment:

Description of corner evidence found:






Accepted the occupied fence corner as the best available evidence. Said corner fits the West line of the Township and the South line of Section 18. The occupied section corners and the occupied $\frac{1}{4}$ corner on the South line of Section 18 are all on line and the occupied distance is within 5.6 ft. of the record distance.

Description of corner and witness monuments, references and accessories used to perpetuate the original or re-established location of this corner:
 Set a Harrison marker, up 2".

Witnesses to corner location:

W.C. Jung - Crew Chief *W.C. Jung*
D. Walllet
A. Ineck

N&G in Pole

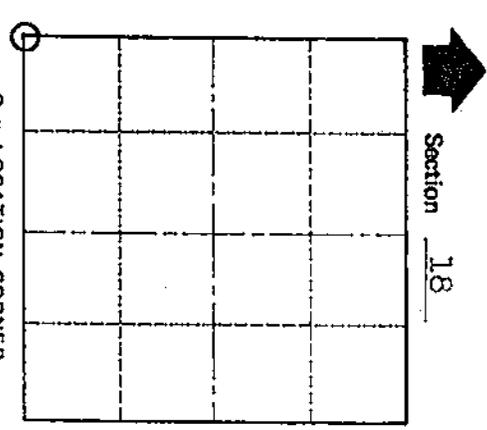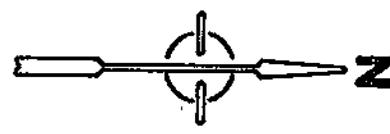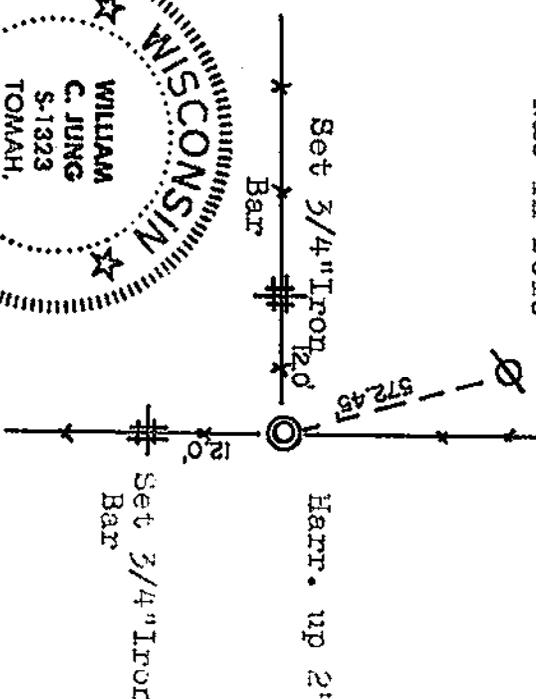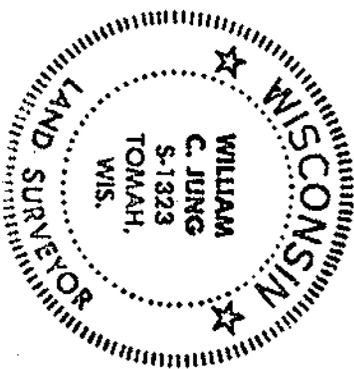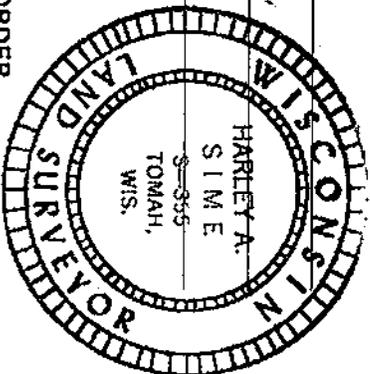

SURVEY CONTROL ORDER

Horizontal	Vertical	East (X)	North (Y)	Elevation (Z)	Zone
Corner	Control Sta. Name	WISCONSIN COORDINATE SYSTEM			

City, Village or Town Sparta
 County of Monroe