


21705130020

U. S. PUBLIC LAND SURVEY MONUMENT RECORD

SECTION 13 T 17 N, R 5 W, TOWN OF Burns

LA CROSSE COUNTY

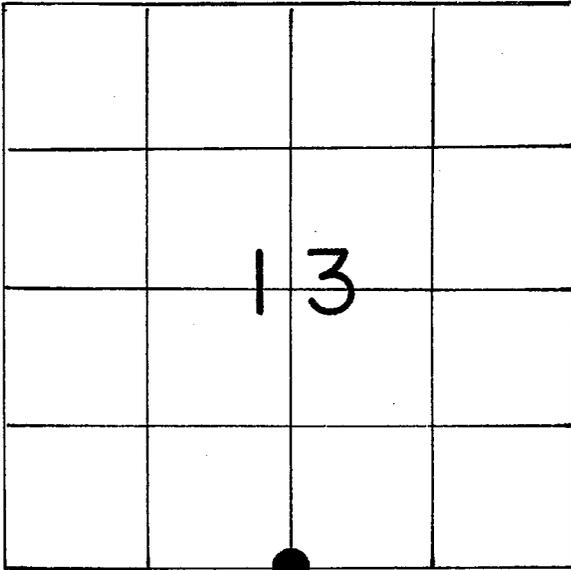

LOCATION OF LANDMARK

Crew: William C. Jung

Date: 9/27/89

Describe any record evidence, monument evidence, testimonial evidence or any other material evidence you considered and whether the monument was found or restored through acceptance of an obliterated evidence location.

I found an existing iron pipe at the occupied fence corner and accepted it as the best available evidence of the original government corner position.

Describe or show any material discrepancy between the location of the restored corner and that of the corner previously restored or reestablished.

None known.

WISCONSIN COORDINATE SYSTEM

North

East

Theta Angle

Horiz. Order

Vert. Order

TYPE OF LANDMARK

1 $\frac{1}{4}$ " iron pipe

BEARINGS ARE REFERENCED TO

True

