


21705132000

U. S. PUBLIC LAND SURVEY MONUMENT RECORD

SECTION 13 T 17 N, R 5 W, TOWN OF BURNS
 LA CROSSE COUNTY

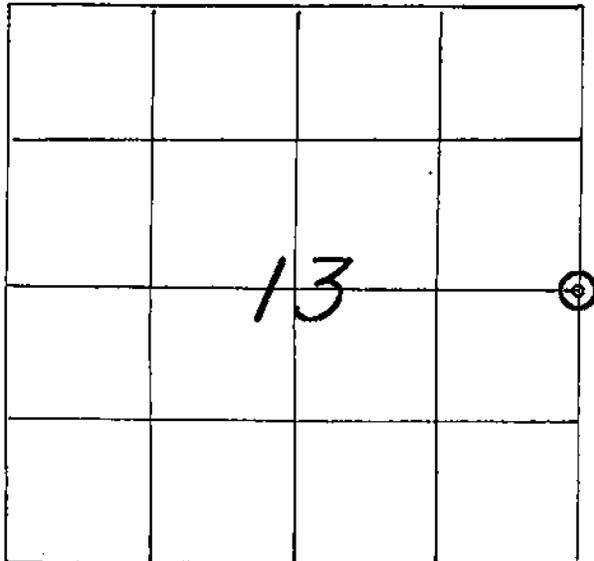

LOCATION OF LANDMARK

CREW: WILLIAM C. JUNG
 PETER F. FOLLANSBEE
 DATE: 11/09/1999

WISCONSIN COORDINATE SYSTEM	
North	712,000.802
East	1,728,501.868
Theta Angle	
Horiz. Order	
Vert. Order	
DATUM:	83 ('91)
TYPE OF LANDMARK	
ROUND-HEAD BOLT OVER EX. HARRISON.	
BEARINGS ARE REFERENCED TO	
GRID NORTH AS PER SECTION DATA.	

Describe any record evidence, monument evidence, testimonial evidence or any other material evidence you considered and whether the monument was found or restored through acceptance of an obliterated evidence location.


My P.K. nail from 1989 was gone. We set a bolt over the existing Harrison marker.

Describe or show any material discrepancy between the location of the restored corner and that of the corner previously restored or reestablished.

NONE KNOWN.

RECORD OF DURABLE WITNESS MONUMENTS


NO	DESCRIPTION	BEARING	DISTANCE
1	EXISTING NAIL & CAP IN THE FACE OF A POWER POLE	S.'EASTERLY ±	76.21 FT.
2	CENTER OF A STEEL STOP SIGN POST AT GROUND	S.'WESTERLY ±	21.36 FT.
3	SET A 1-3/8" x 26" IRON PIPE UNDER FENCE, 3' E. OF POST	N.'WESTERLY ±	52.70 FT.
4	EXISTING IRON PIPE BY A SURVEY MARKER SIGN & POST	NORTH ±	25.36 FT.

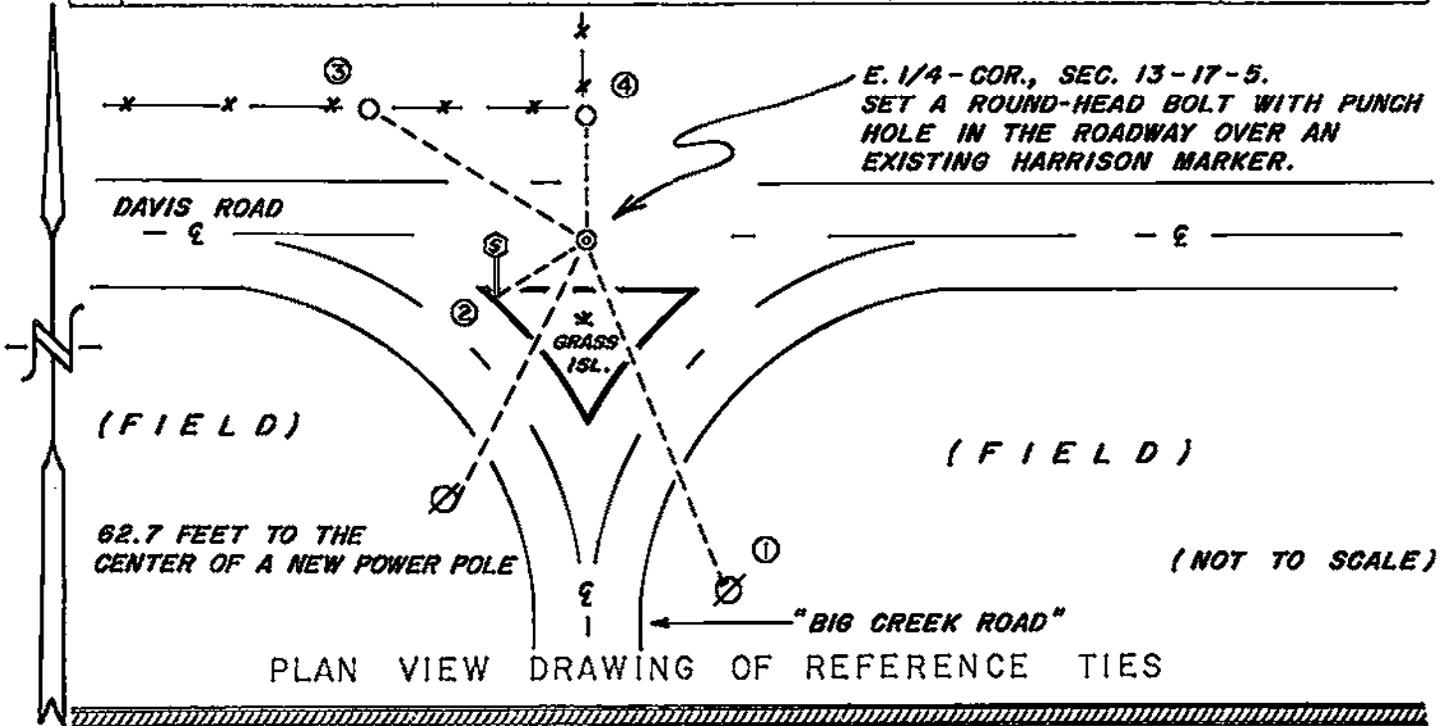

MAP SHOWING DISTANCE AND DIRECTION TO OTHER PUBLIC LAND SURVEY CORNERS USED FOR REESTABLISHING THE CORNER


(not to scale)

(NOTE: GRID BEARING AND DISTANCE)

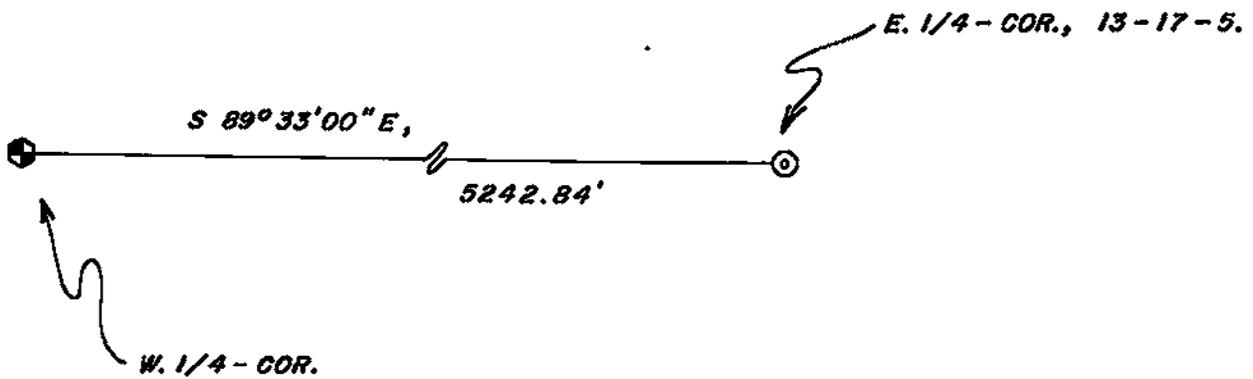

I, WILLIAM C. JUNG, COUNTY SURVEYOR
HEREBY CERTIFY THAT THE CORNER LOCATION SHOWN ON THIS RECORD WAS DETERMINED BY ME OR UNDER MY DIRECTION AND CONTROL AND THAT THIS U. S. PUBLIC LAND SURVEY MONUMENT RECORD IS CORRECT AND COMPLETE TO THE BEST OF MY KNOWLEDGE AND BELIEF.


William C. Jung 12/6/99
Signature Date

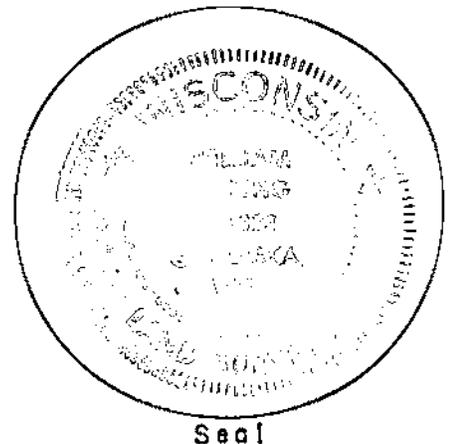

U. S. PUBLIC LAND SURVEY MONUMENT RECORD

SECTION 13 T 17 N, R 5 W, TOWN OF Burns

LA CROSSE COUNTY

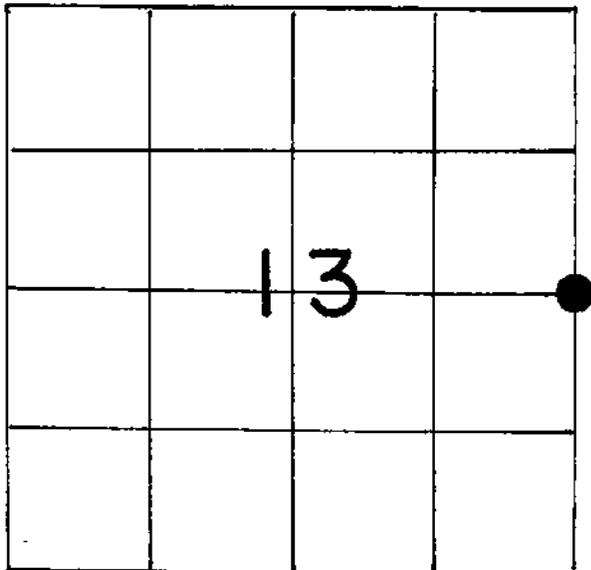

LOCATION OF LANDMARK

Crew: William C. Jung

Date: 10/6/89

WISCONSIN COORDINATE SYSTEM

North

East

Theta Angle

Horiz. Order

Vert. Order

TYPE OF LANDMARK

P.K. nail over Harrison marker

BEARINGS ARE REFERENCED TO

True

Describe any record evidence, monument evidence, testimonial evidence or any other material evidence you considered and whether the monument was found or restored through acceptance of an obliterated evidence location.


I set a P.K. nail over a Harrison marker. The road had been paved again since Malliet and I had been here in April of 1975. The asphalt was too hard to dig in. However, I could hear the marker below with my metal detector. The fence corner to the North was leaning North so that the tie was no longer any good. The utility pole to the Northeast was gone.

Describe or show any material discrepancy between the location of the restored corner and that of the corner previously restored or reestablished.

None known.

RECORD OF DURABLE WITNESS MONUMENTS


NO	DESCRIPTION	BEARING	DISTANCE
1	Set 1 3/4" x 32" iron pipe	North±	25.40'
2	To center of street sign post	Magnetic=S46°W	20.97'
3	To nail and cap in utility pole	" =S45°W	58.10'
4	" " " " " " "	" =S21°E	76.23'

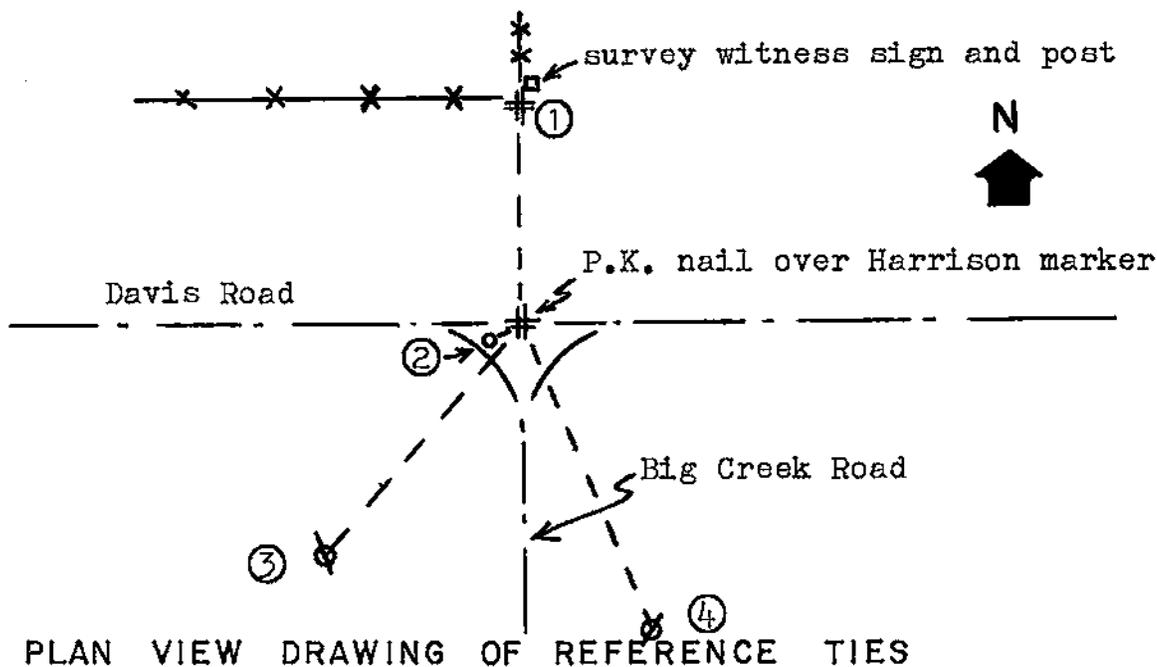

PLAN VIEW DRAWING OF REFERENCE TIES

MAP SHOWING DISTANCE AND DIRECTION TO OTHER PUBLIC LAND SURVEY CORNERS USED FOR REESTABLISHING THE CORNER


(not to scale)

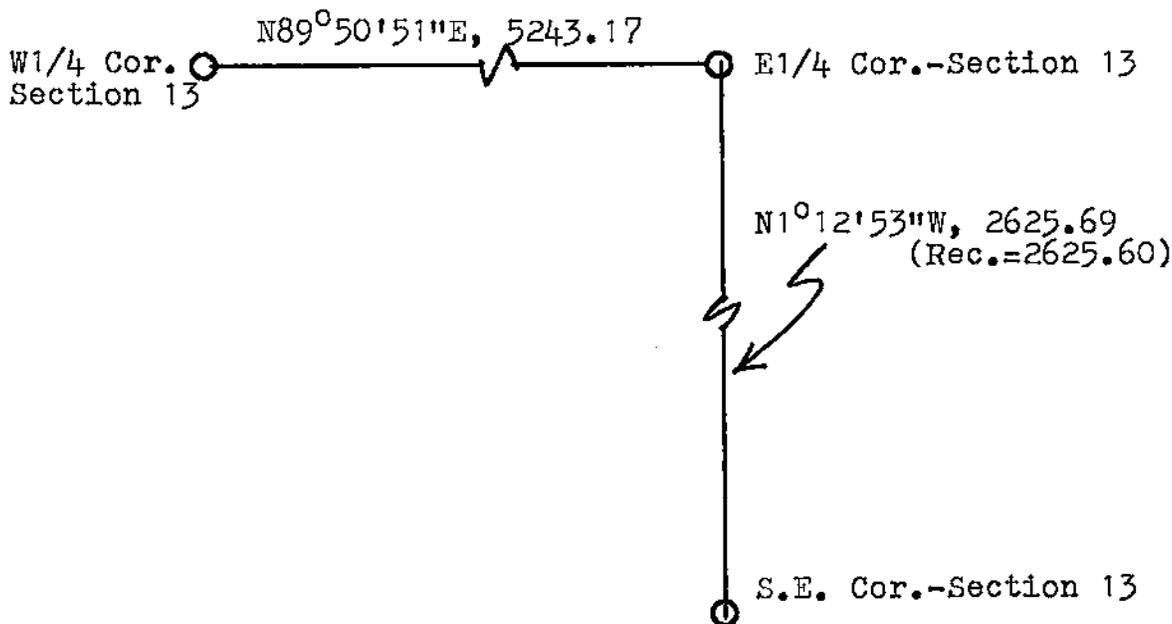

I, William C. Jung
 HEREBY CERTIFY THAT THE CORNER LOCATION SHOWN ON THIS RECORD
 WAS DETERMINED BY ME OR UNDER MY DIRECTION AND CONTROL AND
 THAT THIS U. S. PUBLIC LAND SURVEY MONUMENT RECORD IS CORRECT
 AND COMPLETE TO THE BEST OF MY KNOWLEDGE AND BELIEF.

William C. Jung
 Signature

October 17, 1989
 Date

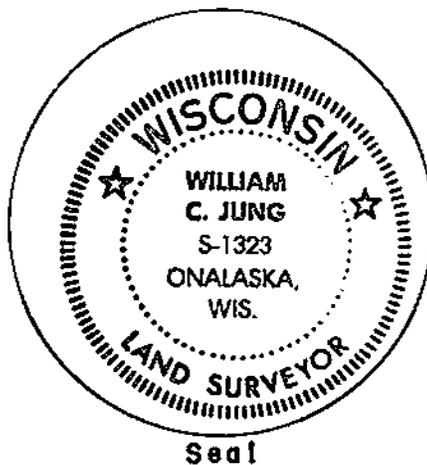

CERTIFICATE

CERTIFIED LAND CORNER

No. 54

History of original corner establishment:

I, Harley A. Sime, do hereby certify that on the 25 day of April, 1925, I found ~~(evidence)~~ (no evidence) of the W 1/4 corner of Section 18, T. 17 N., R. 4W., Fourth Principal Meridian, and I re-established said corner according to the Wisconsin Statutes as shown and described hereon.

Dated this 29 day of Feb., 1926.


 County Surveyor

Description of corner evidence found:

Set the corner proportionately between the section corners.

Description of corner and witness monuments, references and accessories used to perpetuate the original or re-established location of this corner:






Set a Harrison marker in the road, down 1".

Witnesses to corner location:

W.C. Jung - Crew Chief 

A. Ineck

D. Mallett

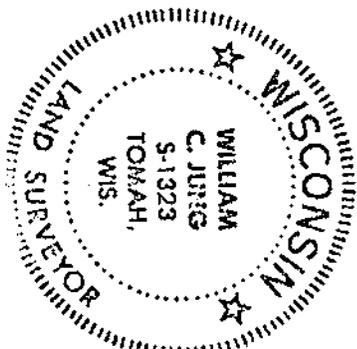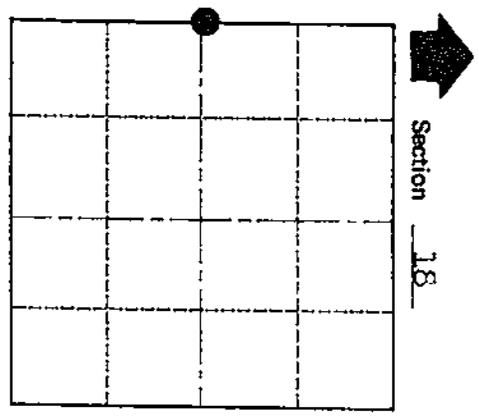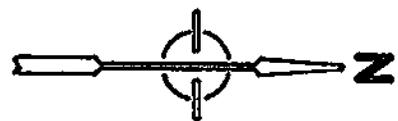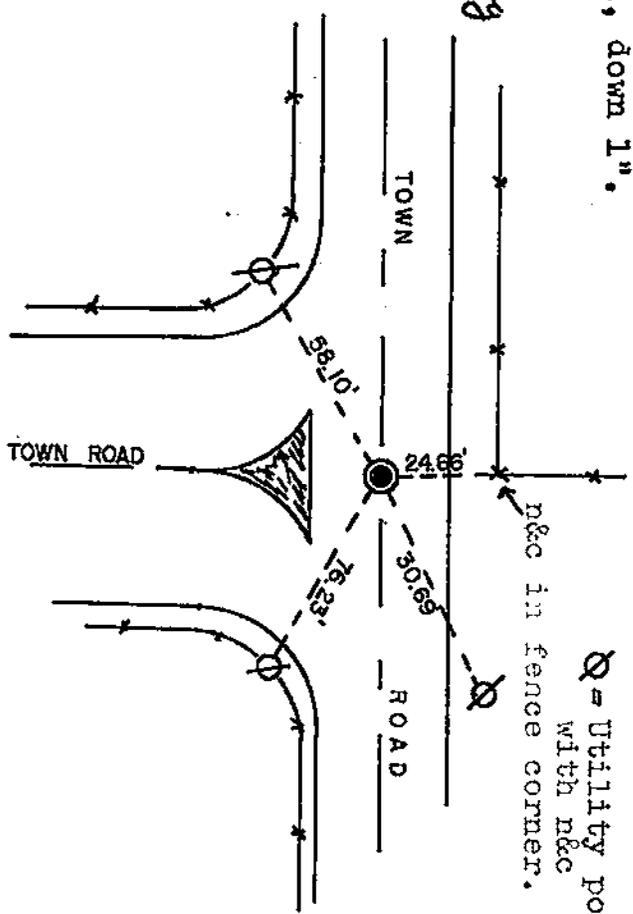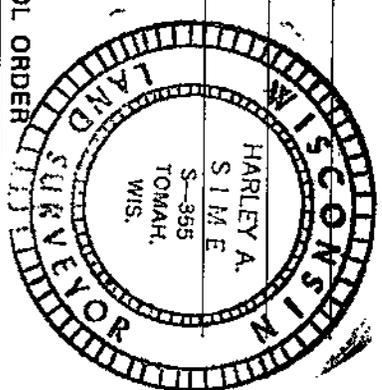

Horizontal	Vertical	East (X)	North (Y)	Elevation (Z)	Zone

WISCONSIN COORDINATE SYSTEM

City, Village or Town Sparta

County of Monroe