


21705140000

U. S. PUBLIC LAND SURVEY MONUMENT RECORD

SECTION 13 T 17 N, R 5 W, TOWN OF Burns

LA CROSSE COUNTY

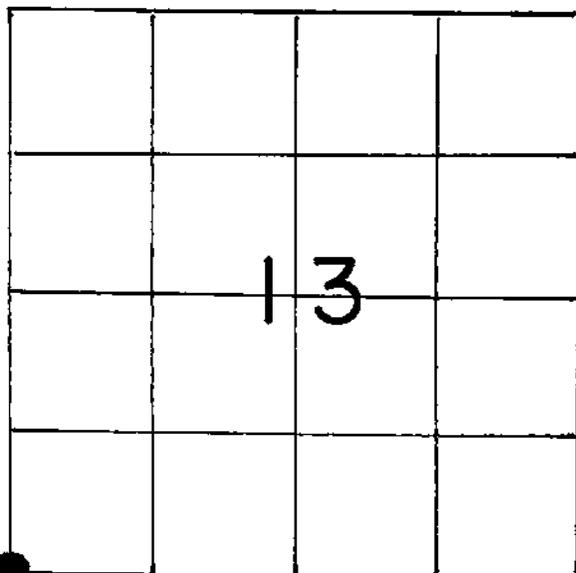

LOCATION OF LANDMARK

Crew: William C. Jung

Date: 9/27/89

Describe any record evidence, monument evidence, testimonial evidence or any other material evidence you considered and whether the monument was found or restored through acceptance of an obliterated evidence location.

After surveying out the South 1/2 of Section 13, I accepted the old occupied fence corner as the best available evidence of the original government corner position. Gary Sime, who is presently working in Section 23 to the Southwest, agrees with me on this. I found his railroad spike survey point at the fence corner, removed it, and replaced it with an iron bar.

Describe or show any material discrepancy between the location of the restored corner and that of the corner previously restored or reestablished.

None known.

WISCONSIN COORDINATE SYSTEM

North

East

Theta Angle

Horiz. Order

Vert. Order


TYPE OF LANDMARK

3/4"x24" round iron bar

BEARINGS ARE REFERENCED TO

RECORD OF DURABLE WITNESS MONUMENTS
Magnetic


NO	DESCRIPTION	BEARING	DISTANCE
1	P.K. nail in single blazed 15" w. oak	N2°W	slope=29.44'
2	" " " " " 12" " "	N37°W	11.34'
3	" " " " " 7" " "	S30°E	7.48'
4	" " " " " 10" " "	S66°E	17.30'

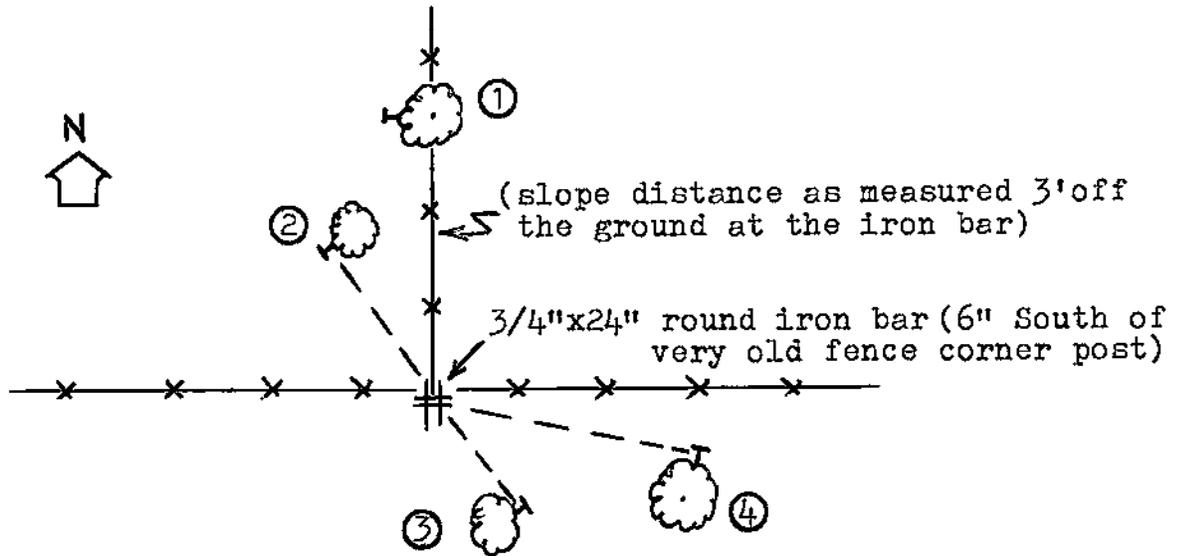

PLAN VIEW DRAWING OF REFERENCE TIES

MAP SHOWING DISTANCE AND DIRECTION TO OTHER PUBLIC LAND SURVEY CORNERS USED FOR REESTABLISHING THE CORNER


(not to scale)

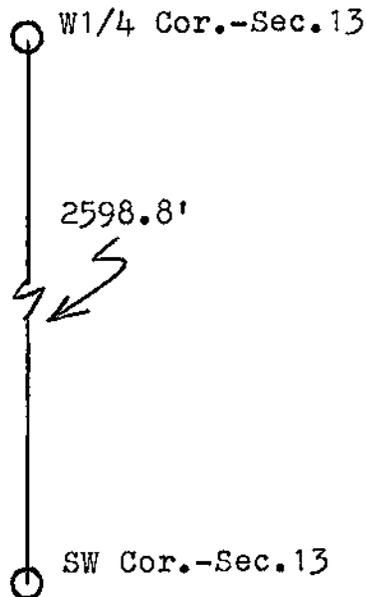

I, William C. Jung
HEREBY CERTIFY THAT THE CORNER LOCATION SHOWN ON THIS RECORD WAS DETERMINED BY ME OR UNDER MY DIRECTION AND CONTROL AND THAT THIS U. S. PUBLIC LAND SURVEY MONUMENT RECORD IS CORRECT AND COMPLETE TO THE BEST OF MY KNOWLEDGE AND BELIEF.

William C. Jung
Signature

October 17, 1989
Date

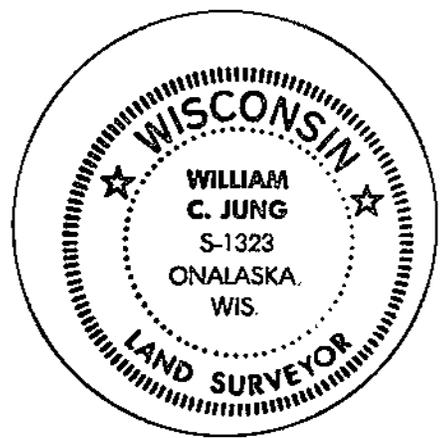

Seal