


21705142000

## U. S. PUBLIC LAND SURVEY MONUMENT RECORD

SECTION 13 T 17 N, R 5 W, TOWN OF BURNS

LA CROSSE COUNTY

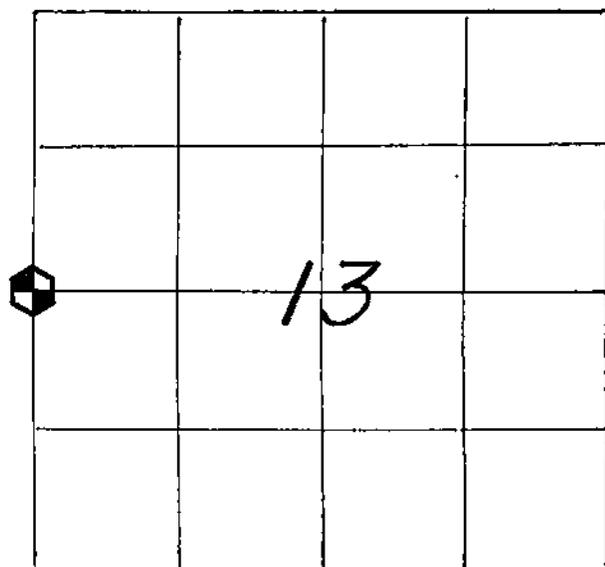

LOCATION OF LANDMARK

CREW: *WILLIAM G. JUNG*  
*PETER F. FOLLANSBEE*  
 DATE: *8/20/1999.*

## WISCONSIN COORDINATE SYSTEM

North

East

Theta Angle

Horiz. Order

Vert. Order

## TYPE OF LANDMARK

*BRASS CAP LUNDE MARKER.*

## BEARINGS ARE REFERENCED TO

Grid

Describe any record evidence, monument evidence, testimonial evidence or any other material evidence you considered and whether the monument was found or restored through acceptance of an obliterated evidence location.


I set an iron bar at this corner in 1989. I found my old iron bar and replaced it with a brass capped Lunde marker.

Describe or show any material discrepancy between the location of the restored corner and that of the corner previously restored or reestablished.


*NONE KNOWN.*

RECORD OF DURABLE WITNESS MONUMENTS

NO	DESCRIPTION	BEARING	DISTANCE
1	SET A 3/4" x 30" IRON BAR 1'± EAST OF CENTER OF GATE	NORTH ±	34.58 FT.
2	SET A 3/4" x 30" IRON BAR 1'± WEST OF CENTER OF GATE	N. EAST ±	39.52 FT.
3	SET A 1-1/4" x 24" IRON PIPE 1'± WEST OF FENCE	EAST ±	32.92 FT.
4	SET A 3/4" x 23" IRON BAR 1'± EAST OF 8" x 6" FENCE POST.	SOUTH ±	53.44 FT.

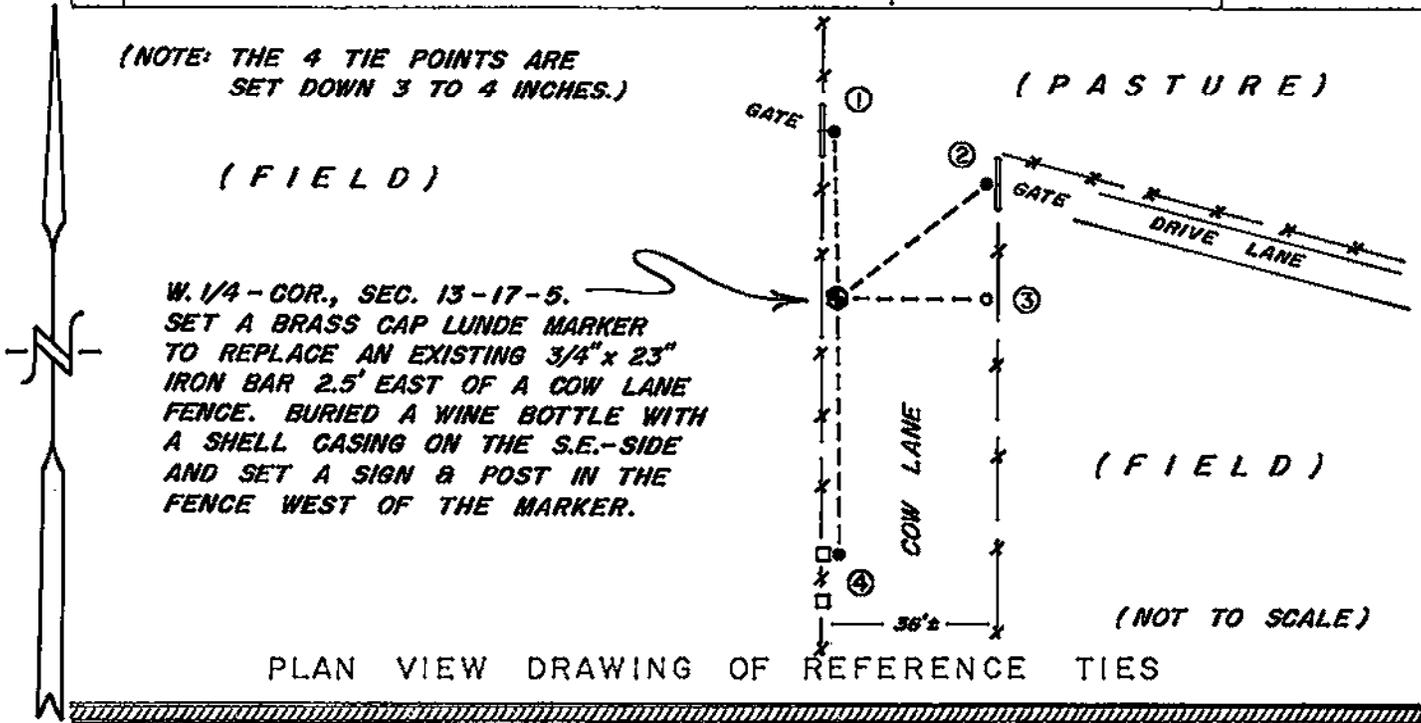


MAP SHOWING DISTANCE AND DIRECTION TO OTHER PUBLIC LAND SURVEY CORNERS USED FOR REESTABLISHING THE CORNER

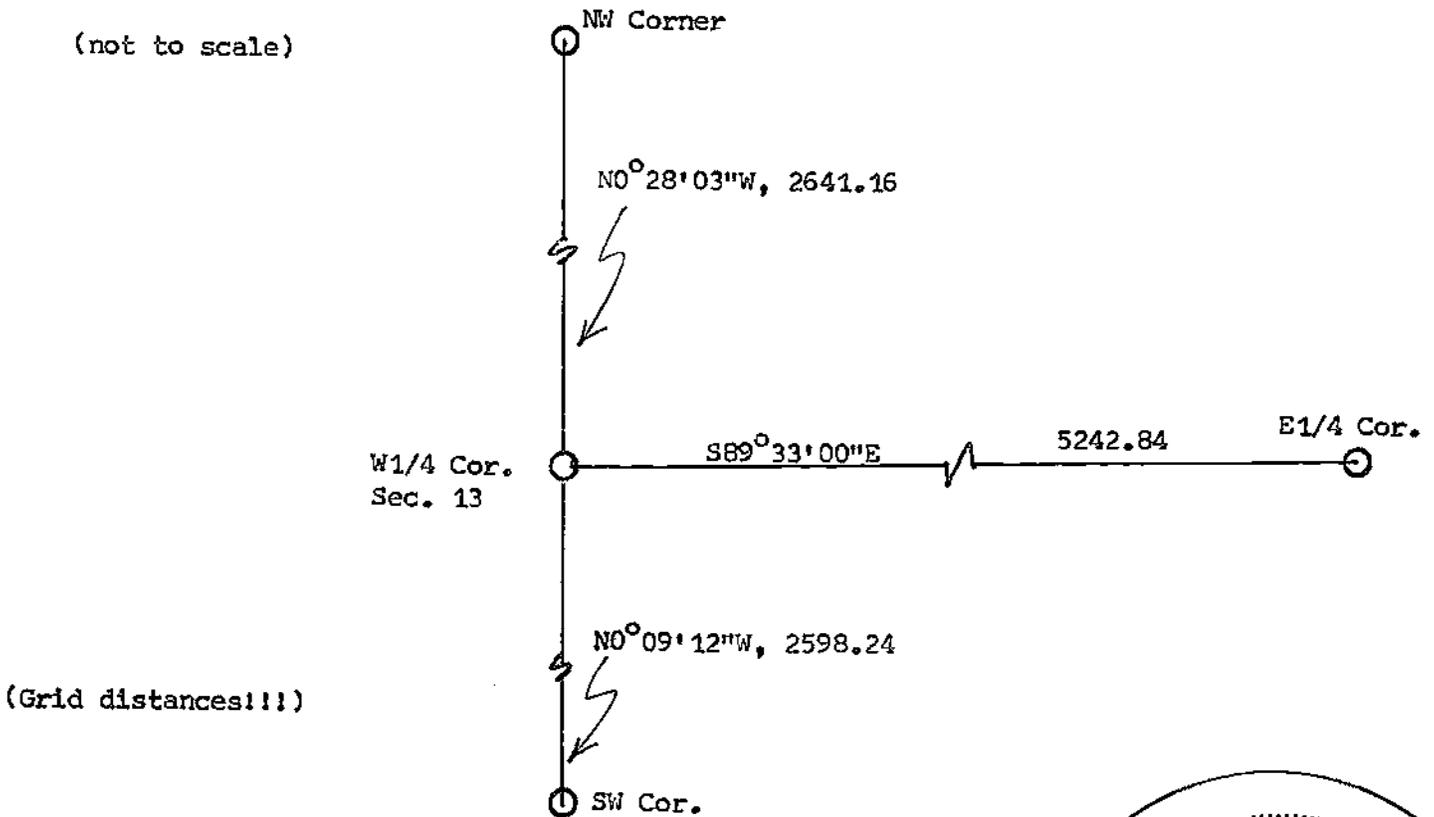

I, WILLIAM C. JUNG, COUNTY SURVEYOR  
 HEREBY CERTIFY THAT THE CORNER LOCATION SHOWN ON THIS RECORD WAS DETERMINED BY ME OR UNDER MY DIRECTION AND CONTROL AND THAT THIS U. S. PUBLIC LAND SURVEY MONUMENT RECORD IS CORRECT AND COMPLETE TO THE BEST OF MY KNOWLEDGE AND BELIEF.

William C. Jung 9/27/99  
 Signature Date

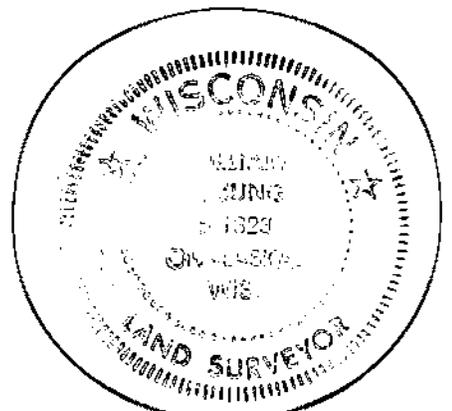


Seal

## U. S. PUBLIC LAND SURVEY MONUMENT RECORD

SECTION 13 T 17 N, R 5 W, TOWN OF Burns

LA CROSSE COUNTY

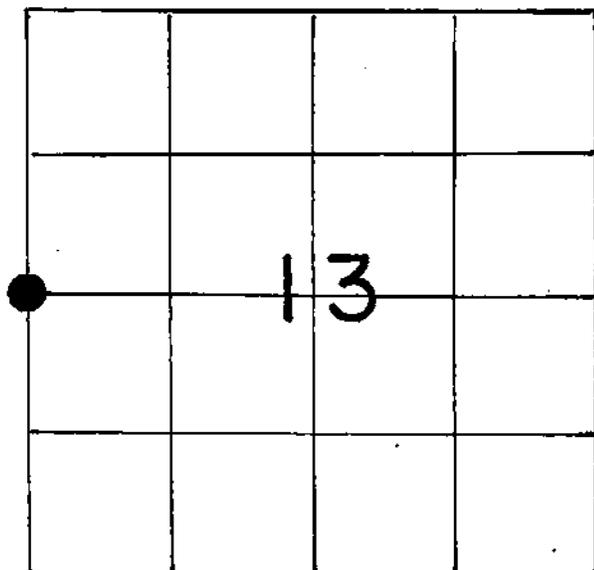

LOCATION OF LANDMARK

Crew: William C. Jung

Date: 10/6/89

WISCONSIN COORDINATE SYSTEM
North
East
Theta Angle
Horiz. Order
Vert. Order
TYPE OF LANDMARK
3/4"x23" round iron bar
BEARINGS ARE REFERENCED TO
True

Describe any record evidence, monument evidence, testimonial evidence or any other material evidence you considered and whether the monument was found or restored through acceptance of an obliterated evidence location.


I set the corner by putting it on line with the Southwest Corner of Section 13 and the occupied W1/16SW of Section 13 and at a distance from said W1/16SW equal to that between the W1/16SW and Southwest. This 1/2 mile is short of the original government notes, but after surveying out the S1/2 of Section 13 and measuring up all the interior corners, etc., I am convinced that this is the best way to set the corner. The occupied evidence fit very well. To set the corner otherwise would make a shambles of the occupied S1/2. I set an iron bar at the corner.

Describe or show any material discrepancy between the location of the restored corner and that of the corner previously restored or reestablished.

None known.


RECORD OF DURABLE WITNESS MONUMENTS

NO	DESCRIPTION	BEARING	DISTANCE
1	Set P.K. nail in fence post	Magnetic= $N6^{\circ}W$	42.83'
2	" " " " " "	" = $N46^{\circ}E$	46.12'
3			
4			

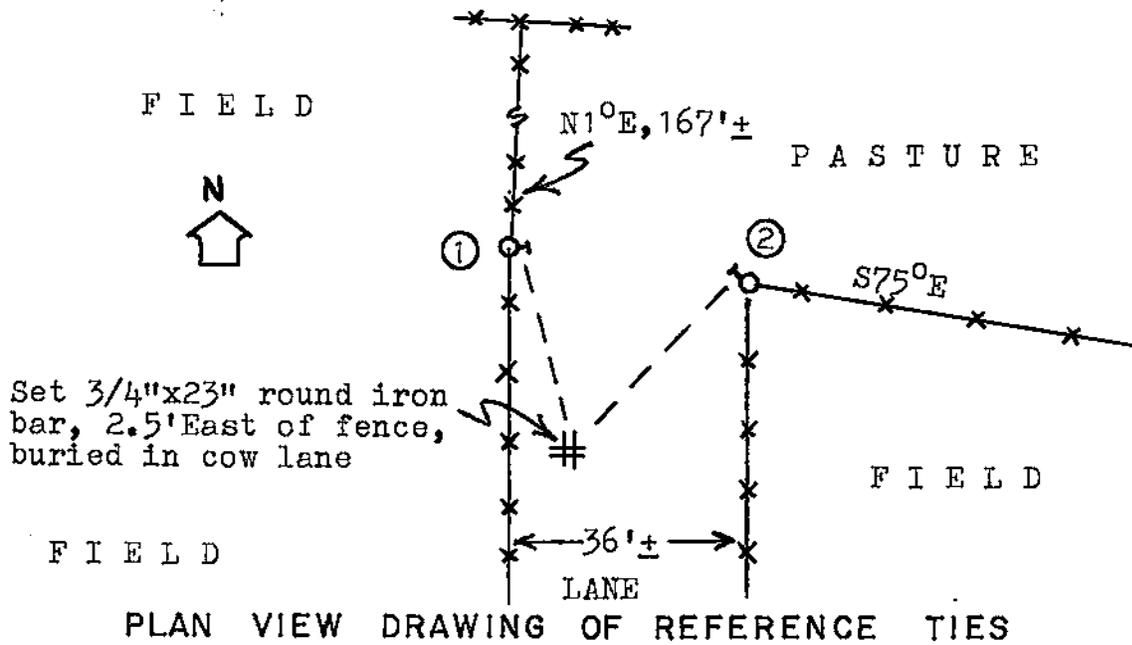

MAP SHOWING DISTANCE AND DIRECTION TO OTHER PUBLIC LAND SURVEY CORNERS USED FOR REESTABLISHING THE CORNER


(not to scale)

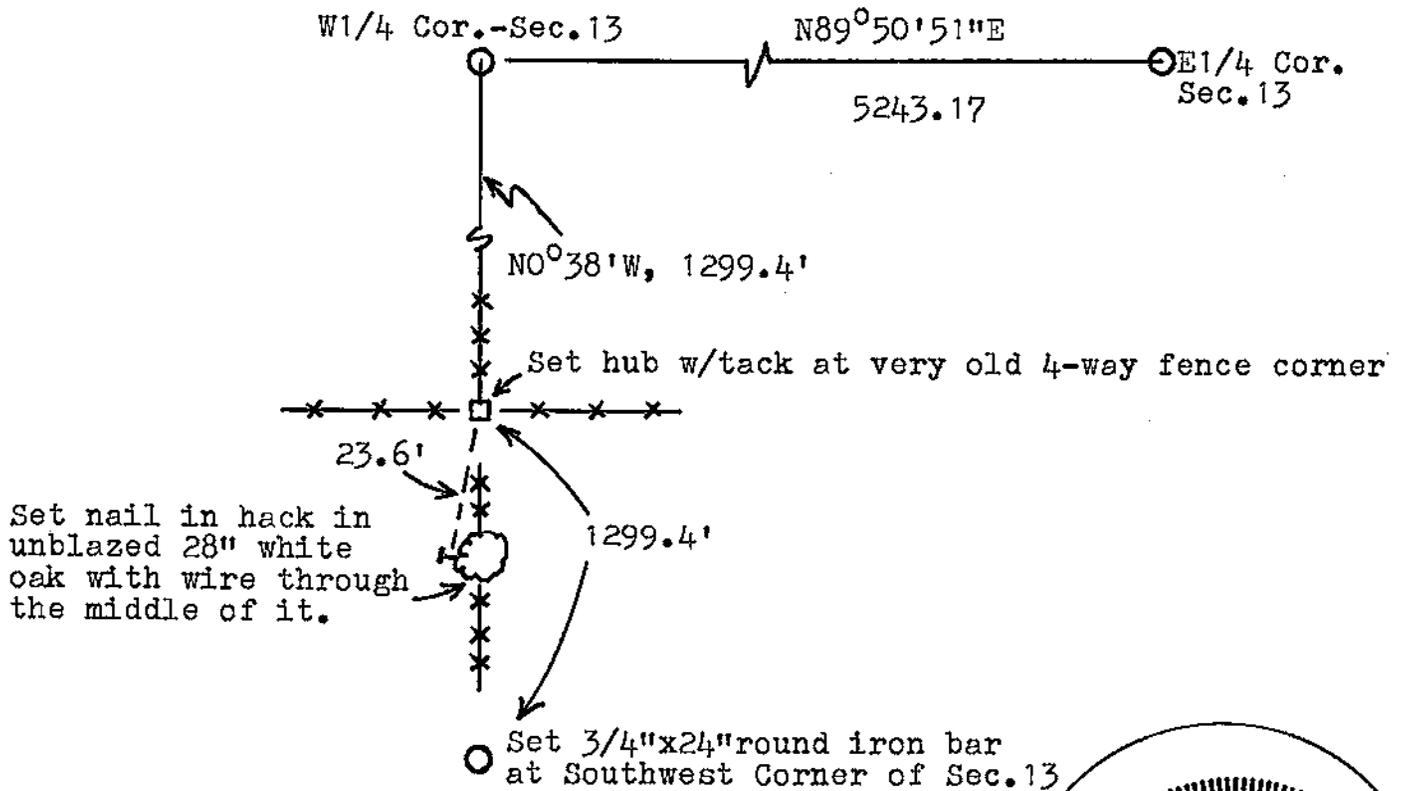

I, William C. Jung  
 HEREBY CERTIFY THAT THE CORNER LOCATION SHOWN ON THIS RECORD  
 WAS DETERMINED BY ME OR UNDER MY DIRECTION AND CONTROL AND  
 THAT THIS U. S. PUBLIC LAND SURVEY MONUMENT RECORD IS CORRECT  
 AND COMPLETE TO THE BEST OF MY KNOWLEDGE AND BELIEF.

William C. Jung  
 Signature

October 17, 1989  
 Date

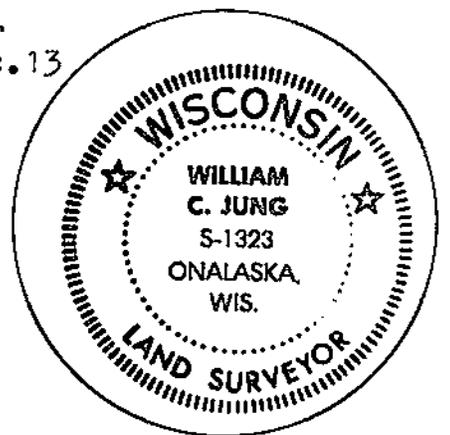

Seal