


21705150000

U. S. PUBLIC LAND SURVEY MONUMENT RECORD

SECTION 22 T 17 N, R 5 W, TOWN OF BURNS
 LA CROSSE COUNTY

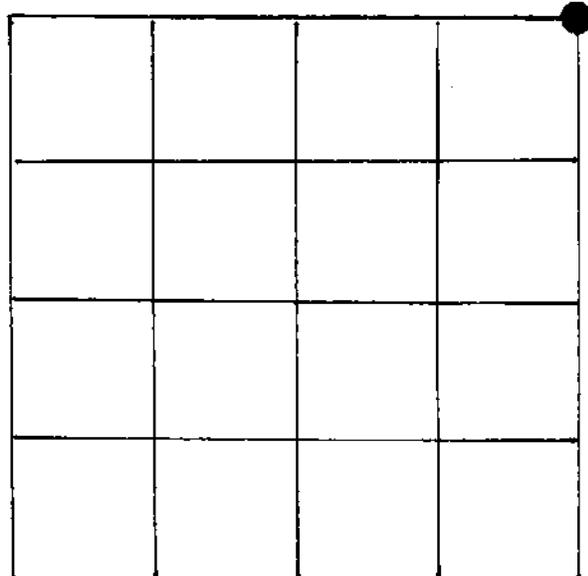

LOCATION OF LANDMARK

WISCONSIN COORDINATE SYSTEM

North

East

Theta Angle

Horiz. Order

Vert. Order

TYPE OF LANDMARK

BEARINGS ARE REFERENCED TO

Describe any record evidence, monument evidence, testimonial evidence or any other material evidence you considered and whether the monument was found or restored through acceptance of an obliterated evidence location.


Accepted the intersection of an existing north - south fence line and the centerline of Jewett Rd. as best available evidence.

Describe or show any material discrepancy between the location of the restored corner and that of the corner previously restored or reestablished.

There was no known history of corner re-establishment since the original government survey.

RECORD OF DURABLE WITNESS MONUMENTS

NO	DESCRIPTION	BEARING	DISTANCE
1			
2			
3	AS BELOW		
4			

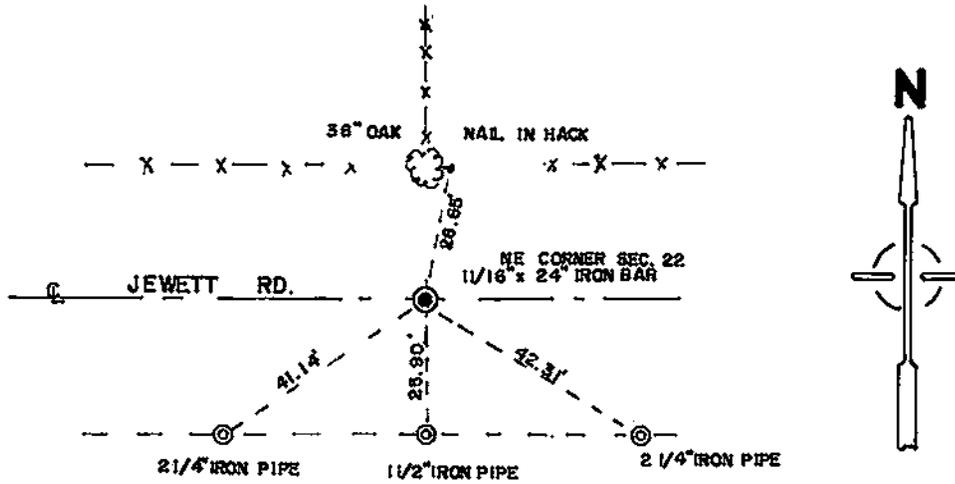

PLAN VIEW DRAWING OF REFERENCE TIES

MAP SHOWING DISTANCE AND DIRECTION TO OTHER PUBLIC LAND SURVEY CORNERS USED FOR REESTABLISHING THE CORNER



I, Garold A. Sime
 HEREBY CERTIFY THAT THE CORNER LOCATION SHOWN ON THIS RECORD
 WAS DETERMINED BY ME OR UNDER MY DIRECTION AND CONTROL AND
 THAT THIS U. S. PUBLIC LAND SURVEY MONUMENT RECORD IS CORRECT
 AND COMPLETE TO THE BEST OF MY KNOWLEDGE AND BELIEF.

Garold A. Sime May 10, 1984
 Signature Date




Seal

Zoning and Planning Department

LA CROSSE COUNTY, WISCONSIN

COURTHOUSE, LA CROSSE, WISCONSIN 54601

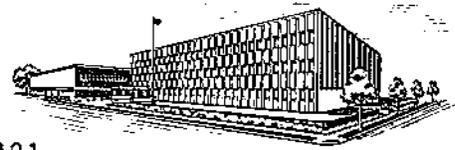

Telephone: 785-9722

NE Corner-Section 22-T17N-R5W

September 16, 1992

To Whom It May Concern:

This is to certify that on September 10, 1992, I replaced Sime's iron bar with a brass capped Lunde marker. Sime had two 1' nail and cap offsets. I also set a sign and post by the iron pipe 25.9' to the South.

Certified as correct by:

A handwritten signature in cursive script that reads "William C. Jung". The signature is written in dark ink and is positioned above a horizontal line.

William C. Jung, R.L.S.

Deputy County Surveyor

