


21705150020

U. S. PUBLIC LAND SURVEY MONUMENT RECORD

SECTION 22 T 17 N, R 5 W, TOWN OF BURNS

LA CROSSE COUNTY

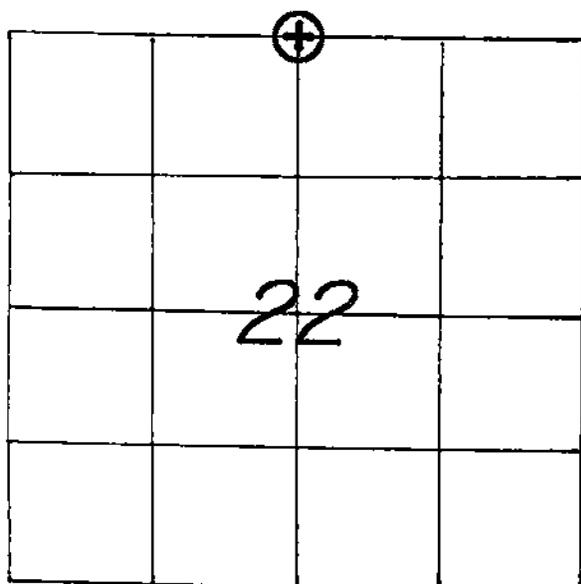

WISCONSIN COORDINATE SYSTEM

North 709,523.910

East 1,715,409.396

Theta Angle

Horiz. Order

Vert. Order

DATUM: 1983('91)

TYPE OF LANDMARK
3/4" x 30" IRON BAR WITH AN ALUMINUM CAP.BEARINGS ARE REFERENCED TO
GRID NORTH AS PER SECTION DATA.

LOCATION OF LANDMARK

CREW: WILLIAM G. JUNG
PETER F. FOLLANSBEE
DATE: 8/16/2007

Describe any record evidence, monument evidence, testimonial evidence or any other material evidence you considered and whether the monument was found or restored through acceptance of an obliterated evidence location.


In May of 1984 Gary Sime and I traversed the North line of Section 22. I helped Sime on this job just before I started to work for LaCrosse County. Based on the evidence found, we decided at that time that the 1/4 corner should be at the single proportionate position. Three surveys are now based on this. We did not set the corner at that time. Pete and I set the corner at this single proportionate position. The old fences in the area of the corner on this "knob" are pretty wild.

Describe or show any material discrepancy between the location of the restored corner and that of the corner previously restored or reestablished.

NONE KNOWN.


RECORD OF DURABLE WITNESS MONUMENTS

NO	DESCRIPTION	MAGNETIC	
		BEARING	DISTANCE
1	SET A NAIL IN S.-SIDE OF A 7" WHITE OAK	N 83° W	26.14 FT.
2	SET A NAIL IN E.-SIDE OF A 9" HICKORY	N 04° E	29.70 FT.
3	SET A NAIL IN N.W.-SIDE OF AN 11 1/2" OAK	N 47° E	37.22 FT.
4	SET A NAIL IN N.W.-SIDE OF A DOUBLE TRUNK OAK	S 30° W	11.28 FT.

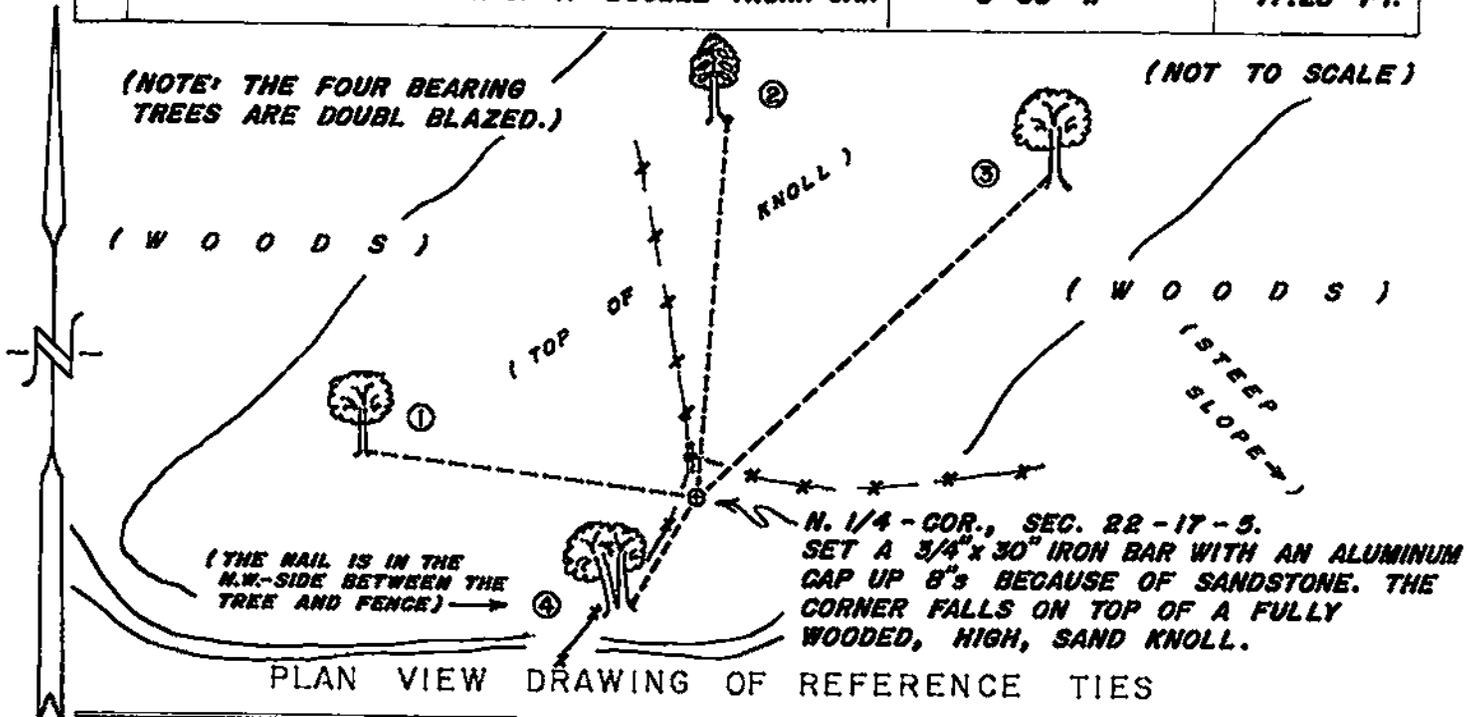

MAP SHOWING DISTANCE AND DIRECTION TO OTHER PUBLIC LAND SURVEY CORNERS USED FOR REESTABLISHING THE CORNER

(GRID BEARINGS AND DISTANCES)
 (GRID FACTOR: 0.999936688)
 (NOT TO SCALE)

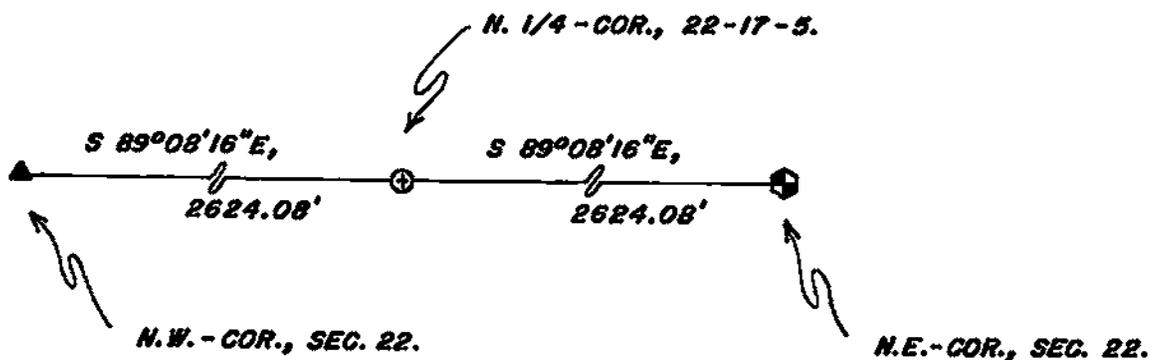

I, WILLIAM C. JUNG, COUNTY SURVEYOR
 HEREBY CERTIFY THAT THE CORNER LOCATION SHOWN ON THIS RECORD WAS DETERMINED BY ME OR UNDER MY DIRECTION AND CONTROL AND THAT THIS U. S. PUBLIC LAND SURVEY MONUMENT RECORD IS CORRECT AND COMPLETE TO THE BEST OF MY KNOWLEDGE AND BELIEF.

William C. Jung
 Signature

8/24/07
 Date



Seal