


21705152000

U. S. PUBLIC LAND SURVEY MONUMENT RECORD

SECTION 14 T 17 N, R 5 W, TOWN OF BURNS

LA CROSSE COUNTY

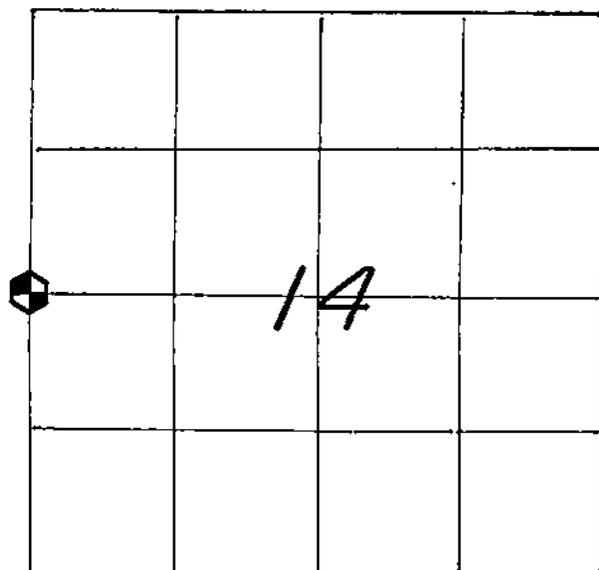

LOCATION OF LANDMARK

CREW: **WILLIAM C. JUNG**
PETER F. FOLLANSBEE
 DATE: **9/20/1999**

WISCONSIN COORDINATE SYSTEM

North

East

Theta Angle

Horiz. Order

Vert. Order

TYPE OF LANDMARK

BRASS CAP LUNDE MARKER.

BEARINGS ARE REFERENCED TO

GRID NORTH AS PER SECTION DATA.

Describe any record evidence, monument evidence, testimonial evidence or any other material evidence you considered and whether the monument was found or restored through acceptance of an obliterated evidence location.

I found very good evidence of what I believe to be the original section line run on the West line of the SW1/4, that evidence being an old North-South fence. The evidence at the W1/16SW is very good, this being an old fence corner. I set the corner equidistant between the section corners and on line with the old line to the South. A brass capped Lunde was set at the corner.


Describe or show any material discrepancy between the location of the restored corner and that of the corner previously restored or reestablished.

None known.

RECORD OF DURABLE WITNESS MONUMENTS


GRID NORTH

NO	DESCRIPTION	BEARING	DISTANCE
1	SET A NAIL IN S.E.-SIDE OF AN 11" BOX ELDER	N 09°21' W	36.55 FT.
2	SET A NAIL IN W.-SIDE OF A 10-1/2" OAK	S 53°13' E	78.12 FT.
3	SET A NAIL IN S.W.-SIDE OF A 15" DOUBLE OAK	S 29°44' E	50.34 FT.
4	SET A NAIL IN E.-SIDE OF A 9" OAK	S 04°29' E	50.40 FT.

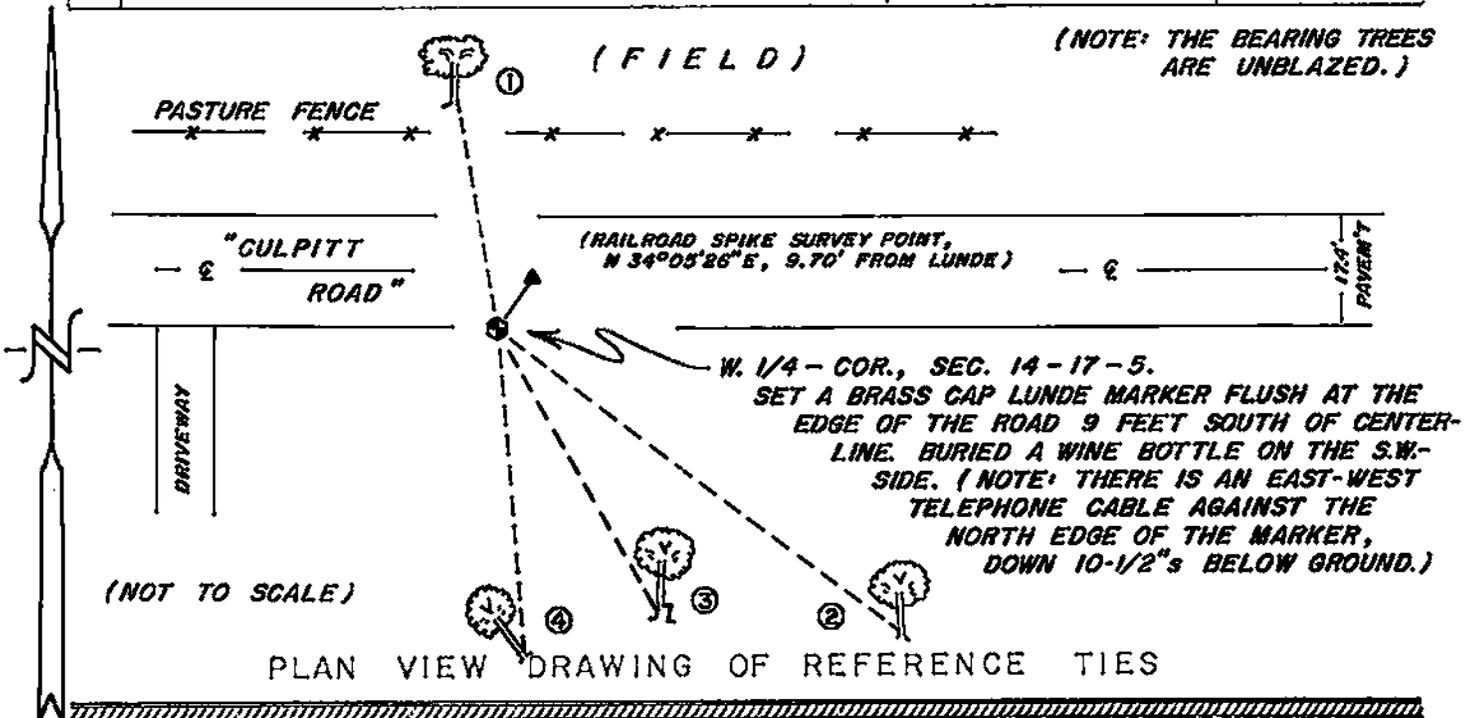

MAP SHOWING DISTANCE AND DIRECTION TO OTHER PUBLIC LAND SURVEY CORNERS USED FOR REESTABLISHING THE CORNER

(not to scale)

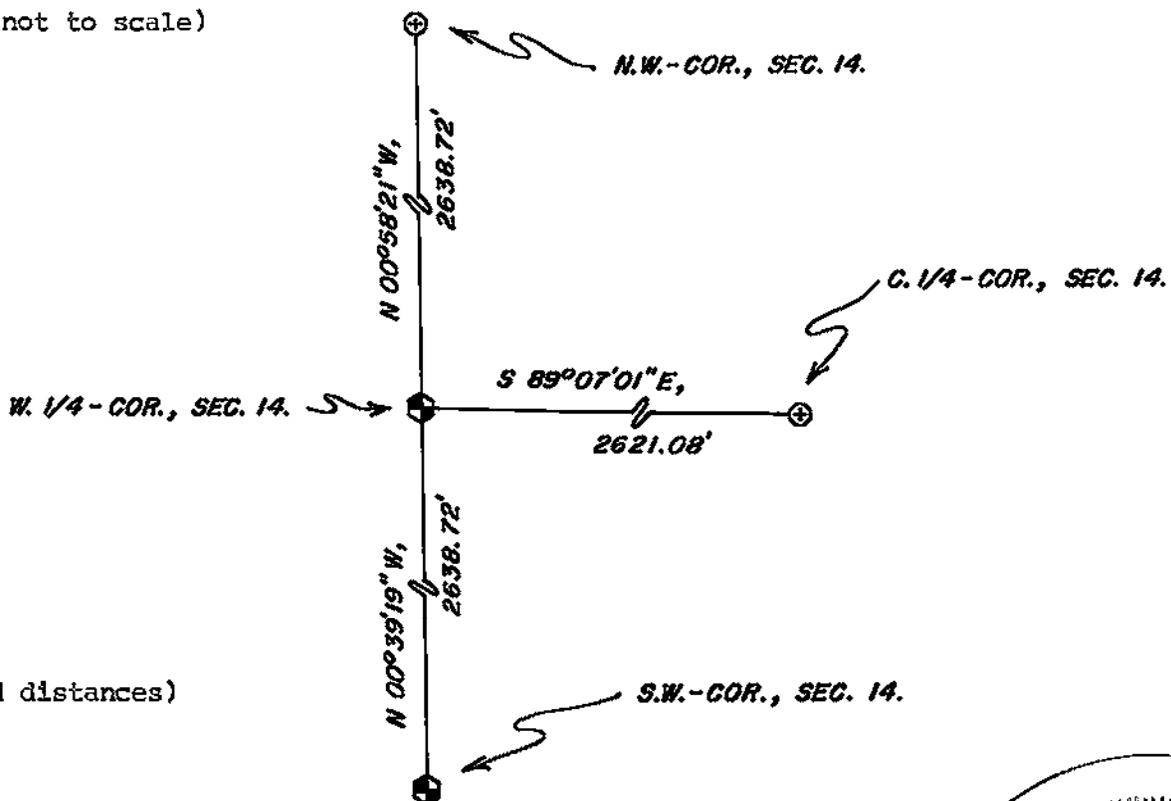


(grid distances)

I, WILLIAM C. JUNG, COUNTY SURVEYOR
 HEREBY CERTIFY THAT THE CORNER LOCATION SHOWN ON THIS RECORD WAS DETERMINED BY ME OR UNDER MY DIRECTION AND CONTROL AND THAT THIS U. S. PUBLIC LAND SURVEY MONUMENT RECORD IS CORRECT AND COMPLETE TO THE BEST OF MY KNOWLEDGE AND BELIEF.

William C. Jung
 Signature

10/1/99
 Date

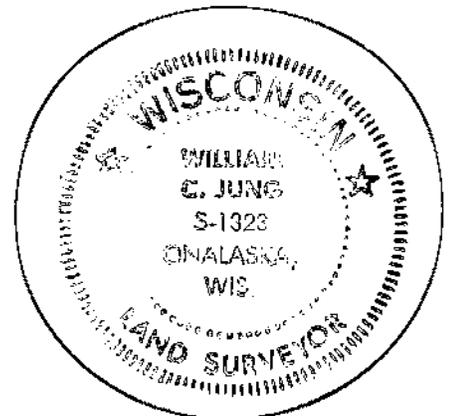

Seal