


U. S. PUBLIC LAND SURVEY MONUMENT RECORD

SECTION 16 T 17 N, R 5 W, TOWN OF BURNS
 LA CROSSE COUNTY

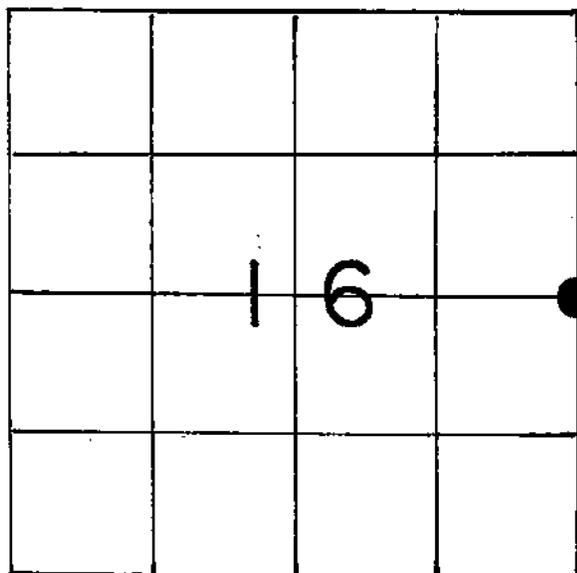

LOCATION OF LANDMARK

Crew: William C. Jung
 Peter Follansbee

Date: 3/1/90

WISCONSIN COORDINATE SYSTEM

North
East
Theta Angle
Horiz. Order
Vert. Order

TYPE OF LANDMARK
~~Set 1"x30" iron pipe~~ Lunde marker

BEARINGS ARE REFERENCED TO
 True

Crew: Peter Follansbee
 Daniel Leis

Date: 6/26/90

Describe any record evidence, monument evidence, testimonial evidence or any other material evidence you considered and whether the monument was found or restored through acceptance of an obliterated evidence location.

I intersected the existing East-West line fence with the projection of the old line fence to the North extended South. I accepted these occupied conditions as the best available evidence of the original government corner position. This location falls near an old post. I set an iron pipe at the corner. Mr. Heuer, age 78, has lived on the farm to the Northwest since 1919 and knew of no permanent marker ever existing at this corner. The occupied conditions here are apparently as he remembers them as he had no problems with the location of the line fences.

Describe or show any material discrepancy between the location of the restored corner and that of the corner previously restored or reestablished.

None known.

Note: The iron pipe was replaced by a Lunde on 6/26/90. A sign and post were set to the East of the Lunde.

