


21705170020

U. S. PUBLIC LAND SURVEY MONUMENT RECORD

SECTION 20 T 17 N, R 5 W, TOWN OF BURNS

LA CROSSE COUNTY

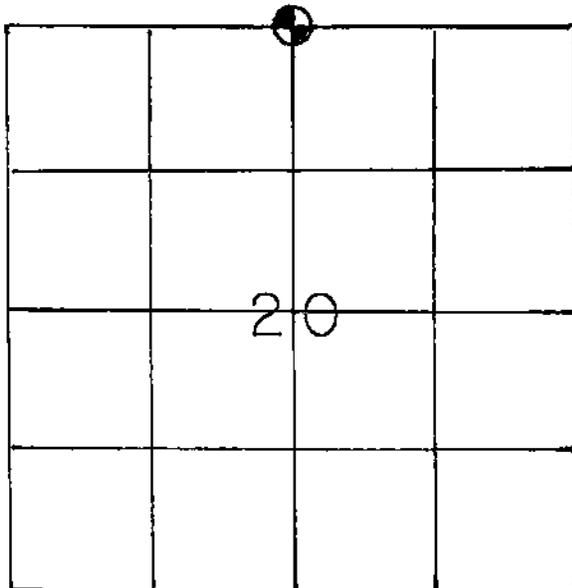

LOCATION OF LANDMARK

CREW: BILL JUNG AND PERRY DAHL
DATE: 9-23-86

WISCONSIN COORDINATE SYSTEM

North

East

Theta Angle

Horiz. Order

Vert. Order

TYPE OF LANDMARK
1 5/8" IRON PIPE

BEARINGS ARE REFERENCED TO

True

Describe any record evidence, monument evidence, testimonial evidence or any other material evidence you considered and whether the monument was found or restored through acceptance of an obliterated evidence location.

The old occupied corner had been grubbed out. However I was able to reconstruct its location. I accepted the occupied corner as the best available evidence of the original government corner position and monumented it with an iron pipe.


Describe or show any material discrepancy between the location of the restored corner and that of the corner previously restored or reestablished.

None known.

RECORD OF DURABLE WITNESS MONUMENTS
MAGNETIC

NO	DESCRIPTION	BEARING	DISTANCE
1	P.K. NAIL IN UNBLAZED 7" NUT TREE	N88°E	60'-5 1/8"
2	1" IRON PIPE	N88°E	31'-5/8"
3	1" IRON PIPE	S3°W	30'-1"
4	P.K. NAIL IN DOUBLE-BLAZED BOX ALDER	S41°E	59'-2 1/4"


O P E N F I E L D

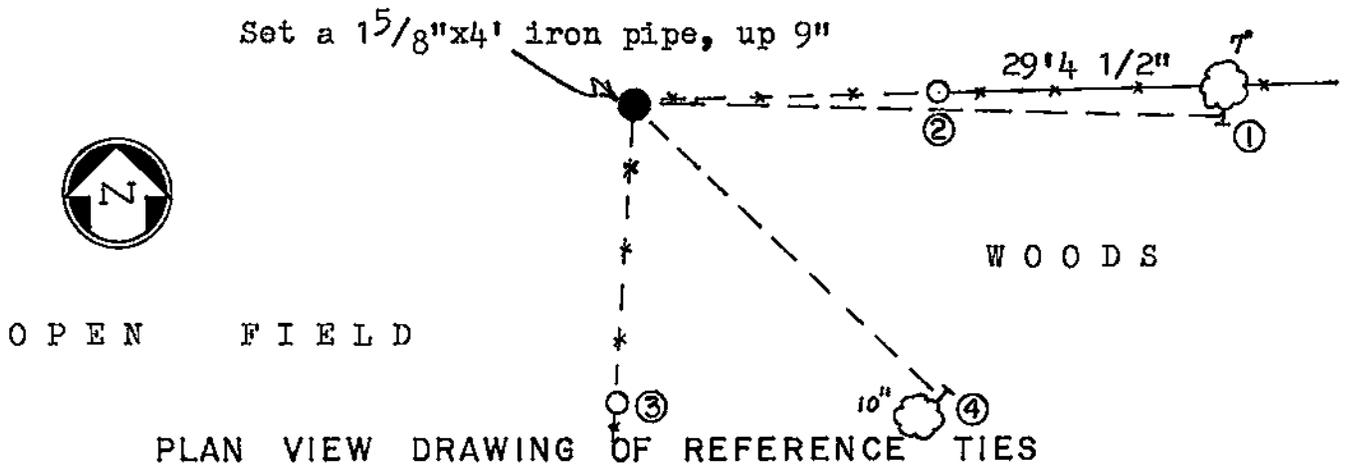

PLAN VIEW DRAWING OF REFERENCE TIES

MAP SHOWING DISTANCE AND DIRECTION TO OTHER PUBLIC LAND SURVEY CORNERS USED FOR REESTABLISHING THE CORNER


(Not to scale)

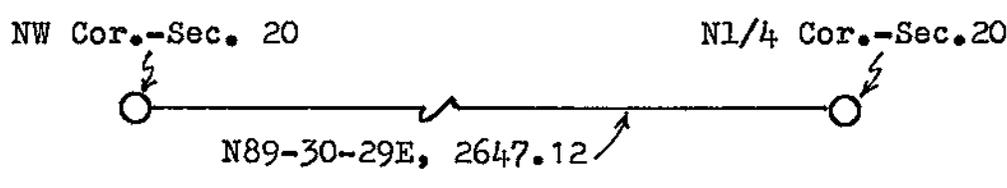

I, William C. Jung, Deputy County Surveyor,
HEREBY CERTIFY THAT THE CORNER LOCATION SHOWN ON THIS RECORD
WAS DETERMINED BY ME OR UNDER MY DIRECTION AND CONTROL AND
THAT THIS U. S. PUBLIC LAND SURVEY MONUMENT RECORD IS CORRECT
AND COMPLETE TO THE BEST OF MY KNOWLEDGE AND BELIEF.

William C. Jung
Signature

December 10, 1986
Date

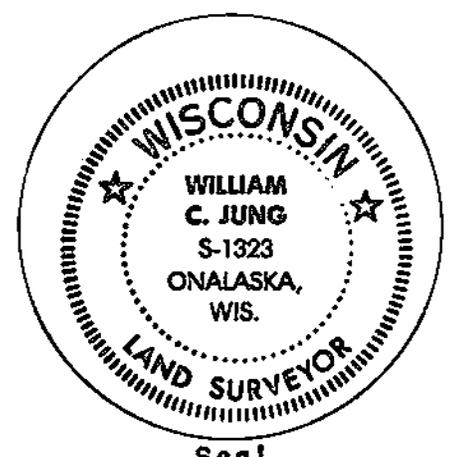

Seal