


21705180000

U. S. PUBLIC LAND SURVEY MONUMENT RECORD

SECTION 20 T 17 N, R 5 W, TOWN OF BURNS

LA CROSSE COUNTY

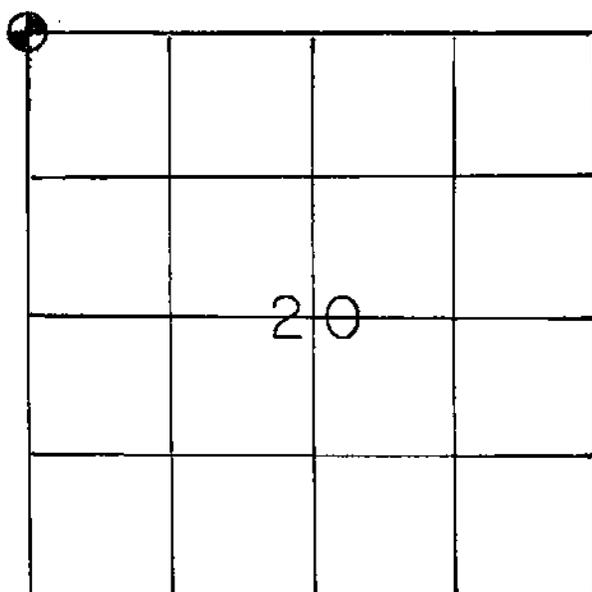

WISCONSIN COORDINATE SYSTEM

North

East

Theta Angle

Horiz. Order

Vert. Order

TYPE OF LANDMARK

BRASS CAPPED LUNDE MARKER

BEARINGS ARE REFERENCED TO

True

LOCATION OF LANDMARK

CREW:

BILL JUNG AND PERRY DAHL

DATE: 9-23-86

Describe any record evidence, monument evidence, testimonial evidence or any other material evidence you considered and whether the monument was found or restored through acceptance of an obliterated evidence location.


I set the corner at a location that I feel best fits the old occupied corner and accepted this location as the best available evidence of the original government corner position. I monumented it with a Lunde marker.

Describe or show any material discrepancy between the location of the restored corner and that of the corner previously restored or reestablished.

None known.

RECORD OF DURABLE WITNESS MONUMENTS

NO	DESCRIPTION	BEARING	DISTANCE
1	P.K. NAIL IN DOUBLE-BLAZED ASPEN, 11"	N35°E = MAG.	14.83'
2	BOLT (near old fence cor. location)	NORTH +	5.93'
3	P.K. NAIL IN DOUBLE-BLAZED 8" HICKORY	N42°W = MAG.	82.97'
4	P.K. NAIL IN DOUBLE-BLAZED 9" HICKORY	S86°W "	20.38'
5	P.K. NAIL IN DOUBLE-BLAZED 7" SPRUCE	S36°W "	50.7'

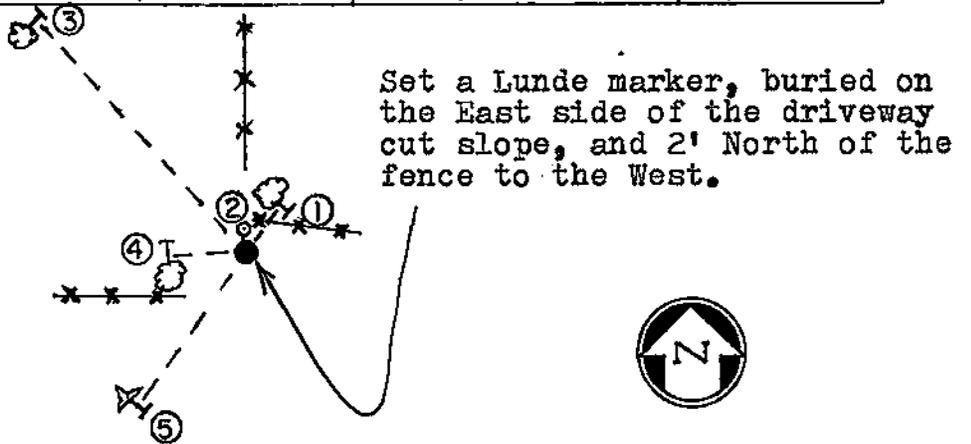


PLAN VIEW DRAWING OF REFERENCE TIES



MAP SHOWING DISTANCE AND DIRECTION TO OTHER PUBLIC LAND SURVEY CORNERS USED FOR REESTABLISHING THE CORNER


(Not to scale)

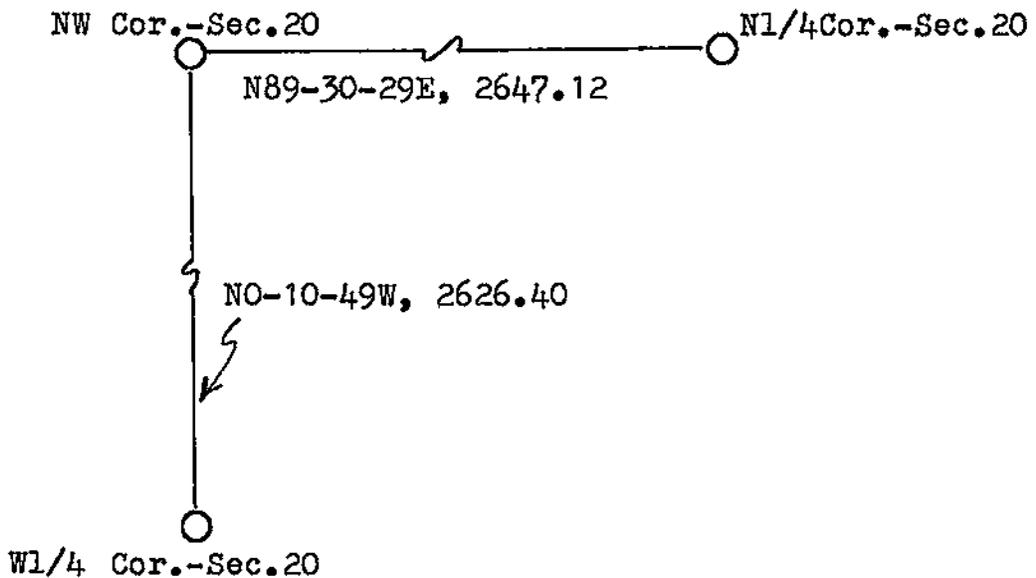

I, William C. Jung, Deputy County Surveyor,
 HEREBY CERTIFY THAT THE CORNER LOCATION SHOWN ON THIS RECORD
 WAS DETERMINED BY ME OR UNDER MY DIRECTION AND CONTROL AND
 THAT THIS U. S. PUBLIC LAND SURVEY MONUMENT RECORD IS CORRECT
 AND COMPLETE TO THE BEST OF MY KNOWLEDGE AND BELIEF.

William C. Jung
 Signature

December 10, 1986
 Date

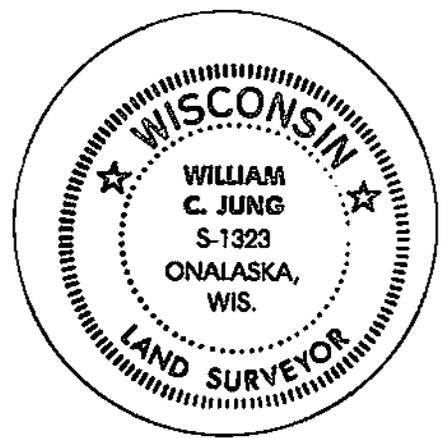

Seal