


21705180020

U. S. PUBLIC LAND SURVEY MONUMENT RECORD

SECTION 19 T 17 N, R 5 W, TOWN OF BURNS

LA CROSSE COUNTY

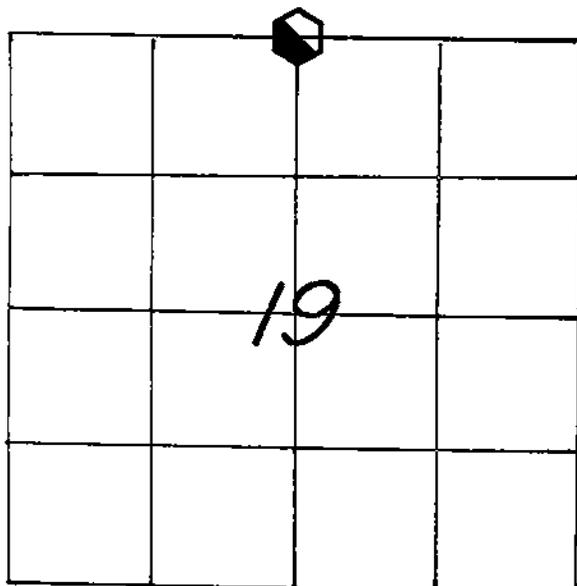

WISCONSIN COORDINATE SYSTEM

North

East

Theta Angle

Horiz. Order

Vert. Order

TYPE OF LANDMARK

30" ALUMINUM BERNTSEN MARKER.

BEARINGS ARE REFERENCED TO

ASSUMED NORTH AS PER SECTION DATA.

LOCATION OF LANDMARK

CREW: WILLIAM C. JUNG
 PETER F. FOLLANSBEE
 DATE: 8/17/2005

Describe any record evidence, monument evidence, testimonial evidence or any other material evidence you considered and whether the monument was found or restored through acceptance of an obliterated evidence location.

After discussing this corner at length, Dick Berg and I agreed that it should be set by single proportionate measurement. I removed Berg's pipe and replaced it with a Berntsen marker.

Describe or show any material discrepancy between the location of the restored corner and that of the corner previously restored or reestablished.

NONE KNOWN.

