


21705182000

U. S. PUBLIC LAND SURVEY MONUMENT RECORD

SECTION 17 T 17 N, R 5 W, TOWN OF BURNS

LA CROSSE COUNTY

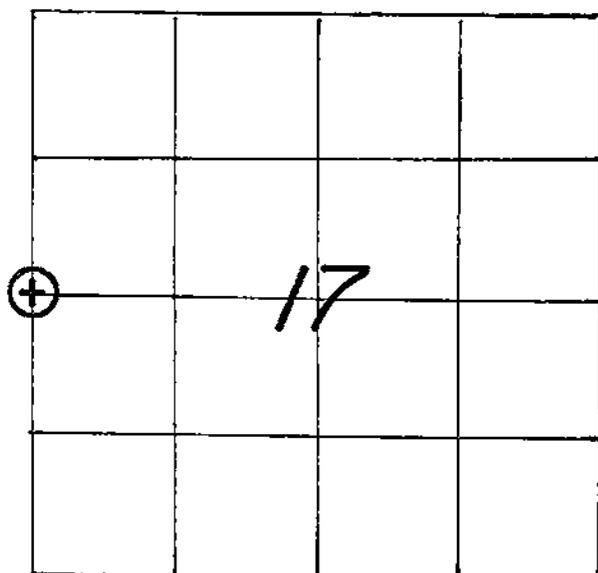

LOCATION OF LANDMARK

CREW: **WILLIAM C. JUNG**
PETER F. FOLLANSBEE
 DATE: **12/18/2003**

WISCONSIN COORDINATE SYSTEM

North **712,228.8652**East **1,702,159.6946**

Theta Angle

Horiz. Order

Vert. Order

DATUM: **1983('91)**

TYPE OF LANDMARK

3/4" x 30" IRON BAR WITH AN ALUMINUM CAP.

BEARINGS ARE REFERENCED TO

GRID NORTH AS PER SECTION DATA.

Describe any record evidence, monument evidence, testimonial evidence or any other material evidence you considered and whether the monument was found or restored through acceptance of an obliterated evidence location.

After searching at length for evidence of the original government survey and finding none, I set the corner "by law" at the single proportionate position. I set an iron bar with a cap at the corner. I found two stumps that were suspicious, but they proved to be too small. The occupied corner at the W1/16NW supports the placing of the 1/4 corner as I did.

Describe or show any material discrepancy between the location of the restored corner and that of the corner previously restored or reestablished.

NONE KNOWN.

