


U. S. PUBLIC LAND SURVEY MONUMENT RECORD

SECTION 30 T 17 N, R 5 W, TOWN OF BURNS
 LA CROSSE COUNTY

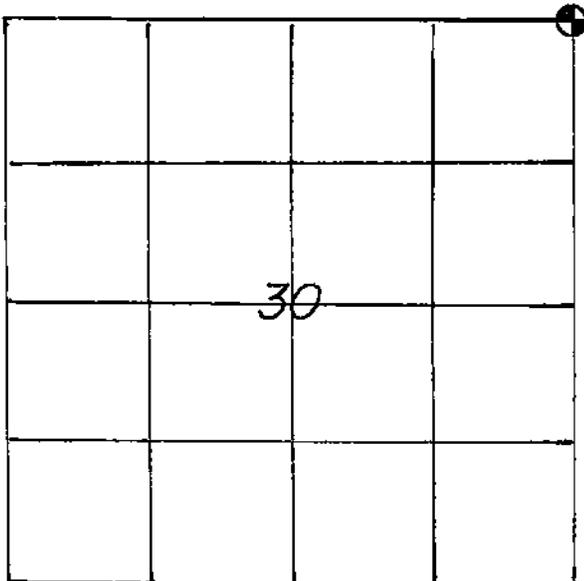

LOCATION OF LANDMARK

WISCONSIN COORDINATE SYSTEM
North
East
Theta Angle
Horiz. Order
Vert. Order
TYPE OF LANDMARK
BRASS CAPPED LUNDE MARKER
BEARINGS ARE REFERENCED TO TRUE

CREW: BILL JUNG
 PERRY DAHL
 DATE: 6-26-86

Describe any record evidence, monument evidence, testimonial evidence or any other material evidence you considered and whether the monument was found or restored through acceptance of an obliterated evidence location.

I accepted the occupied corner as the best available evidence of the original government corner position and monumented the corner with a Lunde marker.


Describe or show any material discrepancy between the location of the restored corner and that of the corner previously restored or reestablished.

None Known

RECORD OF DURABLE WITNESS MONUMENTS

MAGNETIC

NO	DESCRIPTION	BEARING	DISTANCE
1	P.K. NAIL IN DOUBLE-BLAZED TRIPLE OAK TREE	N23°E	47.43'
2	P.K. NAIL IN 10" DOUBLE-BLAZED OAK TREE	N56°E	30.84'
3	CENTER OF 3" UNBLAZED HICKORY	N29°E	3.3'
4	P.K. NAIL IN 11" DOUBLE-BLAZED HICKORY TREE	N67°E	6.24'

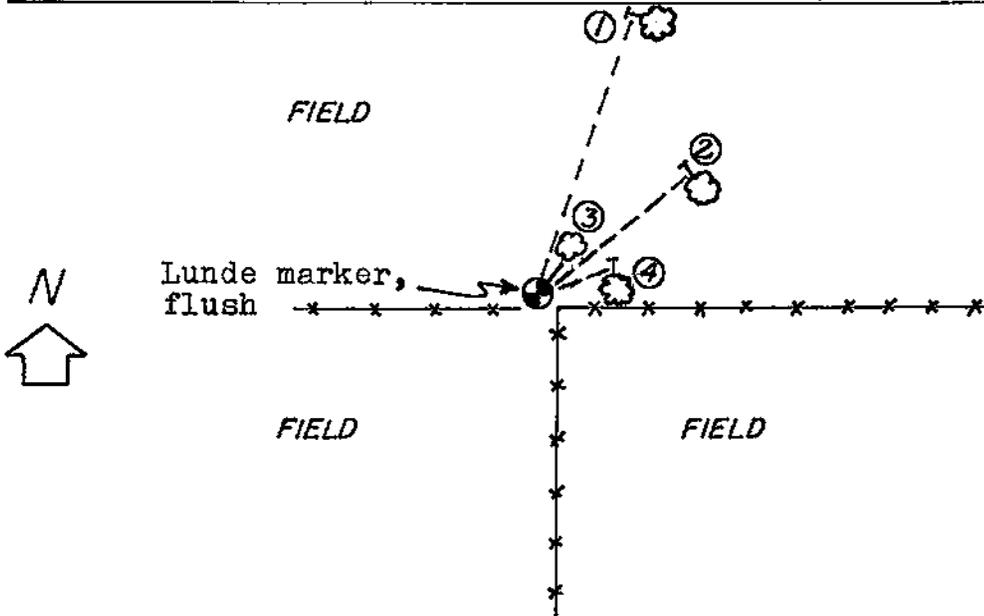


NO SCALE

PLAN VIEW DRAWING OF REFERENCE TIES



MAP SHOWING DISTANCE AND DIRECTION TO OTHER PUBLIC LAND SURVEY CORNERS USED FOR REESTABLISHING THE CORNER

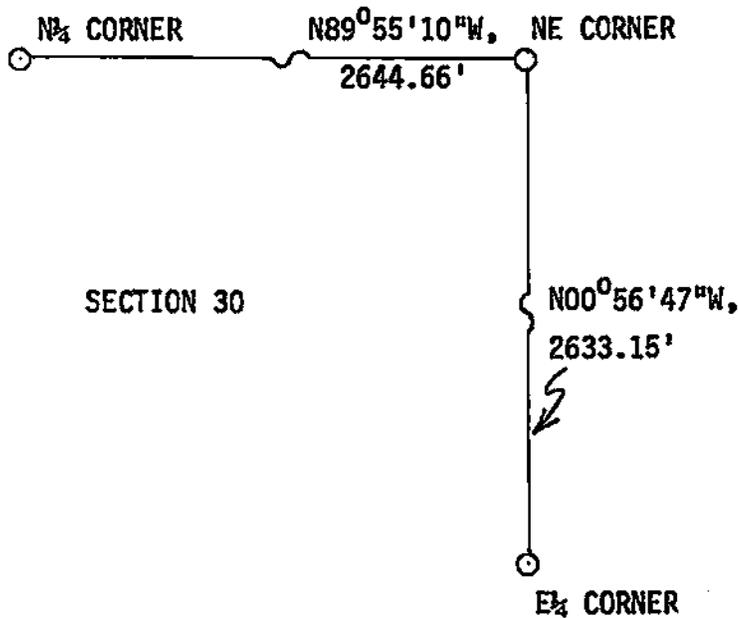

NO SCALE

I, WILLIAM C. JUNG, DEPUTY COUNTY SURVEYOR
 HEREBY CERTIFY THAT THE CORNER LOCATION SHOWN ON THIS RECORD
 WAS DETERMINED BY ME OR UNDER MY DIRECTION AND CONTROL AND
 THAT THIS U. S. PUBLIC LAND SURVEY MONUMENT RECORD IS CORRECT
 AND COMPLETE TO THE BEST OF MY KNOWLEDGE AND BELIEF.

William C. Jung
 Signature

8-11-86
 Date



Seal