


21705190020

U. S. PUBLIC LAND SURVEY MONUMENT RECORD

SECTION 30 T 17 N, R 5 W, TOWN OF BURNS

LA CROSSE COUNTY

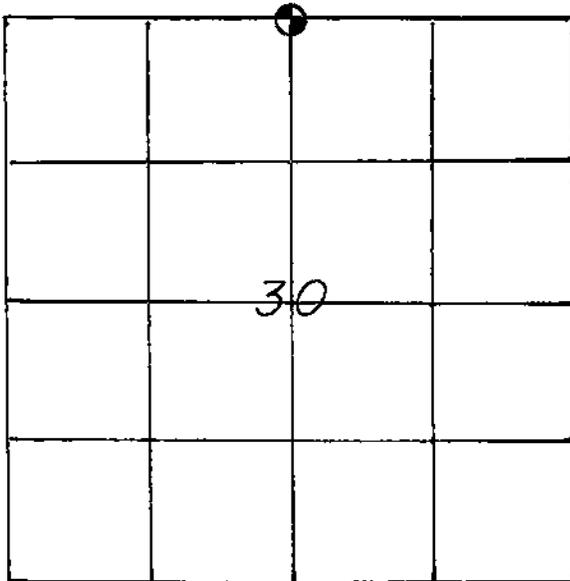

LOCATION OF LANDMARK

CREW: BILL JUNG
PERRY DAHL

DATE 6-9-86

Describe any record evidence, monument evidence, testimonial evidence or any other material evidence you considered and whether the monument was found or restored through acceptance of an obliterated evidence location.

I set the corner in the old East-West fence where I found evidence of old occupation. My section computations show this location fits the section occupation and proration in regard to the original notes.

On April 4, 1990, we found the top half of the old Lunde broken off and plowed out, both reference pipes plowed out, and the old line fence removed. We set a new Lunde, flush with the ground. It was set by using the position occupied by the old bottom half which was buried and O.K.

Describe or show any material discrepancy between the location of the restored corner and that of the corner previously restored or reestablished.

None Known

WISCONSIN COORDINATE SYSTEM

North

East

Theta Angle

Horiz. Order

Vert. Order

TYPE OF LANDMARK


LUNDE MARKER WITH BRASS CAP

BEARINGS ARE REFERENCED TO
TRUECrew: William C. Jung
Peter F. Follansbee

Date: 4-4-90

RECORD OF DURABLE WITNESS MONUMENTS

NO	DESCRIPTION	BEARING	DISTANCE
1	1" Iron Pipe, below plow depth (reset I.P.)	West ±	33.53'
2	1" Iron Pipe " "	East ±	32.74'
3			
4			

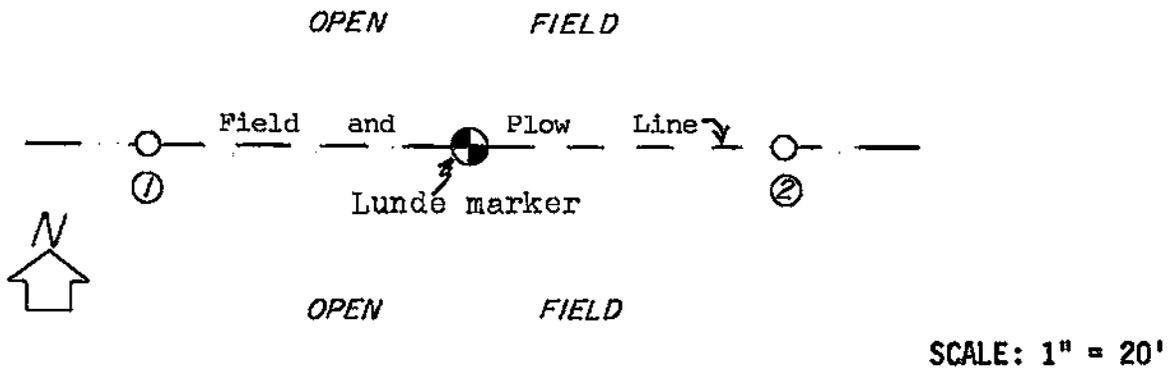


Note: The old Lunde bottom was buried on the West side of the new marker. Set a sign and post West of the marker.

PLAN VIEW DRAWING OF REFERENCE TIES

MAP SHOWING DISTANCE AND DIRECTION TO OTHER PUBLIC LAND SURVEY CORNERS USED FOR REESTABLISHING THE CORNER

NO SCALE

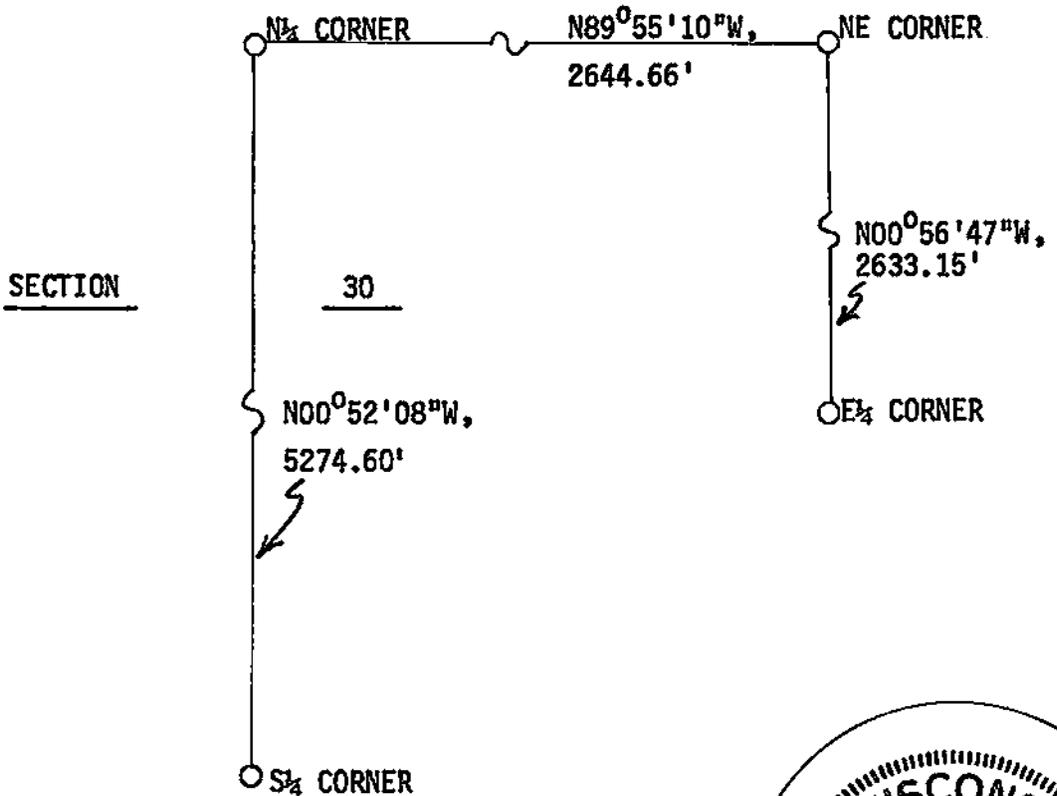

I, William C. Jung, Deputy County Surveyor

HEREBY CERTIFY THAT THE CORNER LOCATION SHOWN ON THIS RECORD WAS DETERMINED BY ME OR UNDER MY DIRECTION AND CONTROL AND THAT THIS U. S. PUBLIC LAND SURVEY MONUMENT RECORD IS CORRECT AND COMPLETE TO THE BEST OF MY KNOWLEDGE AND BELIEF.

William C. Jung
Signature

8-11-86
Date

Revised: 2-12-91 *awcy*



Seal