


21705192000

## U. S. PUBLIC LAND SURVEY MONUMENT RECORD

SECTION 19 T 17 N, R 5 W, TOWN OF BURNS

LA CROSSE COUNTY

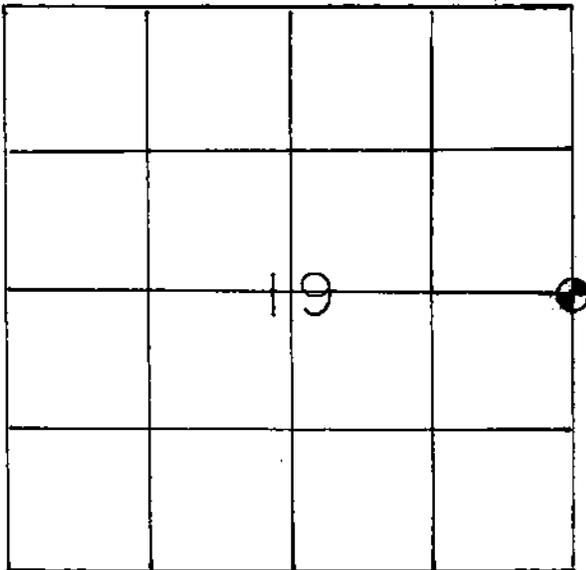

LOCATION OF LANDMARK

CREW: BILL JUNG AND PERRY DAHL  
DATE: 9-23-86

## WISCONSIN COORDINATE SYSTEM

North

East

Theta Angle

Horiz. Order

Vert. Order

## TYPE OF LANDMARK

BRASS CAPPED LUNDE MARKER

## BEARINGS ARE REFERENCED TO

True

Describe any record evidence, monument evidence, testimonial evidence or any other material evidence you considered and whether the monument was found or restored through acceptance of an obliterated evidence location.


I set the corner so as to fit the North-South line fences and the old deeds. The 1/2 mile to the South is longer than that to the North, but this location fits the occupation very well. The fence 1/4 of a mile to the South fits the bearing 1/2 mile to the South almost exactly. I accepted this location as the best available evidence of the original government corner position and monumented it with a Lunde marker.

Describe or show any material discrepancy between the location of the restored corner and that of the corner previously restored or reestablished.


None known.

RECORD OF DURABLE WITNESS MONUMENTS  
MAGNETIC

NO	DESCRIPTION	BEARING	DISTANCE
1	1" IRON PIPE	N1°W	125.4'
2	SET NAIL IN UNBLAZED BURR OAK (34")	S83°W	240.65'
3	1" IRON PIPE	S5°E	68.00'
4			

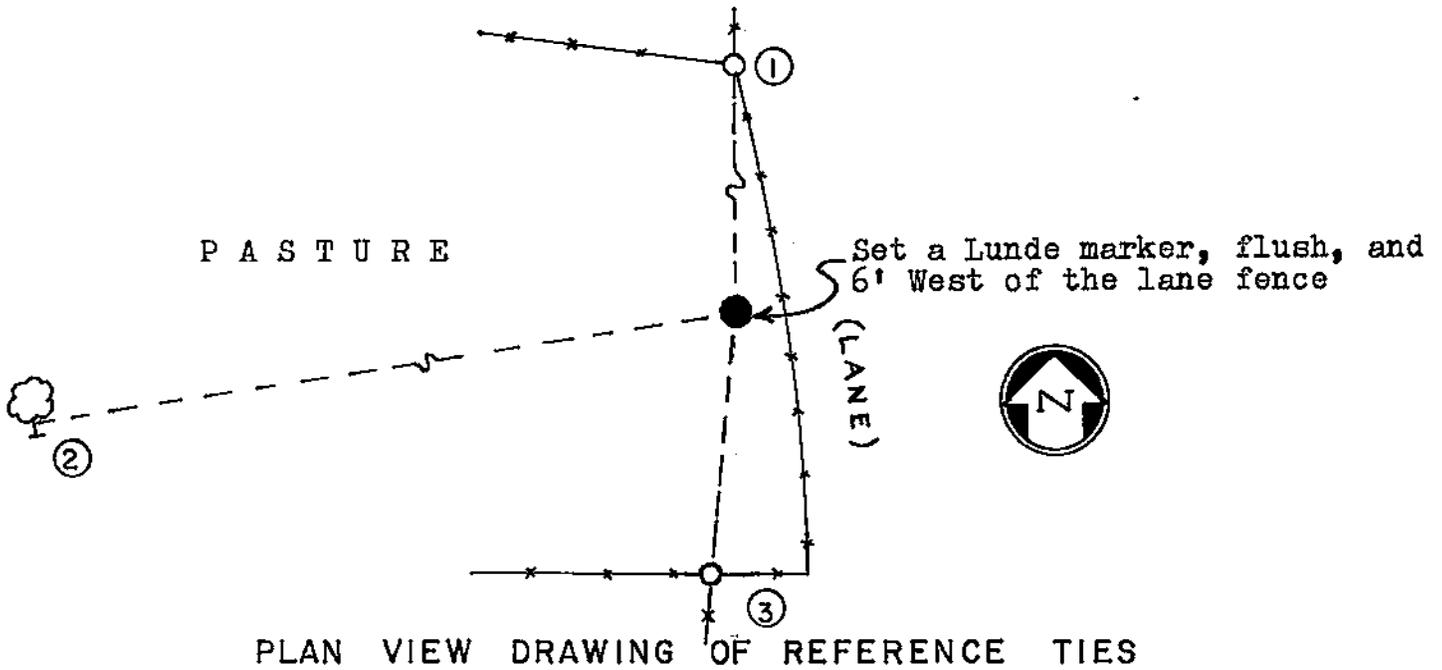

MAP SHOWING DISTANCE AND DIRECTION TO OTHER PUBLIC LAND SURVEY CORNERS USED FOR REESTABLISHING THE CORNER  
(Not to scale)

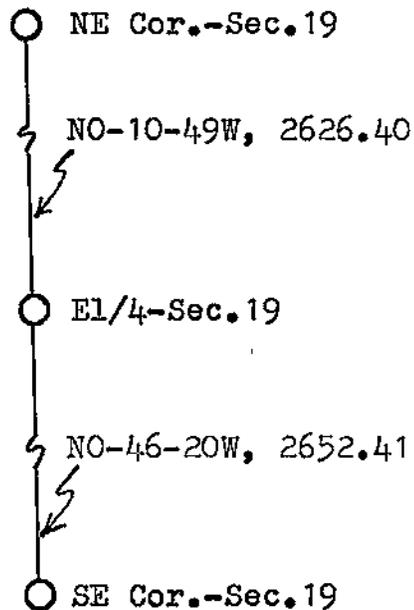

I, William C. Jung, Deputy County Surveyor,  
HEREBY CERTIFY THAT THE CORNER LOCATION SHOWN ON THIS RECORD  
WAS DETERMINED BY ME OR UNDER MY DIRECTION AND CONTROL AND  
THAT THIS U. S. PUBLIC LAND SURVEY MONUMENT RECORD IS CORRECT  
AND COMPLETE TO THE BEST OF MY KNOWLEDGE AND BELIEF.

William C. Jung  
Signature

December 10, 1986  
Date

