


21705200020

U. S. PUBLIC LAND SURVEY MONUMENT RECORD

SECTION 20 T 17 N, R 5 W, TOWN OF BURNS

LA CROSSE COUNTY

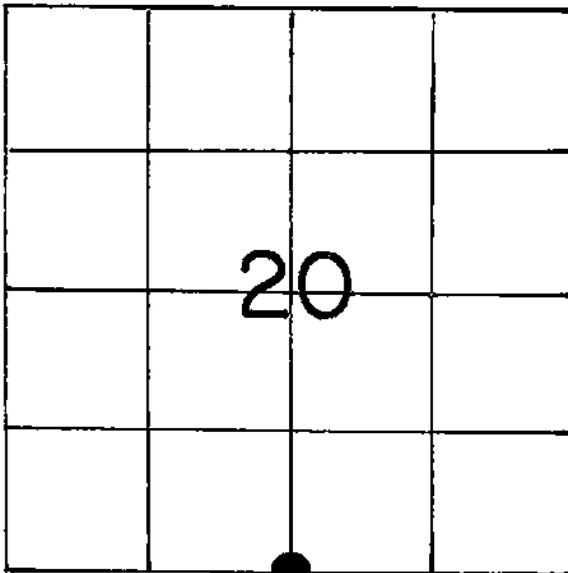

LOCATION OF LANDMARK

Crew: William C. Jung
Peter Follansbee

Date: 1/29/90

Crew: William C. Jung
Peter F. Follansbee

Date: 9/25/92

Describe any record evidence, monument evidence, testimonial evidence or any other material evidence you considered and whether the monument was found or restored through acceptance of an obliterated evidence location.

I accepted the occupied fence corner as the best available evidence of the original government corner position and monumented it with an iron pipe.

On 9/25/92 Pete and I replaced the pipe with a brass capped Lunde marker. A post with sign was set near the corner and a beer bottle and wine bottle with shell casing were buried with the Lunde.

Describe or show any material discrepancy between the location of the restored corner and that of the corner previously restored or reestablished.

None known.

WISCONSIN COORDINATE SYSTEM

North

East

Theta Angle

Horiz. Order

Vert. Order


TYPE OF LANDMARK Lunde marker
Set ~~1"x30"~~ iron pipe on South side
of post

BEARINGS ARE REFERENCED TO

True

RECORD OF DURABLE WITNESS MONUMENTS


NO	DESCRIPTION	BEARING	DISTANCE
1	P.K. in unblazed 5" burr oak	North±	31.20
2	To center of steel post for bird house	"	12.18
3	Set 1"x30" iron pipe	East±	14.45
4	P.K. in unblazed 36" burr oak	-----	24.55

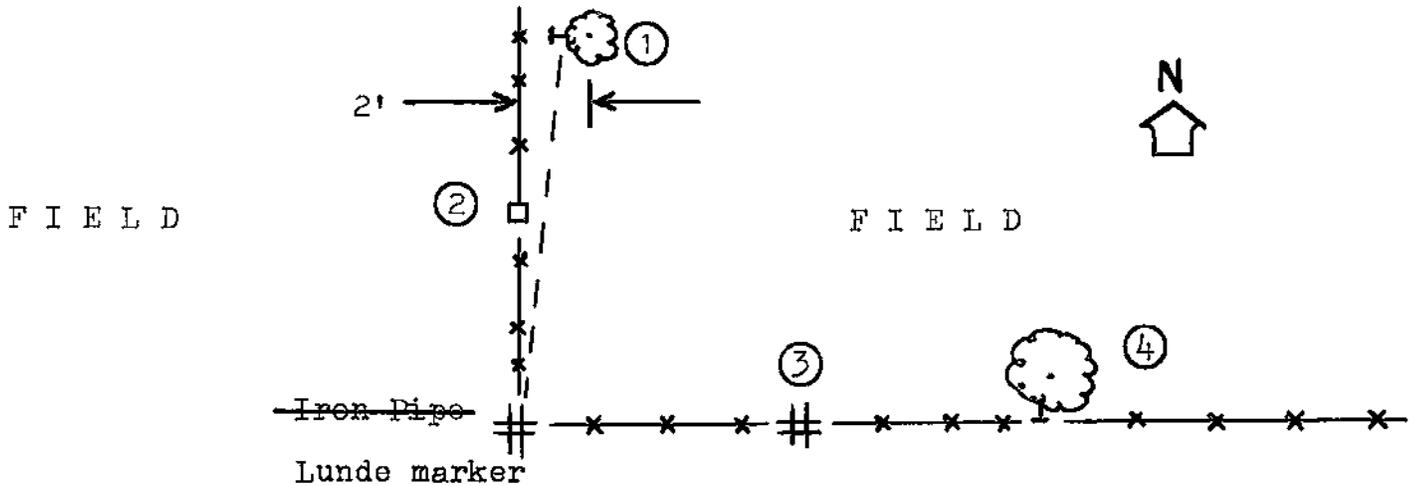

FIELD (not to scale)
 PLAN VIEW DRAWING OF REFERENCE TIES.

MAP SHOWING DISTANCE AND DIRECTION TO OTHER PUBLIC LAND SURVEY CORNERS USED FOR REESTABLISHING THE CORNER

(not to scale)

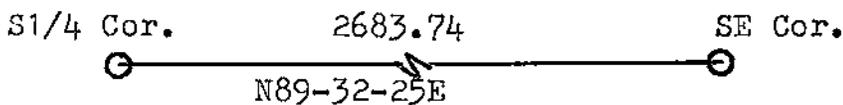


I, William C. Jung, Deputy County Surveyor,
 HEREBY CERTIFY THAT THE CORNER LOCATION SHOWN ON THIS RECORD
 WAS DETERMINED BY ME OR UNDER MY DIRECTION AND CONTROL AND
 THAT THIS U. S. PUBLIC LAND SURVEY MONUMENT RECORD IS CORRECT
 AND COMPLETE TO THE BEST OF MY KNOWLEDGE AND BELIEF.

William C. Jung
 Signature

March 6, 1990

Date Revised: 12/29/98
 awc

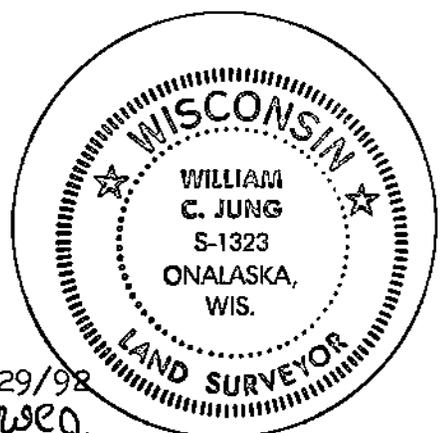

Seal