


21705220000

U. S. PUBLIC LAND SURVEY MONUMENT RECORD

SECTION 27 T 17 N, R 5 W, TOWN OF BURNS

LA CROSSE COUNTY

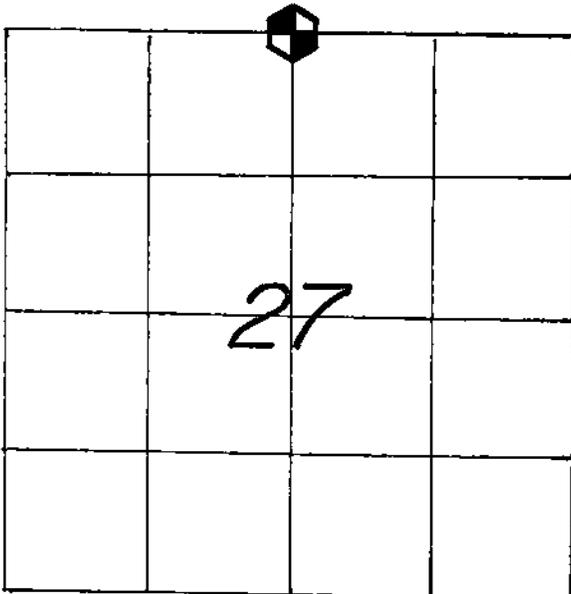

LOCATION OF LANDMARK

CREW: **WILLIAM C. JUNG**
PETER F. FOLLANSBEE
 DATE: **8/01/2003**

WISCONSIN COORDINATE SYSTEM	
North	704,219.398
East	1,715,463.113
Theta Angle	
Horiz. Order	
Vert. Order	
DATUM: 1983 ('91)	
TYPE OF LANDMARK	
BRASS CAP LUNDE MARKER.	
BEARINGS ARE REFERENCED TO	
GRID NORTH AS PER SECTION DATA.	

Describe any record evidence, monument evidence, testimonial evidence or any other material evidence you considered and whether the monument was found or restored through acceptance of an obliterated evidence location.

I computed out a location for this corner based on the evidence that I found while surveying in Sections 21,22,23,27, and 28. The corner location fits this evidence, particularly the fences that we found in the SW1/4 of Section 22. I do not agree with the North-South fence that I found to the East. A brass capped Lunde marker was set at the corner.


Describe or show any material discrepancy between the location of the restored corner and that of the corner previously restored or reestablished.

NONE KNOWN.

RECORD OF DURABLE WITNESS MONUMENTS


NO	DESCRIPTION	MAGNETIC BEARING	DISTANCE
1	SET A NAIL IN N.W.-SIDE OF AN 18" ASPEN	S 24° W	18.96 FT.
2	SET A NAIL IN N.-SIDE OF A 21" OAK	WEST ±	7.66 FT.
3	SET A NAIL IN S.W.-SIDE OF A 5" NUT TREE	S 60° E	14.13 FT.
4	SET A NAIL IN S.W.-SIDE OF A 5-1/2" NUT TREE	S 43° E	20.88 FT.

(NOTE: THE FOUR BEARING TREES ARE DOUBLE BLAZED.)

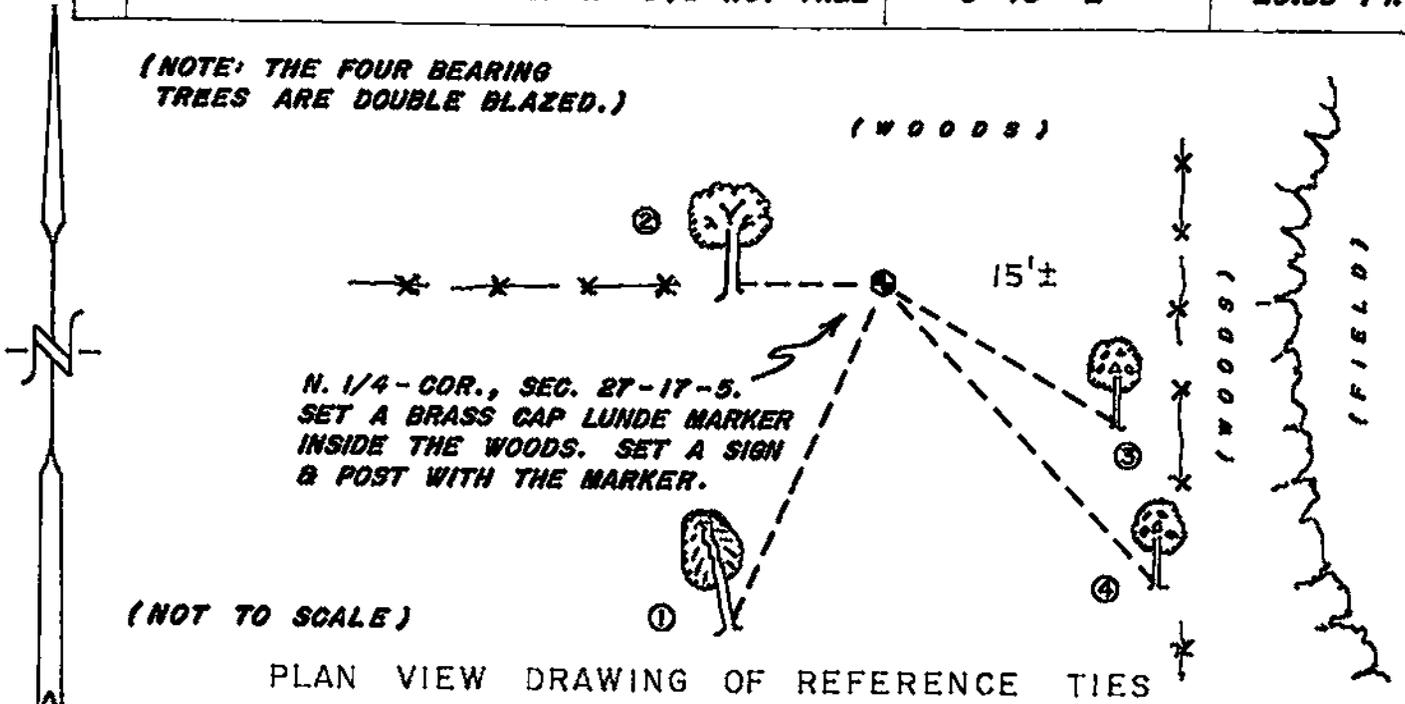

MAP SHOWING DISTANCE AND DIRECTION TO OTHER PUBLIC LAND SURVEY CORNERS USED FOR REESTABLISHING THE CORNER

(GRID BEARINGS & DISTANCES)
(GRID FACTOR: 0.999937)
(NOT TO SCALE)

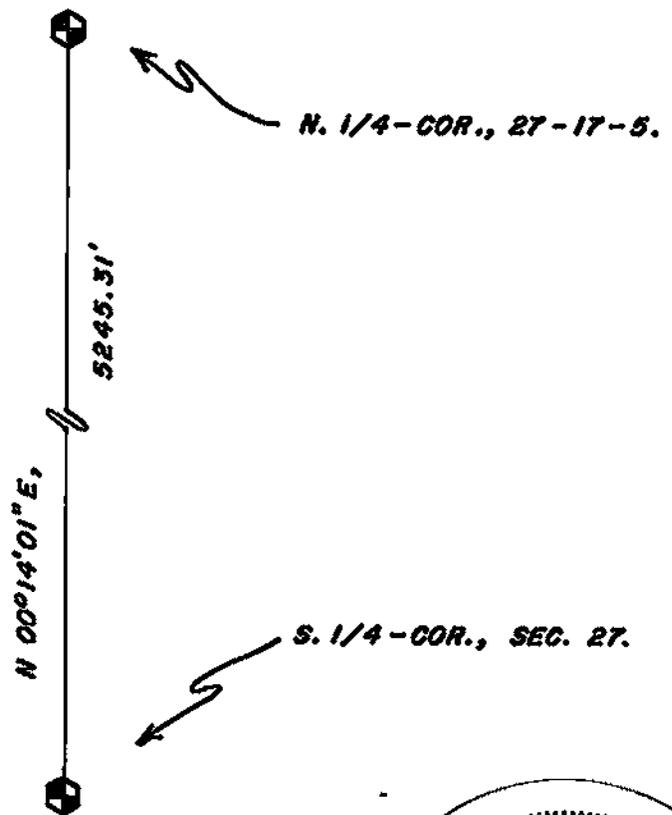

I, WILLIAM C. JUNG, COUNTY SURVEYOR
HEREBY CERTIFY THAT THE CORNER LOCATION SHOWN ON THIS RECORD
WAS DETERMINED BY ME OR UNDER MY DIRECTION AND CONTROL AND
THAT THIS U. S. PUBLIC LAND SURVEY MONUMENT RECORD IS CORRECT
AND COMPLETE TO THE BEST OF MY KNOWLEDGE AND BELIEF.

William C. Jung 1/29/04
Signature Date



Seal