


21705222000

U. S. PUBLIC LAND SURVEY MONUMENT RECORD

SECTION 23 T 17 N, R 5 W, TOWN OF Burns

LA CROSSE COUNTY

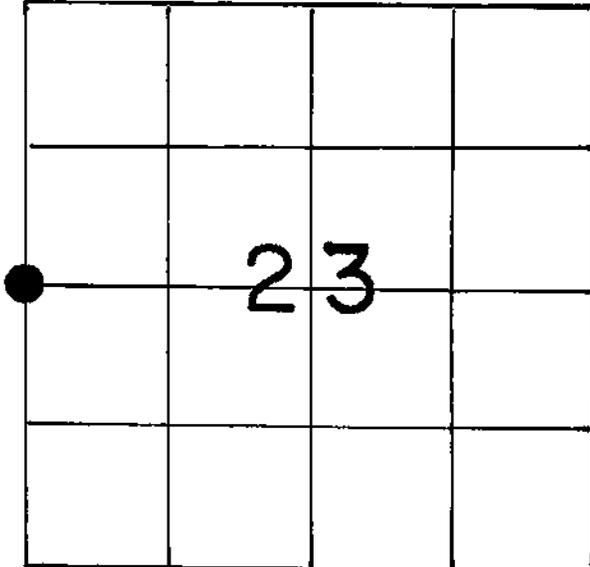

LOCATION OF LANDMARK

Crew: William C. Jung
Peter Follansbee

Date: December 1, 1989

WISCONSIN COORDINATE SYSTEM

North

East

Theta Angle

Horiz. Order

Vert. Order

TYPE OF LANDMARK

Brass capped Lunde marker

BEARINGS ARE REFERENCED TO

Describe any record evidence, monument evidence, testimonial evidence or any other material evidence you considered and whether the monument was found or restored through acceptance of an obliterated evidence location.


Gary Sime and I set an iron bar at the occupied corner in May of 1984. I accepted this position as the best available evidence of the original government corner position. I removed the iron bar and replaced it with a brass capped Lunde marker.

Describe or show any material discrepancy between the location of the restored corner and that of the corner previously restored or reestablished.

None known.

RECORD OF DURABLE WITNESS MONUMENTS
MAGNETIC

NO	DESCRIPTION	BEARING	DISTANCE
1	To P.K. nail in single blazed 12" aspen	N89°W	43.75'
2	" " " " " " 16" double white oak	S 7°E	6.02'
3	" " " " " " 13" white oak	S11°E	slope=37.85' ***
4	" " " " " " 15" white oak	East	slope=21.34'

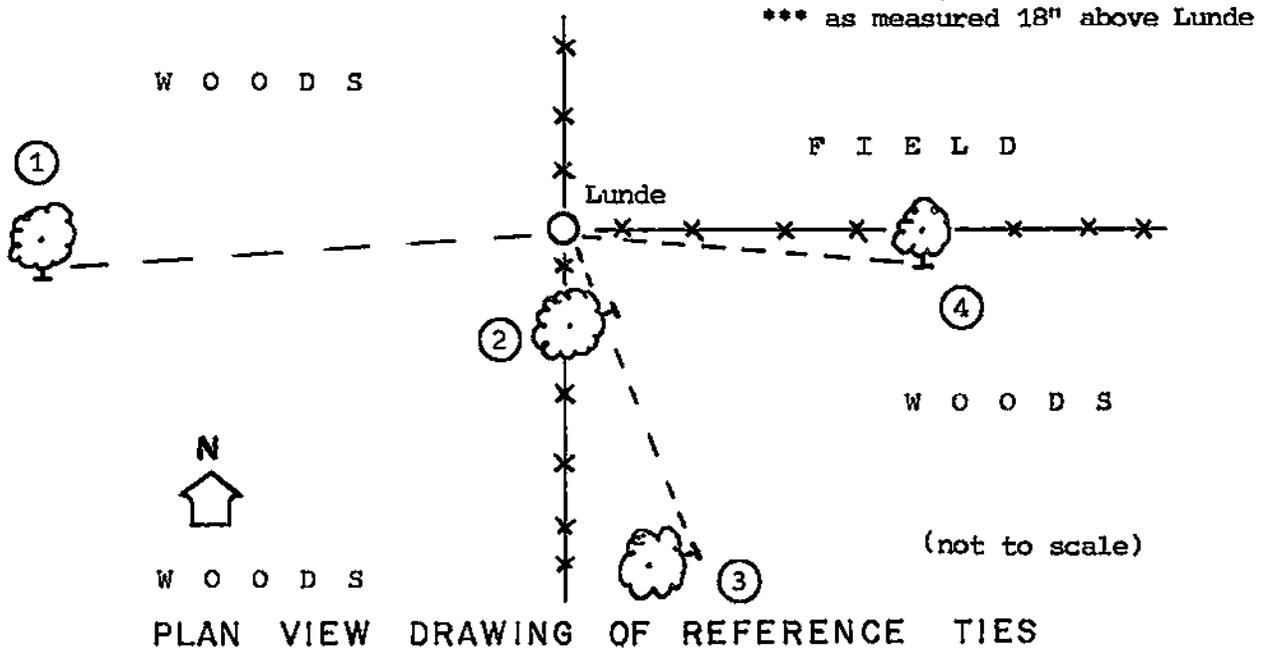


MAP SHOWING DISTANCE AND DIRECTION TO OTHER PUBLIC LAND SURVEY CORNERS USED FOR REESTABLISHING THE CORNER

(no section measurements made by me at this time)

I, William C. Jung, Deputy County Surveyor,
 HEREBY CERTIFY THAT THE CORNER LOCATION SHOWN ON THIS RECORD
 WAS DETERMINED BY ME OR UNDER MY DIRECTION AND CONTROL AND
 THAT THIS U. S. PUBLIC LAND SURVEY MONUMENT RECORD IS CORRECT
 AND COMPLETE TO THE BEST OF MY KNOWLEDGE AND BELIEF.

William C. Jung
 Signature

December 5, 1989
 Date

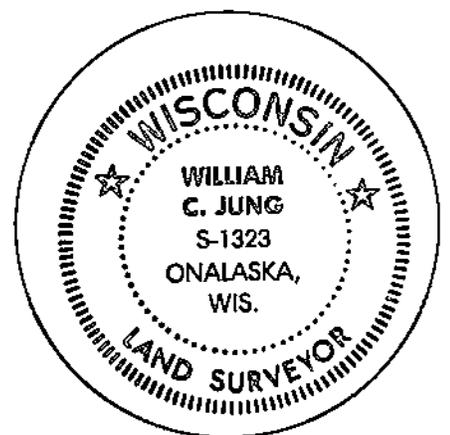

Seal