


21705230000

U. S. PUBLIC LAND SURVEY MONUMENT RECORD

SECTION 23 T 17 N, R 5 W, TOWN OF Burns
 LA CROSSE COUNTY

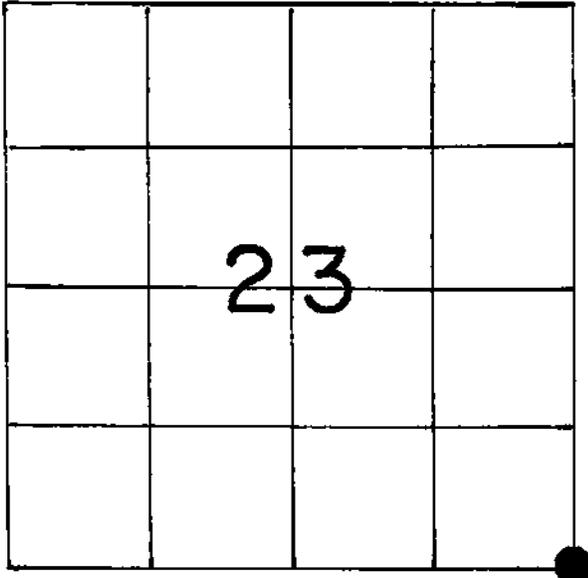

LOCATION OF LANDMARK

Crew: William C. Jung
 Peter Follansbee
 Date: 12/6/89

WISCONSIN COORDINATE SYSTEM
North
East
Theta Angle
Horiz. Order
Vert. Order
TYPE OF LANDMARK
Brass capped Lunde marker
BEARINGS ARE REFERENCED TO

Describe any record evidence, monument evidence, testimonial evidence or any other material evidence you considered and whether the monument was found or restored through acceptance of an obliterated evidence location.


I found what I believe to be the remnants of an original bearing tree and set the corner from this stump. Gary Sime and I agree on this. I set a brass capped Lunde marker at the corner. We found the old tree to the Southeast.

Describe or show any material discrepancy between the location of the restored corner and that of the corner previously restored or reestablished.

None known.

RECORD OF DURABLE WITNESS MONUMENTS
Magnetic

NO	DESCRIPTION	BEARING	DISTANCE
1	P.K. nail in single blazed 13" white oak	N34°W	41.85
2	" " " " " 21" " "	N18°W	24.01
3	" " " " " 14" " "	S70°E	59.32
4	" " " " " 14" " "	S59°E	53.66

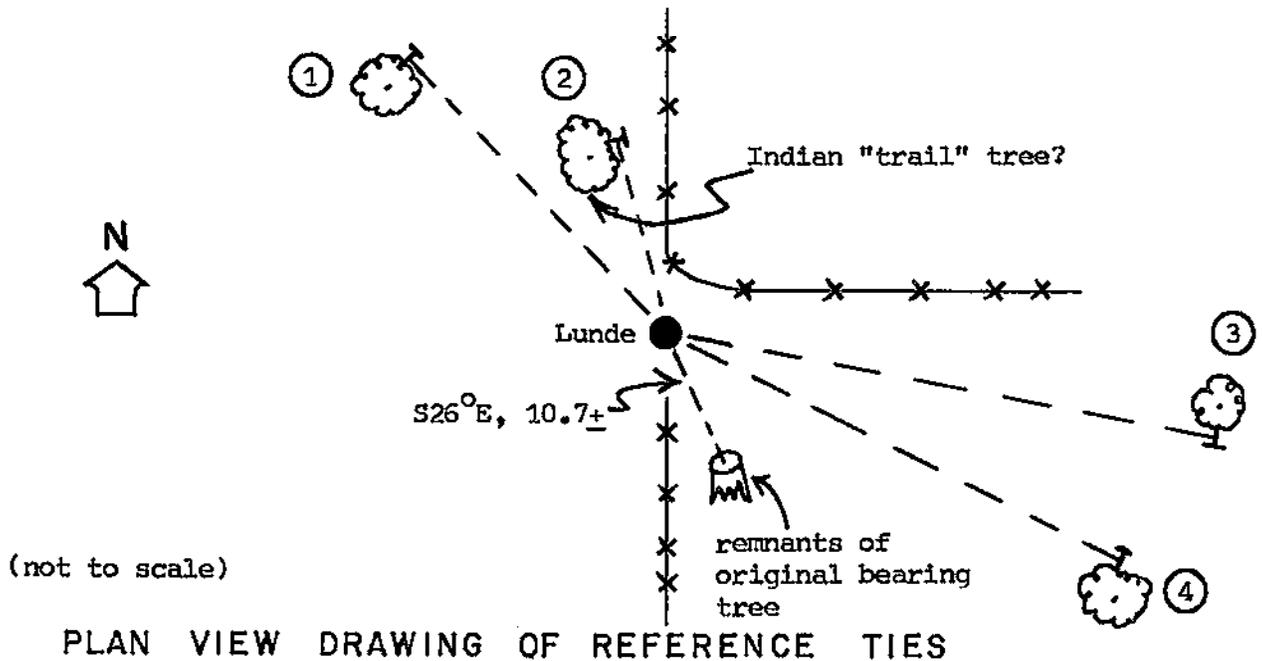

MAP SHOWING DISTANCE AND DIRECTION TO OTHER PUBLIC LAND SURVEY CORNERS USED FOR REESTABLISHING THE CORNER

(no section measurements made by me at this time)

I, William C. Jung, Deputy County Surveyor,
 HEREBY CERTIFY THAT THE CORNER LOCATION SHOWN ON THIS RECORD
 WAS DETERMINED BY ME OR UNDER MY DIRECTION AND CONTROL AND
 THAT THIS U. S. PUBLIC LAND SURVEY MONUMENT RECORD IS CORRECT
 AND COMPLETE TO THE BEST OF MY KNOWLEDGE AND BELIEF.

William C. Jung December 19, 1989
 Signature Date



Seal