


21705232000

U. S. PUBLIC LAND SURVEY MONUMENT RECORD

SECTION 24 T 17 N, R 5 W, TOWN OF BURNS

LA CROSSE COUNTY

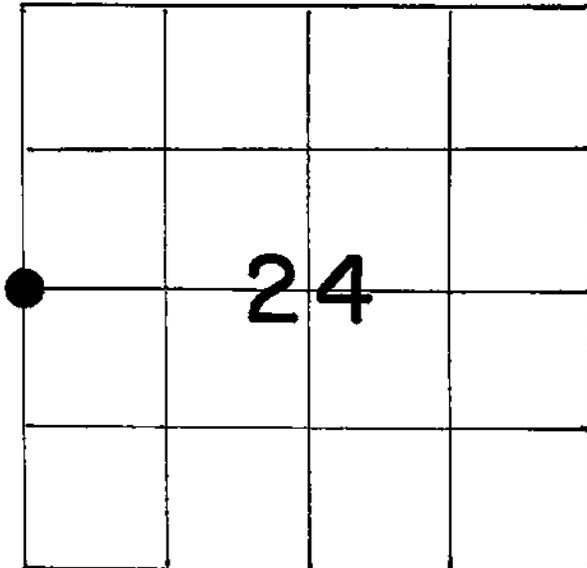

LOCATION OF LANDMARK

Crew: William Jung
Perry Dahl
8/28/85

WISCONSIN COORDINATE SYSTEM
North
East
Theta Angle
Horiz. Order
Vert. Order
TYPE OF LANDMARK BERNTSEN
BEARINGS ARE REFERENCED TO

Describe any record evidence, monument evidence, testimonial evidence or any other material evidence you considered and whether the monument was found or restored through acceptance of an obliterated evidence location.

In May of 1976 Fred Kraft shows an angle iron at this corner. In July of 1980 Gary Sime shows a drag tooth at the corner. I helped him on this survey. I found a 1/2"x2"x28" drag tooth at the corner, removed it, and replaced it with a Berntsen marker. I also found an iron bar, hub, and rotted lathe by the drag tooth. I believe that the old burr oak to the Southeast is the original bearing tree and that the Berntsen is now in the position of the original government corner. The tree checked with the drag tooth.

Describe or show any material discrepancy between the location of the restored corner and that of the corner previously restored or reestablished.

None known.

