

CERTIFICATE

CERTIFIED LAND CORNER

I, Harley A. Sime, do hereby certify that on the 25 day of September 19 75, I found (evidence) (no evidence) of the NW corner of Sec. 30, T 17N, R 4W, Fourth Principal Meridian, and I re-established said corner according to the Wisconsin Statutes as shown and described hereon.

Dated this 5 day of March 19 76.

Harley A. Sime  
COUNTY SURVEYOR  
Title

History of original corner establishment:

Description of corner evidence found:

Accepted the existing field conditions. The aerial photo shows the remaining portion of old Hwy "16" to be on the section line. This location matches the rest of the section well.


Description of corner and witness monuments, references and accessories used to perpetuate the original or re-established location of this corner:

Set Harrison, Down 2"

Witnesses to corner location:

Douglas J. Mallett  
D.J. Mallett Crew Chief BLS



A. Lueck

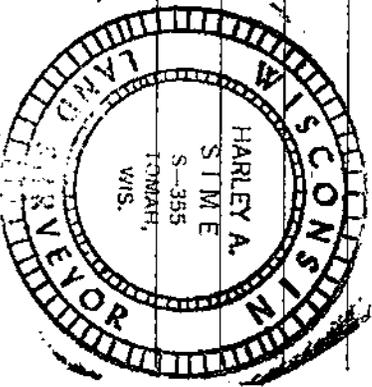

SURVEY CONTROL ORDER

Horizontal \_\_\_\_\_

Vertical \_\_\_\_\_

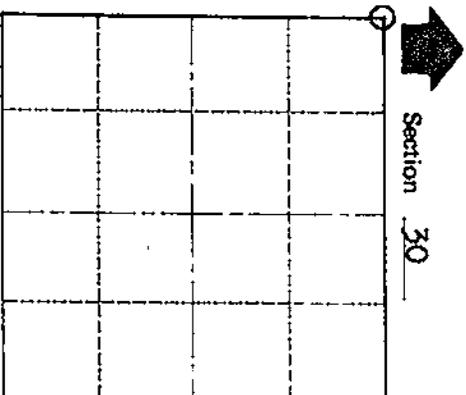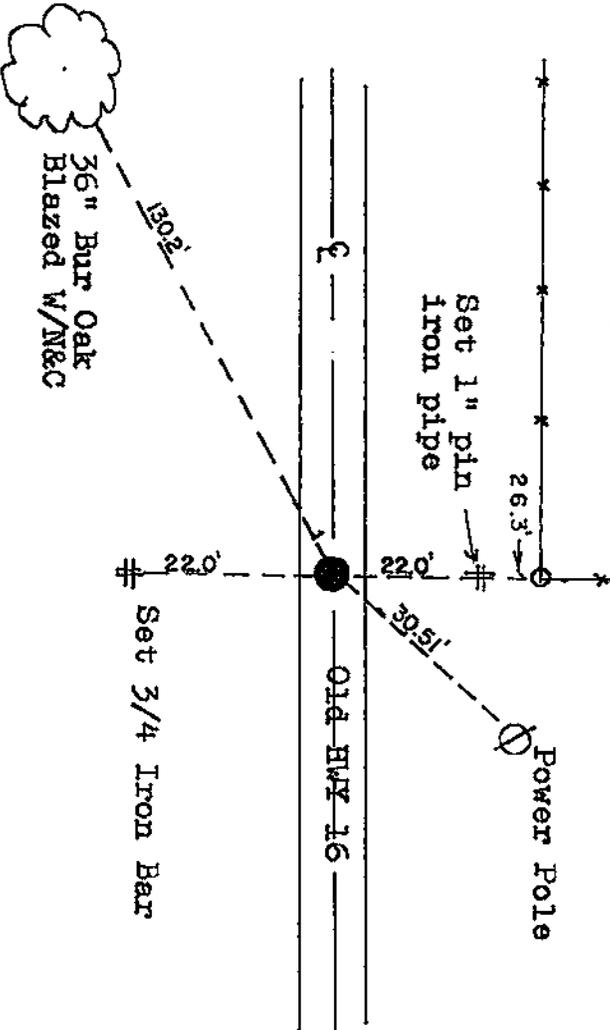

WISCONSIN COORDINATE SYSTEM

Corner	East (X)	North (Y)	Elevation (Z)	Zone
Control Sta. Name				

City, Village or Town Sparta

County of Monroe