


21705242000

U. S. PUBLIC LAND SURVEY MONUMENT RECORD

SECTION 24 T 17 N, R 5 W, TOWN OF BURNS

LA CROSSE COUNTY

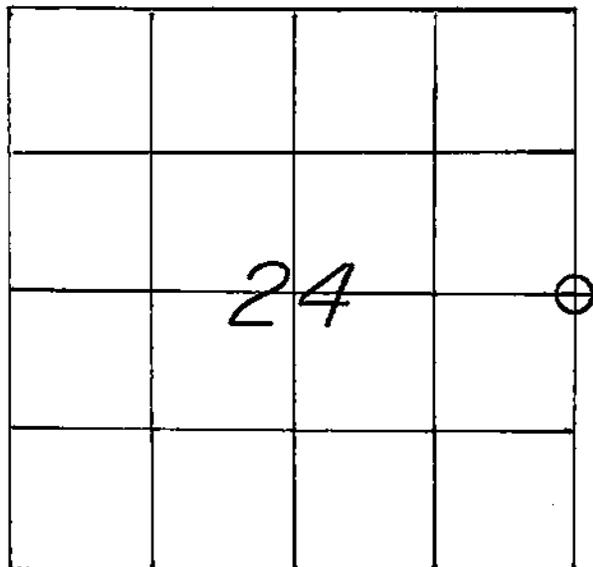

LOCATION OF LANDMARK

Crew: WILLIAM C. JUNG
 PETER F. FOLLANSBEE
 Date: 4/21/1997

WISCONSIN COORDINATE SYSTEM

North

East

Theta Angle

Horiz. Order

Vert. Order

TYPE OF LANDMARK

Existing Harrison marker.

BEARINGS ARE REFERENCED TO

True

Describe any record evidence, monument evidence, testimonial evidence or any other material evidence you considered and whether the monument was found or restored through acceptance of an obliterated evidence location.

I reset the Harrison marker that Malliet set back in 1975.

Describe or show any material discrepancy between the location of the restored corner and that of the corner previously restored or reestablished.

None Known.

CERTIFICATE

CERTIFIED LAND CORNER

I, Harley A. Sims, do hereby certify that on the 25 day of September 19 25 I found (evidence) (no evidence) of the W^{1/2} corner of Sec. 19, T 17 N, R 4W, Fourth Principal Meridian, and I re-established said corner according to the Wisconsin Statutes as shown and described hereon.

Dated this 5 day of March 19 25.

[Signature]
 COUNTY SURVEYOR

History of original corner establishment:

Description of corner evidence found:

Accepted the position of 3-way fence corner as the best available field evidence. The existing field conditions matched well with the remainder of the section.


Description of corner and witness monuments, references and adjacent land to perpetuate the original or re-established location of this corner:

Set Harrison up 3 1/2".

Witnesses to corner location:

County of Monroe
 D.J. Miller - Crew Chief RIS

A. Ineck

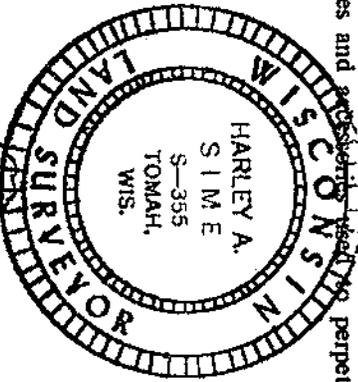

NOTE: All trees blazed and with nail cap

SURVEY CONTROL ORDER

Horizontal _____

Vertical _____

Corner _____
 Control Sta. Name _____

East (X) _____

North (Y) _____

Elevation (Z) _____



Zone _____

WISCONSIN COORDINATE SYSTEM

City, Village or Town _____

Sparta

County of Monroe

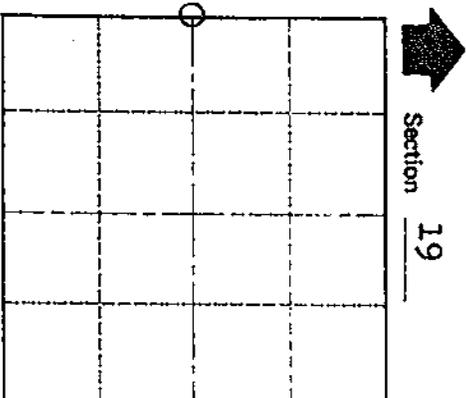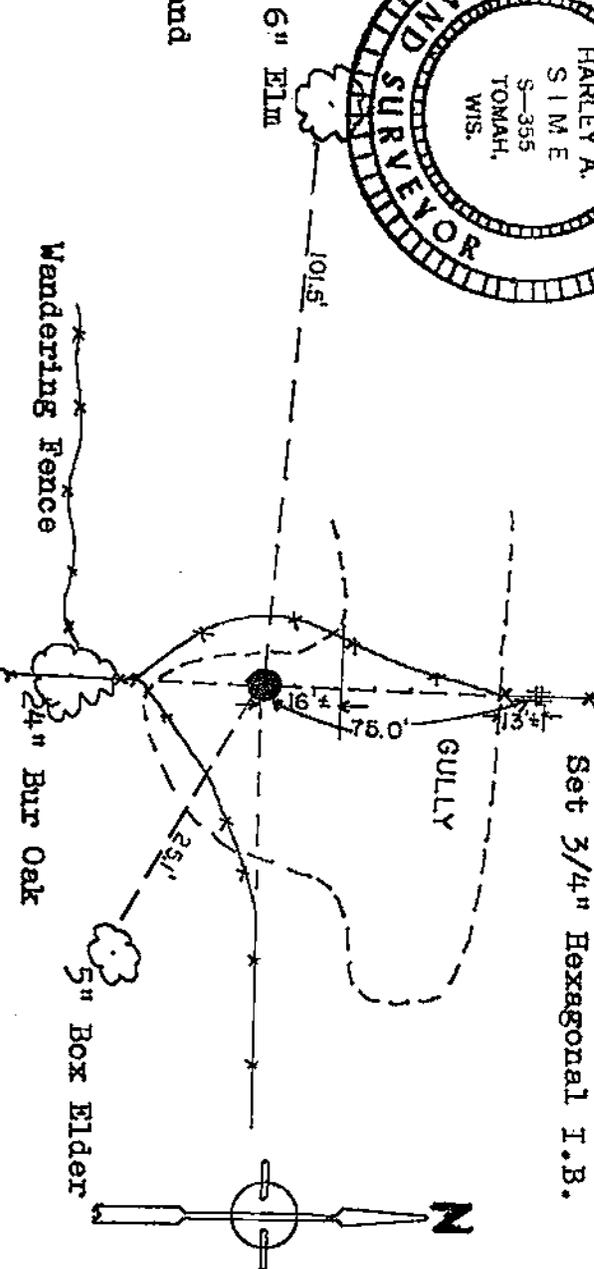

Section 19
 O - LOCATION CORNER
 T 17 N R 4W
 WISCONSIN