

CERTIFICATE

CERTIFIED LAND CORNER

I, Harley A. Sime, do hereby certify that on the 26 day of September, 1975, I found (evidence) (no evidence) of the SW corner of Section 30, T17 N, R4W. Fourth Principal Meridian, and I re-established said corner according to the Wisconsin Statutes as shown and described hereon.

Dated this 5 day of March, 1976.

[Signature]
County Surveyor


History of original corner establishment:

Description of corner evidence found:
Accepted the existing field conditions, the location of a 5-way fence corner as the best available evidence.

Description of corner and witness monuments, references and accessories used to perpetuate the original or re-established location of this corner:

Witnesses to corner location:
[Signature]
D.J. Mallett - Reg. Surveyor

A. Ineck

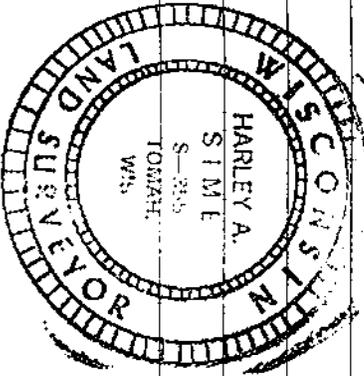

SURVEY CONTROL ORDER

Horizontal

Vertical

Control Sta. Name


East (X)

North (Y)


Elevation (Z)

Zone

WISCONSIN COORDINATE SYSTEM

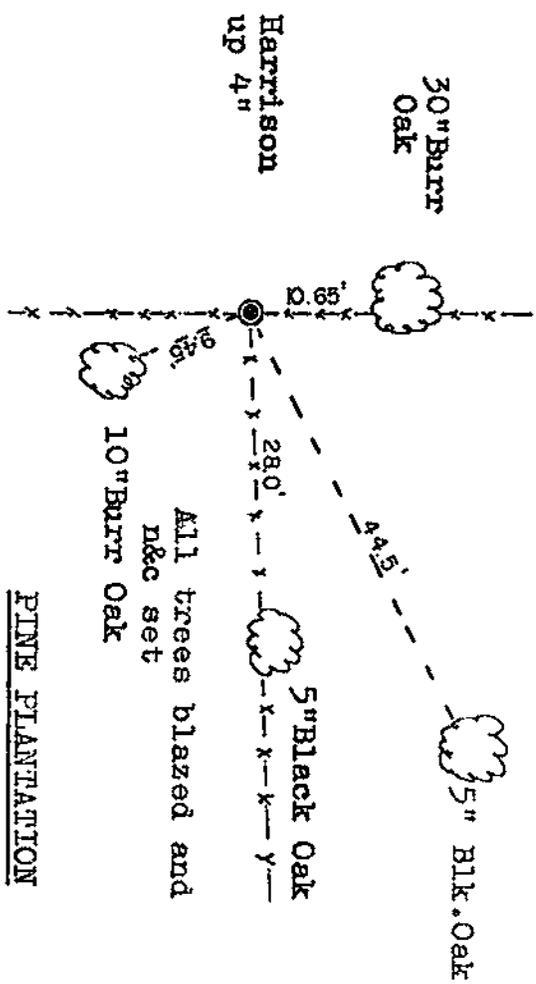

PINE PLANTATION

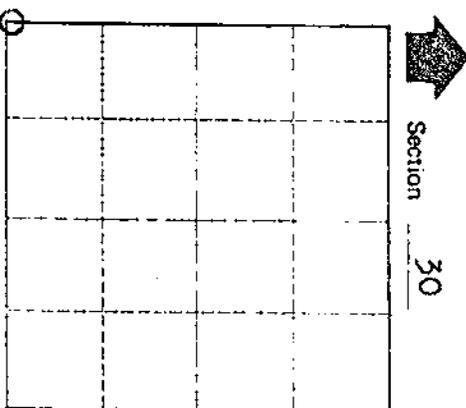

T 17 N R 4W

WISCONSIN

City, Village or Town Sparta

County of Monroe