


21705260020

U. S. PUBLIC LAND SURVEY MONUMENT RECORD

SECTION 26 T 17 N, R 5 W, TOWN OF BURNS

LA CROSSE COUNTY

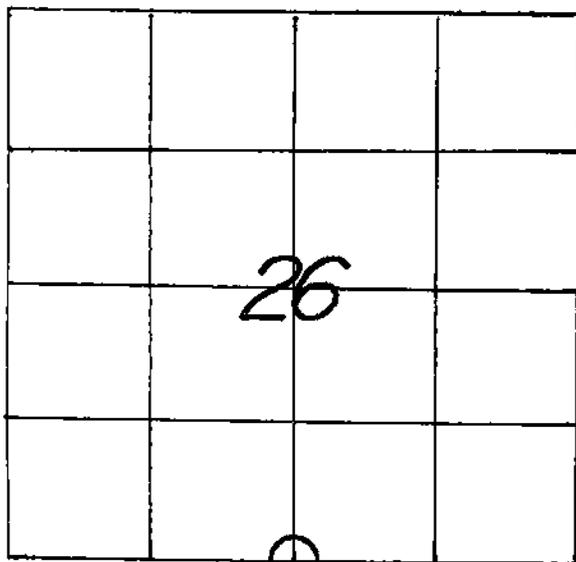

LOCATION OF LANDMARK

CREW: WILLIAM C. JUNG
 PETER F. FOLLANSBEE
 DATE: 11/10/2005

WISCONSIN COORDINATE SYSTEM

North

East

Theta Angle

Horiz. Order

Vert. Order

TYPE OF LANDMARK

2" x 49" IRON PIPE.

BEARINGS ARE REFERENCED TO

ASSUMED NORTH AS PER SECTION DATA.

Describe any record evidence, monument evidence, testimonial evidence or any other material evidence you considered and whether the monument was found or restored through acceptance of an obliterated evidence location.

After surveying out the South line of Section 26, Gary Sime was of the opinion that this corner should be set by single proportionate measurement. I agreed. I set the corner at this position using Gary's survey points and coordinates. As set, the pipe appears to be pretty much on line with old fence remnants to the North and South.


Describe or show any material discrepancy between the location of the restored corner and that of the corner previously restored or reestablished.

NONE KNOWN.

RECORD OF DURABLE WITNESS MONUMENTS


ASSUMED

| NO | DESCRIPTION | BEARING | DISTANCE |
|----|--|---------------|------------|
| 1 | SET A 3/4" x 30" IRON BAR WITH A RED PLASTIC CAP | N 08°32'38" W | 59.46 FT. |
| 2 | SET A 3/4" x 30" IRON BAR WITH A RED PLASTIC CAP | N 79°57'02" W | 79.56 FT. |
| 3 | SET A 3/4" x 30" IRON BAR WITH A RED PLASTIC CAP | S 53°08'34" W | 98.78 FT. |
| 4 | EXISTING IRON BAR 8'± WEST OF A NEWER PASTURE FENCE S 6°50'48" W | S 6°50'48" W | 126.05 FT. |

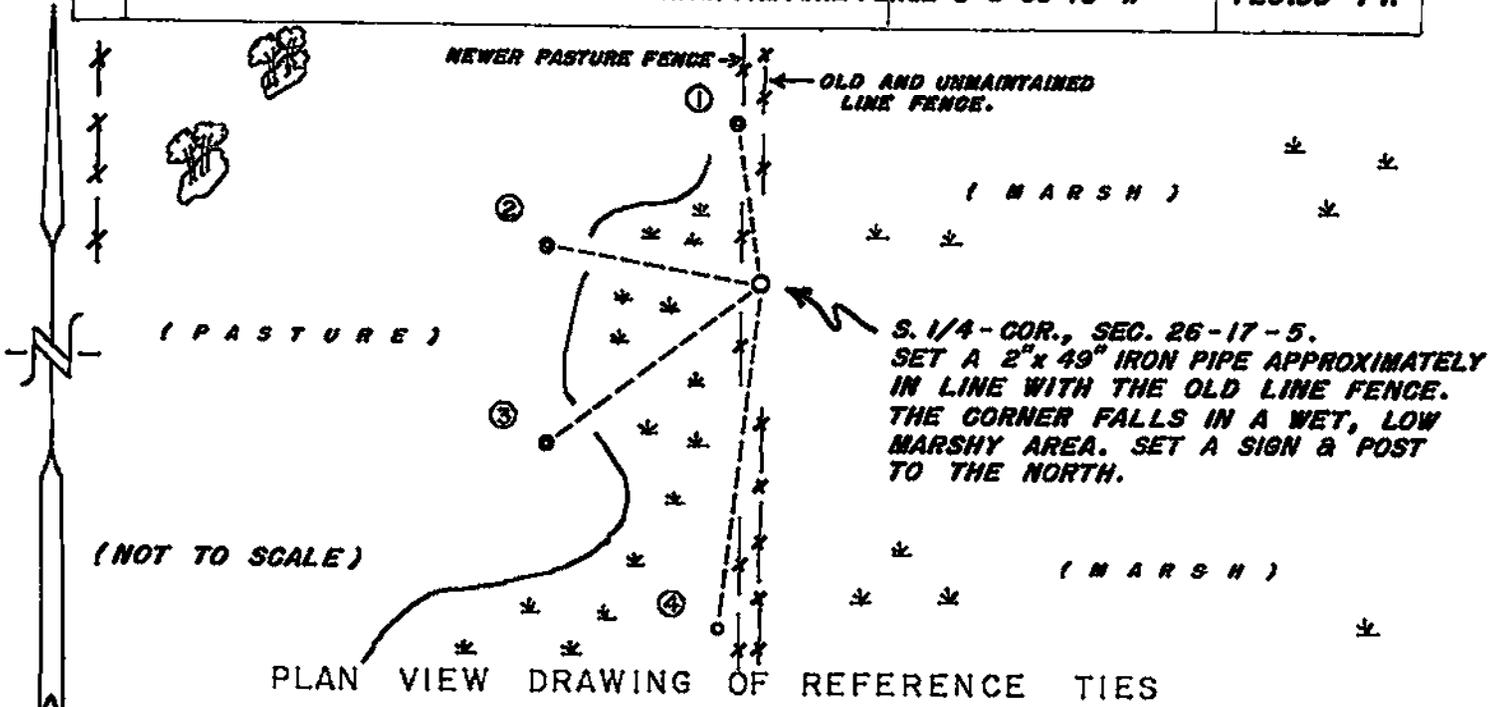

MAP SHOWING DISTANCE AND DIRECTION TO OTHER PUBLIC LAND SURVEY CORNERS USED FOR REESTABLISHING THE CORNER

(G.A. SIME MEASUREMENTS)
(ASSUMED NORTH)
(NOT TO SCALE)

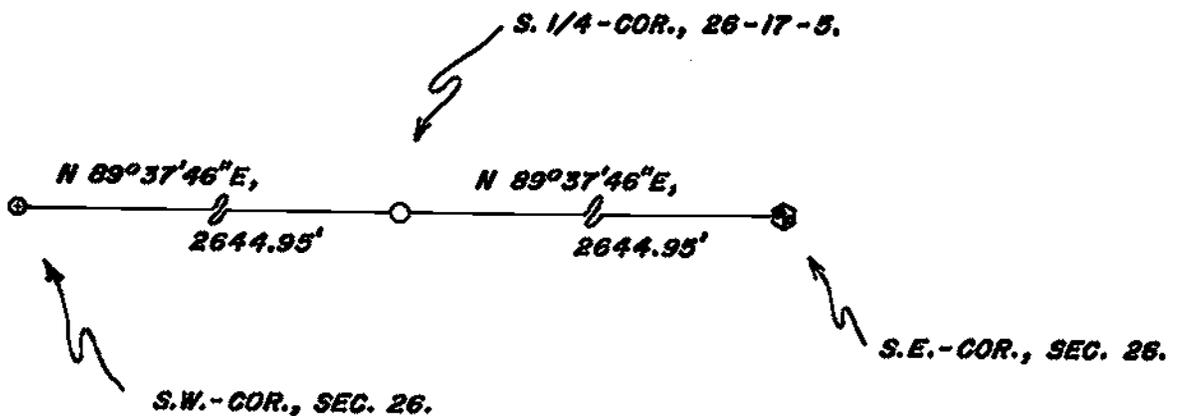

I, WILLIAM C. JUNG, COUNTY SURVEYOR
HEREBY CERTIFY THAT THE CORNER LOCATION SHOWN ON THIS RECORD WAS DETERMINED BY ME OR UNDER MY DIRECTION AND CONTROL AND THAT THIS U. S. PUBLIC LAND SURVEY MONUMENT RECORD IS CORRECT AND COMPLETE TO THE BEST OF MY KNOWLEDGE AND BELIEF.

William C. Jung 12/9/05
Signature Date



Seal