


U. S. PUBLIC LAND SURVEY MONUMENT RECORD

SECTION 26 T 17 N, R 5 W, TOWN OF BURNS  
 LA CROSSE COUNTY

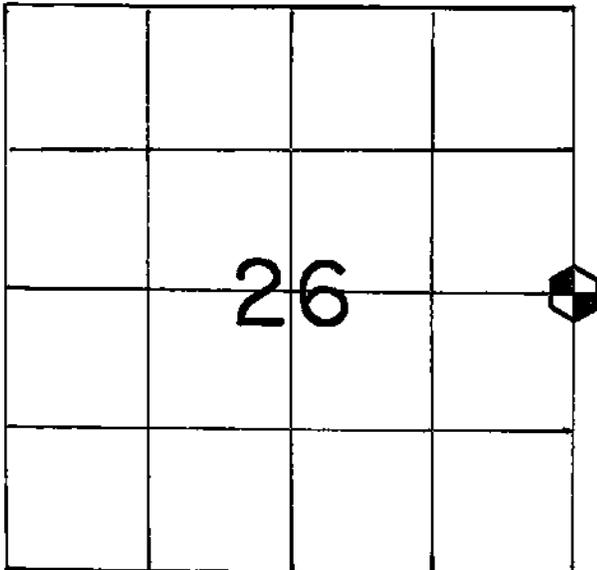

LOCATION OF LANDMARK

WISCONSIN COORDINATE SYSTEM
North
East
Theta Angle
Horiz. Order
Vert. Order
TYPE OF LANDMARK
Set brass cap Lunde marker.
BEARINGS ARE REFERENCED TO

Crew: WILLIAM C. JUNG  
 PETER F. FOLLANSBEE

Crew: William C. Jung  
 Peter F. Follansbee

Date: 11/15/1993

Date: 4/6/94

Describe any record evidence, monument evidence, testimonial evidence or any other material evidence you considered and whether the monument was found or restored through acceptance of an obliterated evidence location.

Gary Sime, RLS, set an iron bar at the computed corner. I accepted his corner, removed the iron bar, and replaced it with a Lunde marker.

4/6/94 - Mr. Everson to the West was in the process of removing fence, clearing brush, and combining fields, so the Lunde was buried so that the top was down 2'.

Describe or show any material discrepancy between the location of the restored corner and that of the corner previously restored or reestablished.

None Known.

