


21705270000

U. S. PUBLIC LAND SURVEY MONUMENT RECORD

SECTION 27 T 17 N, R 5 W, TOWN OF BURNS

LA CROSSE COUNTY

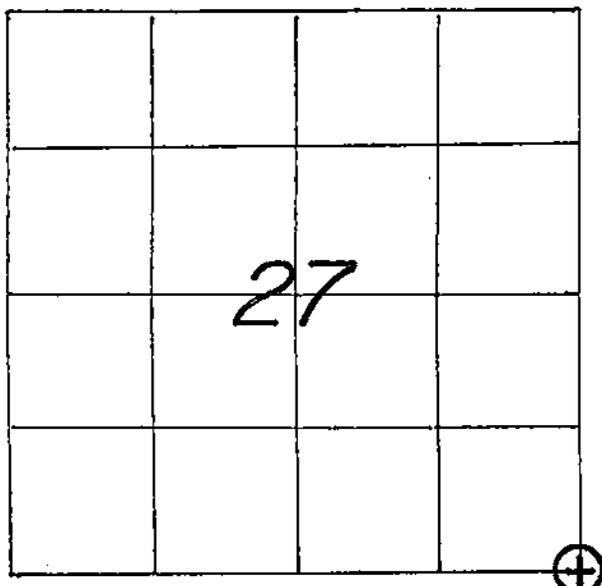

LOCATION OF LANDMARK

CREW: **WILLIAM G. JUNG**
PETER F. FOLLANSBEE
 DATE: **9/17/2003**

WISCONSIN COORDINATE SYSTEM

North **698,948.576**East **1,718,109.731**

Theta Angle

Horiz. Order

Vert. Order

DATUM: 1983('91)

TYPE OF LANDMARK

3/4" x 30" IRON BAR WITH AN ALUMINUM CAP.

BEARINGS ARE REFERENCED TO

GRID NORTH AS PER SECTION DATA.

Describe any record evidence, monument evidence, testimonial evidence or any other material evidence you considered and whether the monument was found or restored through acceptance of an obliterated evidence location.

Mr. Horstman, who lives in the house to the Northeast, says that the parcel that his house is on was surveyed over 40 years ago by Clayton Solberg and also said that Solberg commenced at a fence corner that used to be at this section corner. The description of this parcel would indicate that it was surveyed. Mr. Horstman said that the fence corner had been there as long as he could remember. The fence corner is gone but we were able to reconstruct its location. I accepted the old fence corner location as the best available evidence of the original government corner location. Our section measurements look very good. I monumented the corner with an iron bar and cap and buried it in the field.


Describe or show any material discrepancy between the location of the restored corner and that of the corner previously restored or reestablished.

NONE KNOWN.

RECORD OF DURABLE WITNESS MONUMENTS


GRID BEARINGS GRID DISTANCES

NO	DESCRIPTION	BEARING	DISTANCE
1	SET A 3/4" x 30" IRON BAR WITH RED PLASTIC CAP	N 76°34'41" W	998.04 FT.
2	SET A 3/4" x 30" IRON BAR WITH RED PLASTIC CAP	N 35°39'31" W	531.53 FT.
3	SET A 3/4" x 30" IRON BAR WITH RED PLASTIC CAP	N 24°01'21" W	507.07 FT.
4	SET A 3/4" x 30" IRON BAR WITH RED PLASTIC CAP	N 12°52'29" W	504.28 FT.

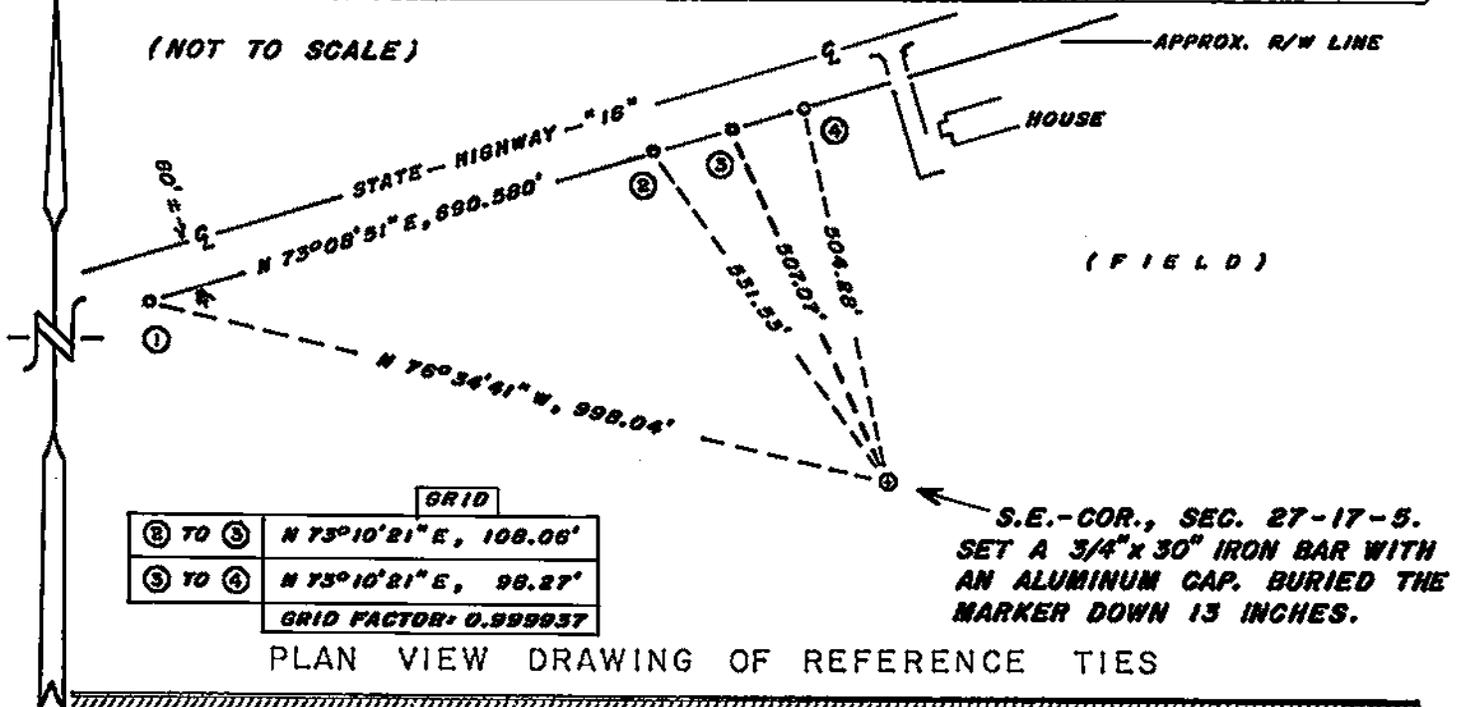


MAP SHOWING DISTANCE AND DIRECTION TO OTHER PUBLIC LAND SURVEY CORNERS USED FOR REESTABLISHING THE CORNER

(GRID BEARINGS & DISTANCES)
(GRID FACTOR: 0.999937)
(NOT TO SCALE)

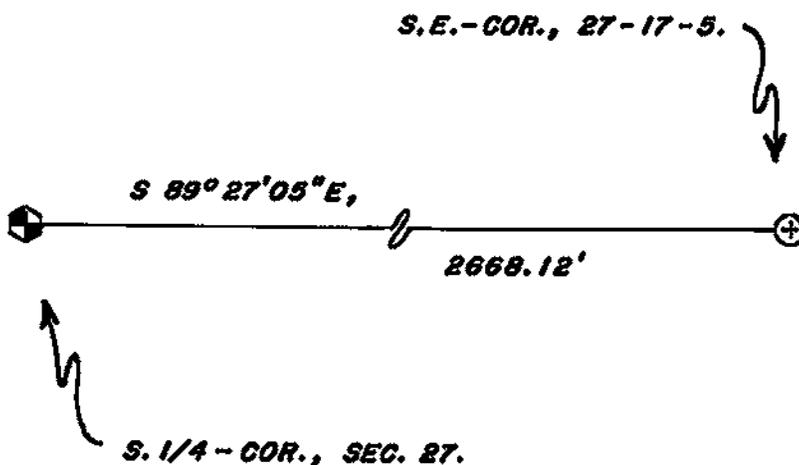

I, WILLIAM C. JUNG, COUNTY SURVEYOR
HEREBY CERTIFY THAT THE CORNER LOCATION SHOWN ON THIS RECORD WAS DETERMINED BY ME OR UNDER MY DIRECTION AND CONTROL AND THAT THIS U. S. PUBLIC LAND SURVEY MONUMENT RECORD IS CORRECT AND COMPLETE TO THE BEST OF MY KNOWLEDGE AND BELIEF.

William C. Jung 2/2/04
Signature Date

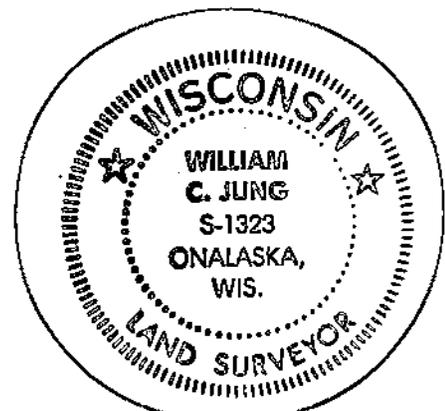

Seal