


21705280000

U. S. PUBLIC LAND SURVEY MONUMENT RECORD

SECTION 33 T 17 N, R 5 W, TOWN OF BURNS
 LA CROSSE COUNTY

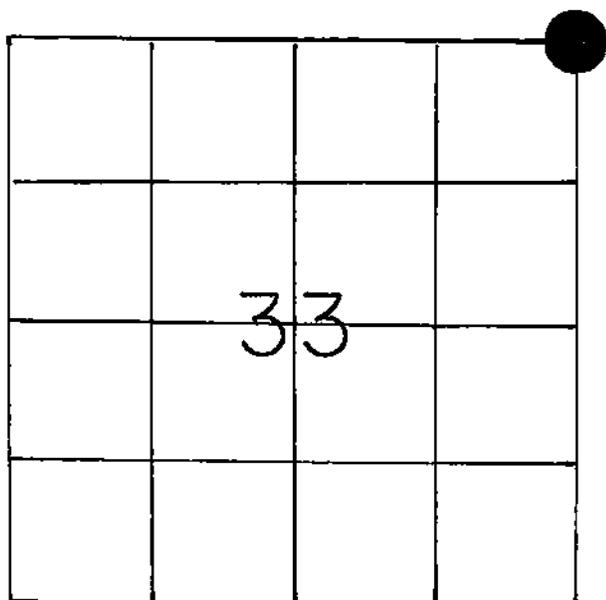

LOCATION OF LANDMARK

WISCONSIN COORDINATE SYSTEM
North
East
Theta Angle
Horiz. Order
Vert. Order
TYPE OF LANDMARK
SET BRASS CAP LUNDE MARKER
BEARINGS ARE REFERENCED TO
ASSUMED NORTH

Crew: WILLIAM C. JUNG, RON HAYDEN,
 ROBBIE HAYDEN, STEVEN HAYDEN

Date: 4/19/1989

Describe any record evidence, monument evidence, testimonial evidence or any other material evidence you considered and whether the monument was found or restored through acceptance of an obliterated evidence location.

Ron Hayden and I found an old field stone at the corner. We accepted it as the best available evidence of the original government corner position. We removed the stone and replaced it with a brass capped lunde marker. I buried a German wine bottle on the Northeast side of the lunde and the stone on the Northwest side.


Note: Existing stone was a 5"x8"x15" pointed red sandstone.

Describe or show any material discrepancy between the location of the restored corner and that of the corner previously restored or reestablished.

NONE KNOWN


**RECORD OF DURABLE WITNESS MONUMENTS
MAGNETIC**

NO	DESCRIPTION	BEARING	DISTANCE
1	Set P.K. Nail in W-side 12" Shagbark Hick'y	S 05°E	27.55 Ft.
2	Set P.K. Nail in W-side 6" Shagbark Hick'y	S 26°W	10.34 Ft.
3	Set P.K. Nail in SE-side 8" White Oak	N 36°E	36.34 Ft.
4	Set P.K. Nail in NW-side 8" White Oak	N 50°E	41.97 Ft.

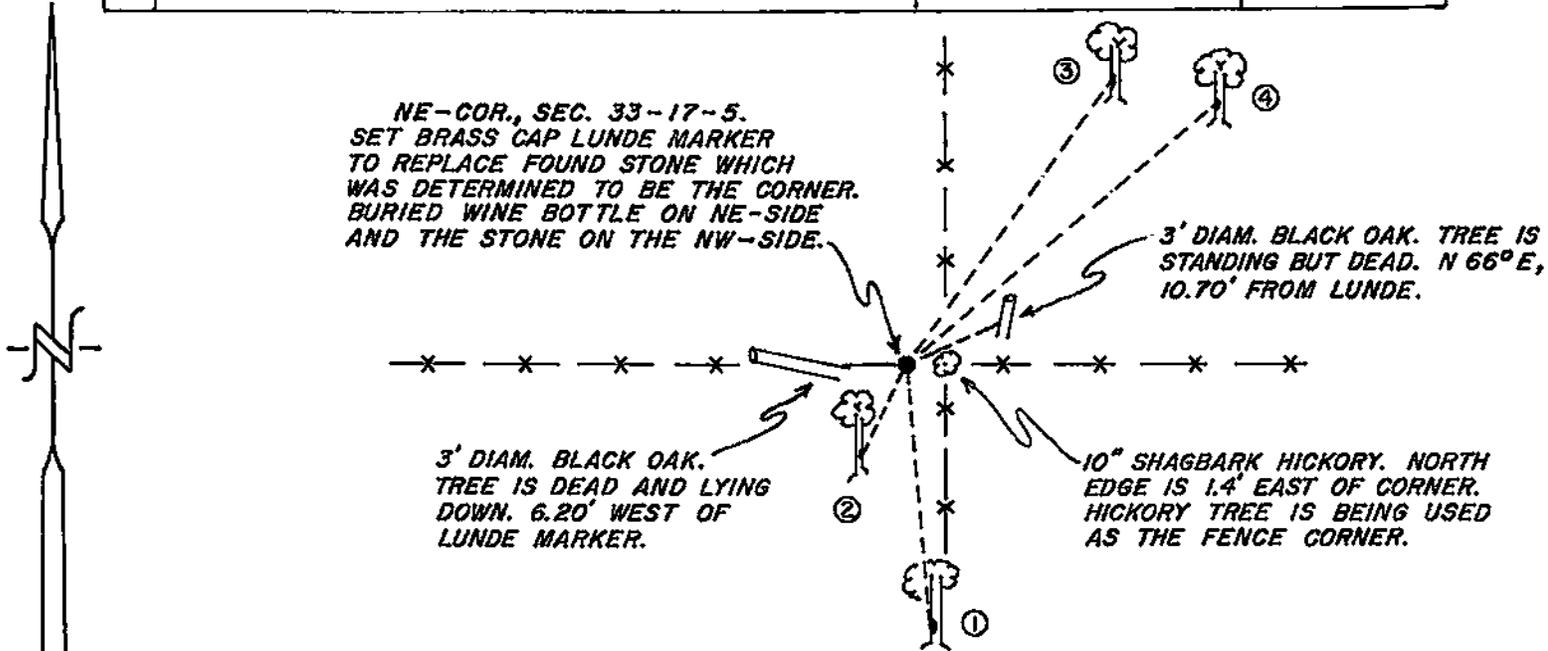

PLAN VIEW DRAWING OF REFERENCE TIES

MAP SHOWING DISTANCE AND DIRECTION TO OTHER PUBLIC LAND
SURVEY CORNERS USED FOR REESTABLISHING THE CORNER
(not to scale)

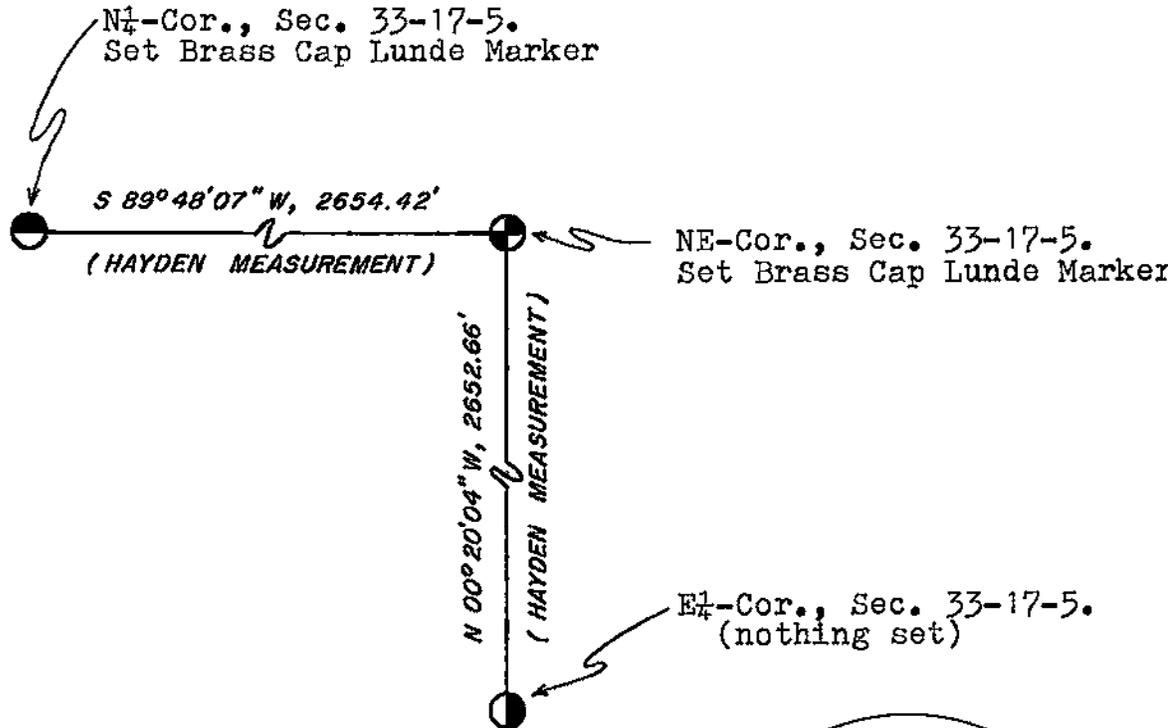

I, William C. Jung, Deputy County Surveyor
HEREBY CERTIFY THAT THE CORNER LOCATION SHOWN ON THIS RECORD
WAS DETERMINED BY ME OR UNDER MY DIRECTION AND CONTROL AND
THAT THIS U. S. PUBLIC LAND SURVEY MONUMENT RECORD IS CORRECT
AND COMPLETE TO THE BEST OF MY KNOWLEDGE AND BELIEF.

William C. Jung
Signature

11/27/89
Date



Seal