


21705280020

U. S. PUBLIC LAND SURVEY MONUMENT RECORD

SECTION 33 T 17 N, R 5 W, TOWN OF BURNS

LA CROSSE COUNTY

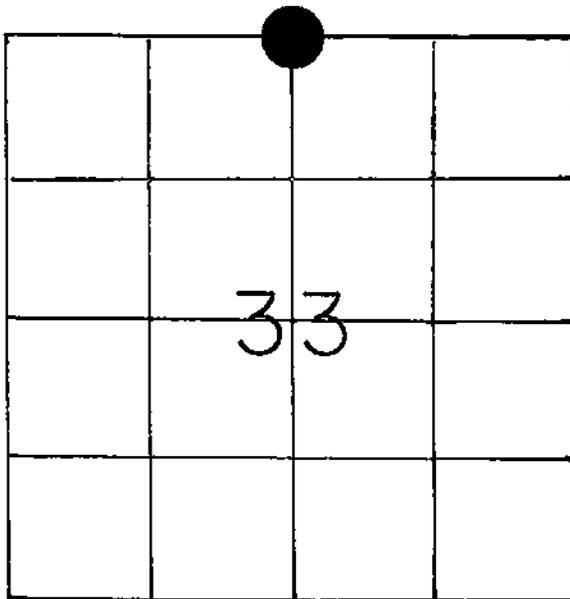

LOCATION OF LANDMARK

WISCONSIN COORDINATE SYSTEM

North

East

Theta Angle

Horiz. Order

Vert. Order

TYPE OF LANDMARK

SET BRASS CAP LUNDE MARKER

BEARINGS ARE REFERENCED TO

ASSUMED NORTH

Crew: WILLIAM C. JUNG
PETER F. FOLLANSBEE

Date: 5/22/1989

Describe any record evidence, monument evidence, testimonial evidence or any other material evidence you considered and whether the monument was found or restored through acceptance of an obliterated evidence location.


Ron Hayden and I had set a P.K. nail at this corner at an earlier date. We removed the P.K. and replaced it with a brass capped Lunde, 1' West of the centerline. The corner is set on line and equidistant between the section corners.

Describe or show any material discrepancy between the location of the restored corner and that of the corner previously restored or reestablished.

None Known


RECORD OF DURABLE WITNESS MONUMENTS
MAGNETIC

NO	DESCRIPTION	BEARING	DISTANCE
1	Set P.K. Nail in 16" Black Walnut (SE-side)	S 48°W ←	171.52 Ft. (slope
2	U.S.G.S. Benchmark w/sign & post(1903 Adj.)	-----	50.03 Ft.
3	Found Nail in centerline of C.T.H. "E"	NORTH+	15.42 Ft.
4	"Caution: Buried Telep. Cable" sign & post	-----	38.80 Ft.

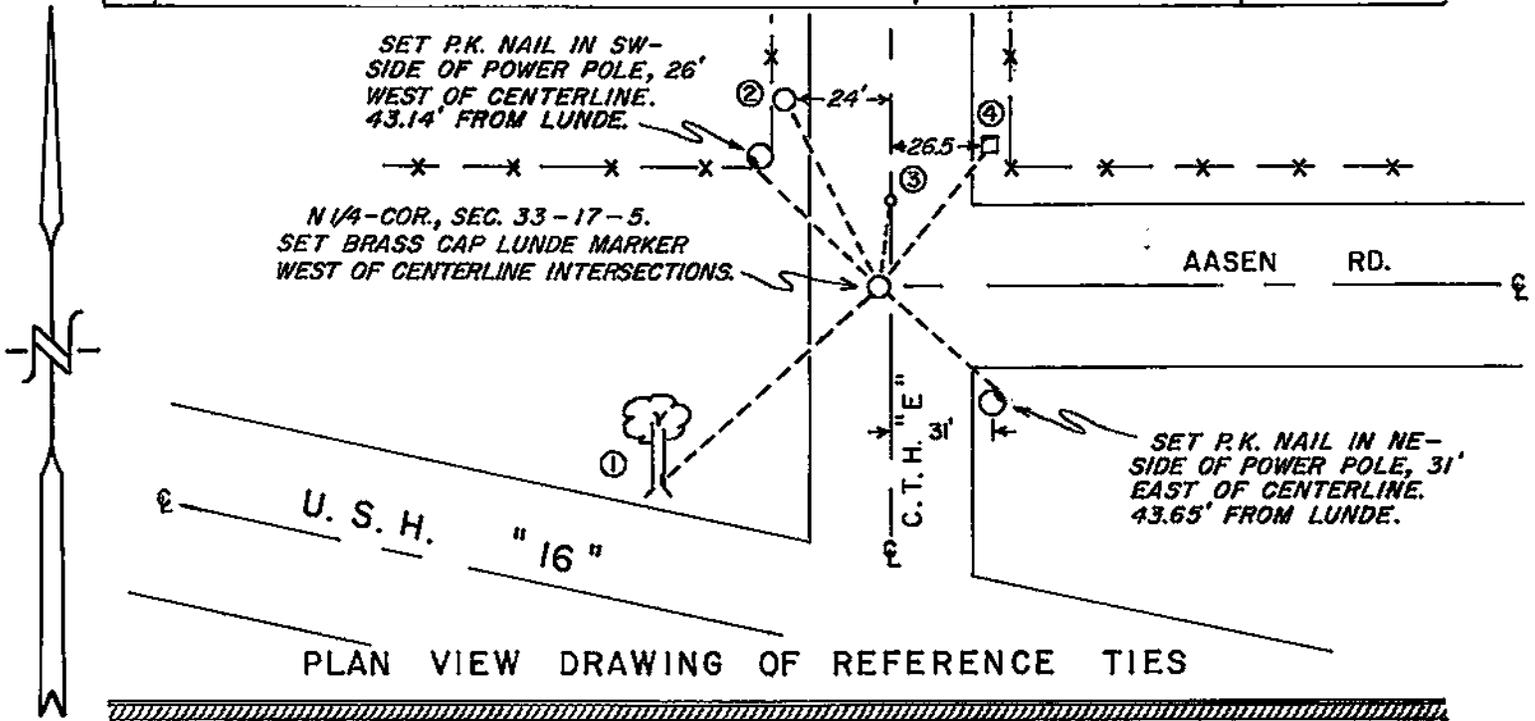

MAP SHOWING DISTANCE AND DIRECTION TO OTHER PUBLIC LAND SURVEY CORNERS USED FOR REESTABLISHING THE CORNER

(not to scale)

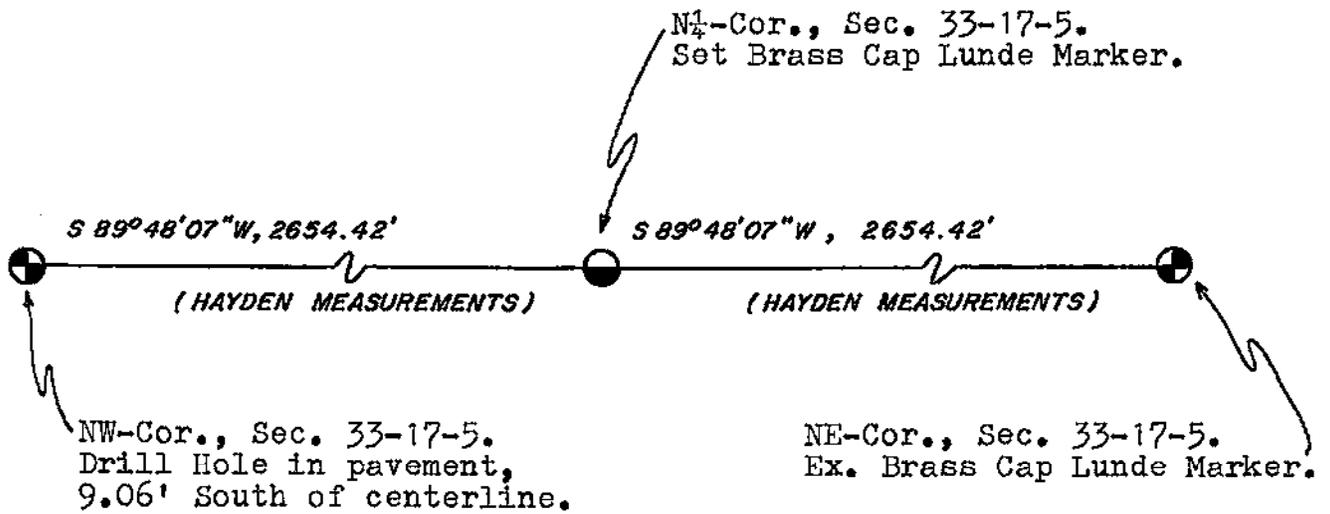

I, William C. Jung, Deputy County Surveyor
HEREBY CERTIFY THAT THE CORNER LOCATION SHOWN ON THIS RECORD
WAS DETERMINED BY ME OR UNDER MY DIRECTION AND CONTROL AND
THAT THIS U. S. PUBLIC LAND SURVEY MONUMENT RECORD IS CORRECT
AND COMPLETE TO THE BEST OF MY KNOWLEDGE AND BELIEF.

William C. Jung
Signature

11/27/89
Date



Seal