


21705290000

U. S. PUBLIC LAND SURVEY MONUMENT RECORD

SECTION 33 T 17 N, R 5 W, TOWN OF BURNS

LA CROSSE COUNTY

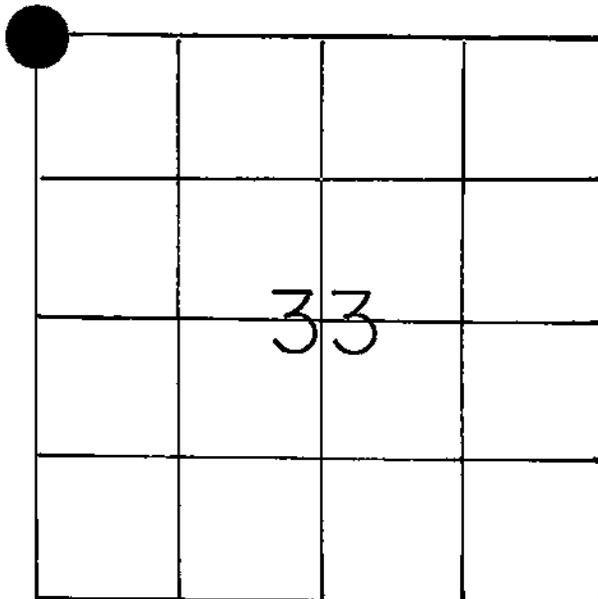

LOCATION OF LANDMARK

Crew: WILLIAM C. JUNG
PETER F. FOLLANSBEE

Date: 6/01/1989

Describe any record evidence, monument evidence, testimonial evidence or any other material evidence you considered and whether the monument was found or restored through acceptance of an obliterated evidence location.

On 4/19/89 Hayden and I set a drill hole at the corner. This fits the occupied conditions to the North, East, and South very well, Clayton Connell used the drill hole as the corner in August of this year.

The drill hole and three ties were destroyed during construction. A P.K. nail was set at the corner.

Describe or show any material discrepancy between the location of the restored corner and that of the corner previously restored or reestablished.

Chalsma shows a railroad spike at this corner in September of 1984. Hayden could not find it.

WISCONSIN COORDINATE SYSTEM

North

East

Theta Angle

Horiz. Order

Vert. Order

TYPE OF LANDMARK

~~DRILL HOLE IN PAVEMENT~~ P.K. nail

BEARINGS ARE REFERENCED TO

ASSUMED NORTH

Crew: William C. Jung
Peter F. Follansbee


Date: 3/27/92

RECORD OF DURABLE WITNESS MONUMENTS

NO	DESCRIPTION	BEARING	DISTANCE
1	SE-corner of brick building	N 41° W	116.16 Ft.
2	Removed bent iron pipe, Set 1" Iron Pipe, 50' N. of centerline	-----	59.08 Ft.
3	Set Ex. P.K. Nail in West side of utility pole	-----	37.45 Ft. 63.07
4	Hayden's P.K. Nail at centerline intersection	-----	10.15 Ft.

MAGNETIC


(NOT TO SCALE)

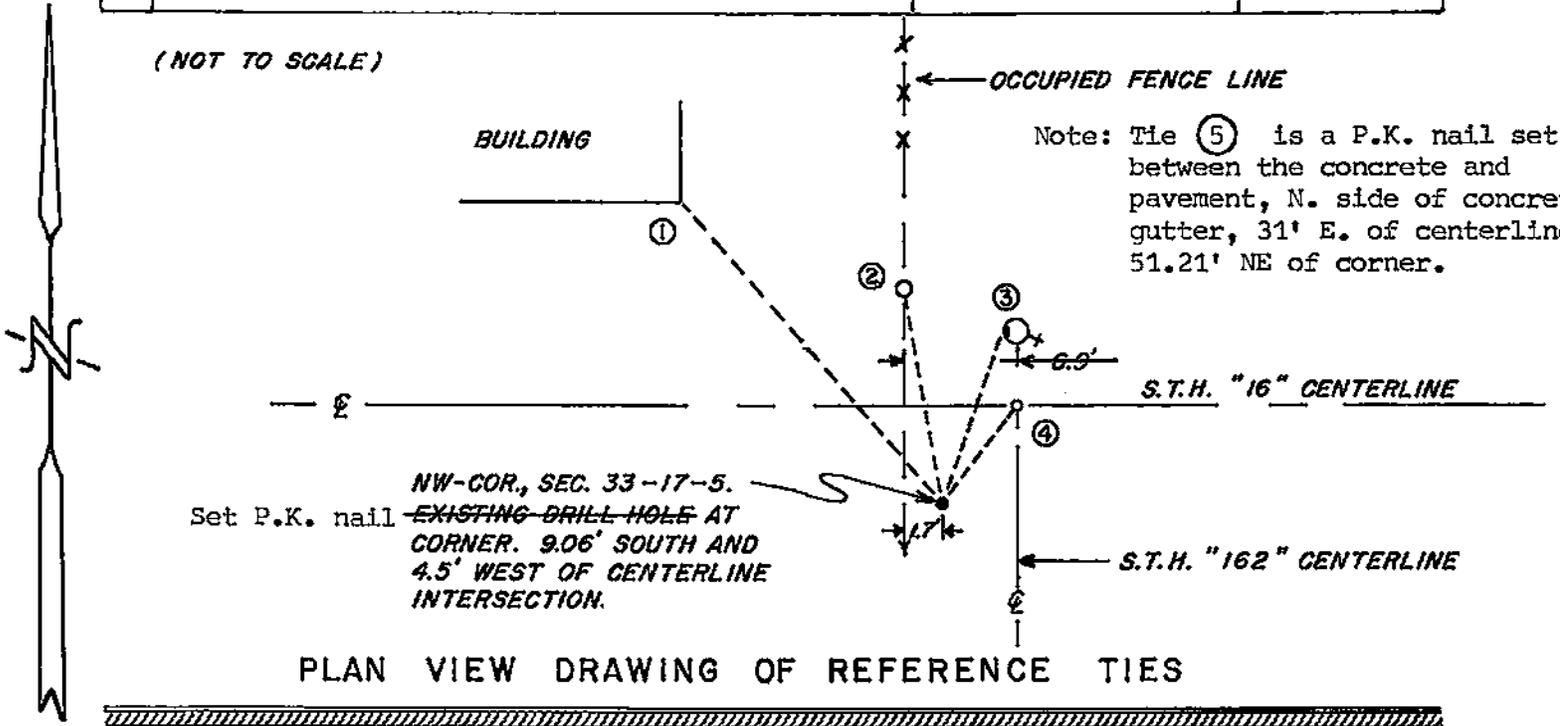

PLAN VIEW DRAWING OF REFERENCE TIES

MAP SHOWING DISTANCE AND DIRECTION TO OTHER PUBLIC LAND SURVEY CORNERS USED FOR REESTABLISHING THE CORNER


(not to scale)

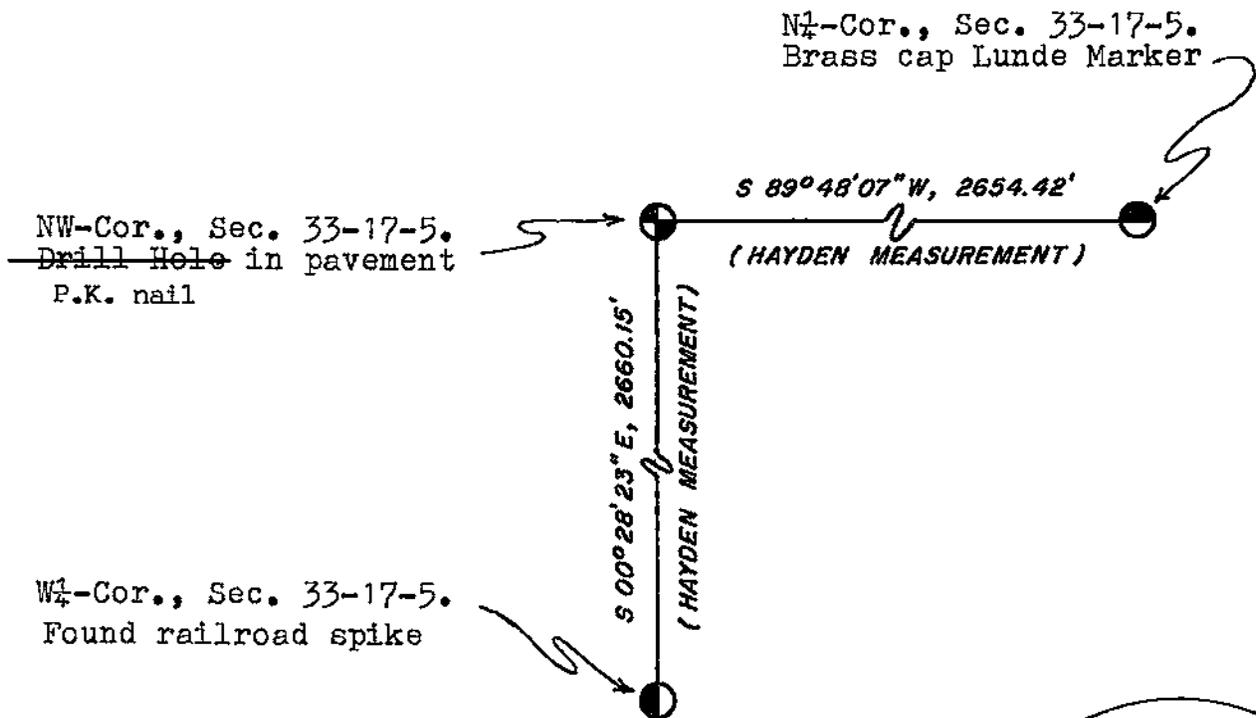

I, William C. Jung, Deputy County Surveyor
 HEREBY CERTIFY THAT THE CORNER LOCATION SHOWN ON THIS RECORD
 WAS DETERMINED BY ME OR UNDER MY DIRECTION AND CONTROL AND
 THAT THIS U. S. PUBLIC LAND SURVEY MONUMENT RECORD IS CORRECT
 AND COMPLETE TO THE BEST OF MY KNOWLEDGE AND BELIEF.

William C. Jung
 Signature

11/27/89
 Date
 Revised: 6/12/92

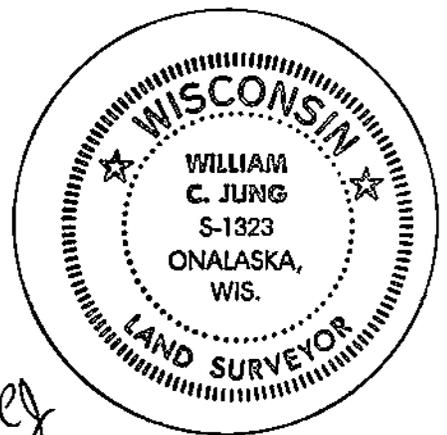

Seal