


21705292000

U. S. PUBLIC LAND SURVEY MONUMENT RECORD

SECTION 28 T 17 N, R 5 W, TOWN OF BURNS

LA CROSSE COUNTY

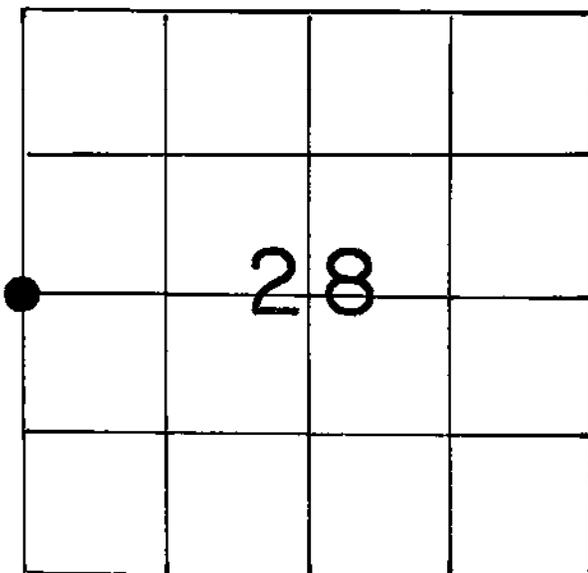

LOCATION OF LANDMARK

Crew: William C. Jung  
Peter Follansbee

Date: 2/27/90

WISCONSIN COORDINATE SYSTEM
North
East
Theta Angle
Horiz. Order
Vert. Order
TYPE OF LANDMARK
1"x30" iron pipe Lunde marker
BEARINGS ARE REFERENCED TO
True

Crew: Peter Follansbee  
Daniel Leis

Date: 6/25/90

Describe any record evidence, monument evidence, testimonial evidence or any other material evidence you considered and whether the monument was found or restored through acceptance of an obliterated evidence location.


I found tie posts where the North-South fence was tied off. After surveying out Section 28, I accepted this location as the best available evidence of the original government corner position and set an iron pipe. The final East-West 1/4 line fits the fence at the center 1/4 corner almost perfectly. Also, setting this 1/4 corner as such would place the final W1/16SW very close to the occupied fence corner, 1' West of it and 1.5' South of it. I do not think that setting this corner by single proportionate measurement would be correct.

Describe or show any material discrepancy between the location of the restored corner and that of the corner previously restored or reestablished.

None known.


RECORD OF DURABLE WITNESS MONUMENTS

NO	DESCRIPTION	BEARING	DISTANCE
1	P.K. in unblazed 18" burr oak	-----	45.39
2	" " " 30" " "	-----	slope=74.81
3	" " " 30" " "	-----	59.70
4	" " " 32"+white oak	-----	66.54

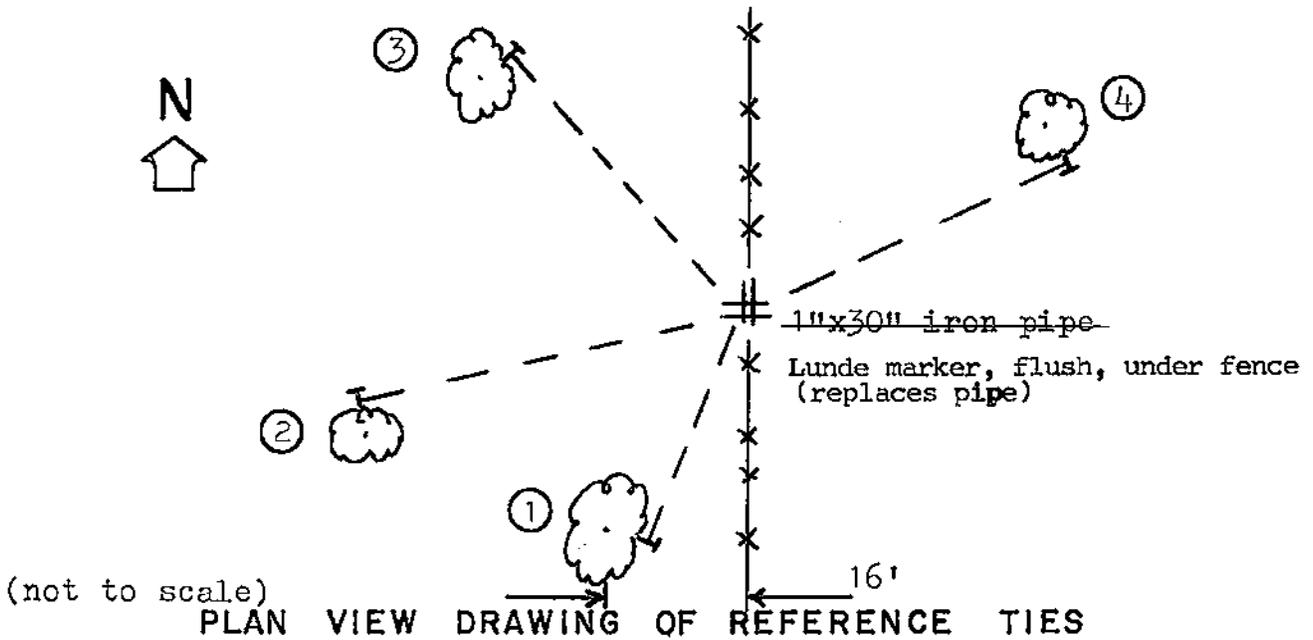

MAP SHOWING DISTANCE AND DIRECTION TO OTHER PUBLIC LAND SURVEY CORNERS USED FOR REESTABLISHING THE CORNER

(not to scale)

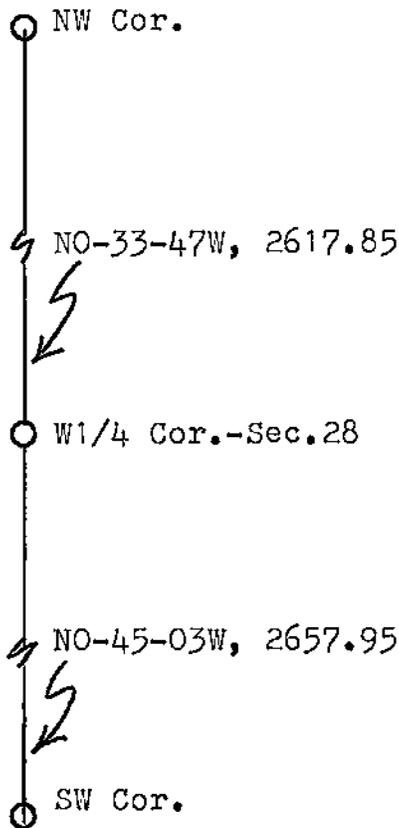


I, William C. Jung, Deputy County Surveyor,  
HEREBY CERTIFY THAT THE CORNER LOCATION SHOWN ON THIS RECORD  
WAS DETERMINED BY ME OR UNDER MY DIRECTION AND CONTROL AND  
THAT THIS U. S. PUBLIC LAND SURVEY MONUMENT RECORD IS CORRECT  
AND COMPLETE TO THE BEST OF MY KNOWLEDGE AND BELIEF.

William C. Jung  
Signature

March 5, 1990  
Date

Revised: February 12, 1991 *wey*

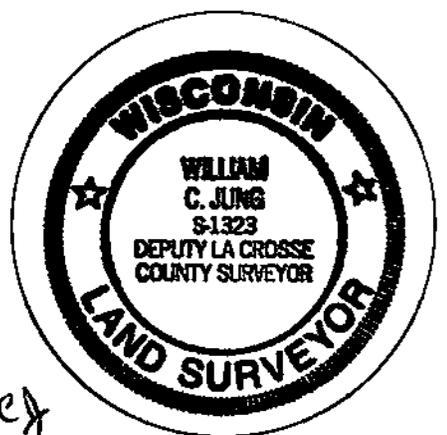

Seal