


21705300000

U. S. PUBLIC LAND SURVEY MONUMENT RECORD

SECTION 30 T 17 N, R 5 W, TOWN OF BURNS

LA CROSSE COUNTY

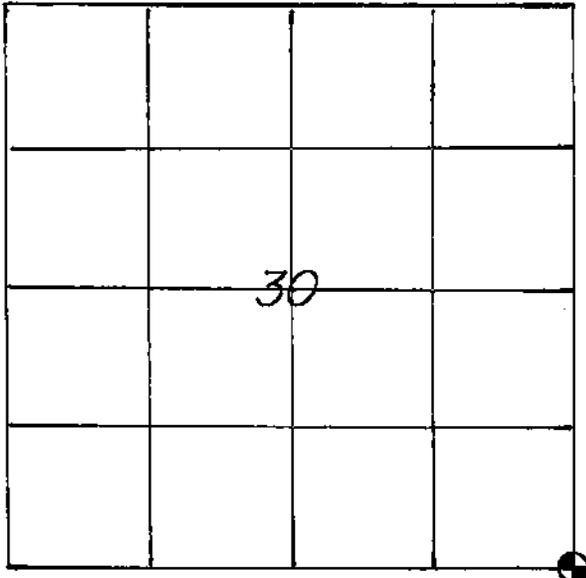

LOCATION OF LANDMARK

CREW: BILL JUNG
 PERRY LEE DAHL
 DATE: 6-26-86

WISCONSIN COORDINATE SYSTEM
North
East
Theta Angle
Horiz. Order
Vert. Order
TYPE OF LANDMARK
BRASS CAPPED LUNDE MARKER
BEARINGS ARE REFERENCED TO TRUE

Describe any record evidence, monument evidence, testimonial evidence or any other material evidence you considered and whether the monument was found or restored through acceptance of an obliterated evidence location.

I set the corner on line with the old line fence to the South and at a distance from the existing centerline so the final corner will be in the centerline of the old highway before the highway was changed. I believe that the old centerline was on the section line. This location fits the East line of Section 30 very well for line and distance.

Describe or show any material discrepancy between the location of the restored corner and that of the corner previously restored or reestablished.

In 1974 Greg Hofmeister shows the corner as being in the centerline of the road. I do not agree with this.

