


## U. S. PUBLIC LAND SURVEY MONUMENT RECORD

SECTION 6 T 16 N, R 5 W, TOWN OF BANGOR

LA CROSSE COUNTY

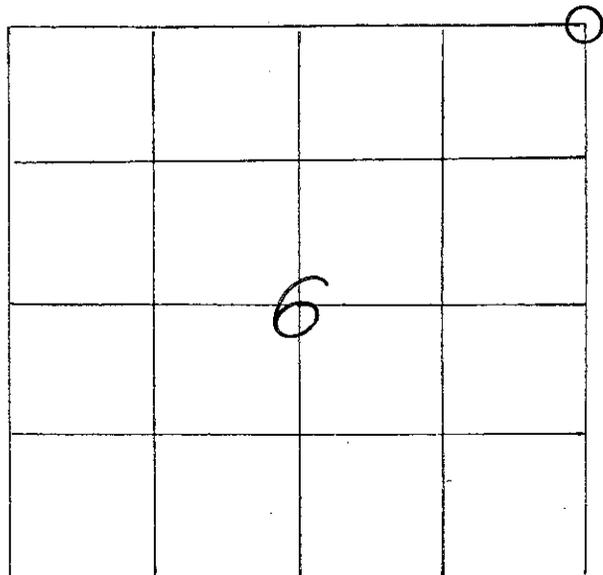

LOCATION OF LANDMARK

CREW: WILLIAM C. JUNG  
 PETER F. FOLLANSBEE  
 DATE: 9/11/1997

## WISCONSIN COORDINATE SYSTEM

North 693,790.317

East 1,702,193.767

Theta Angle

Horiz. Order

Vert. Order

Datum: NAD 1983('91)

## TYPE OF LANDMARK

2-1/2" x 4' IRON PIPE. (O.D.)

## BEARINGS ARE REFERENCED TO

Grid North as per Section  
Data

*Bryan H. Meyer*  
 (Revised: 10/26/2009)  
 (Bryan H. Meyer)

Describe any record evidence, monument evidence, testimonial evidence or any other material evidence you considered and whether the monument was found or restored through acceptance of an obliterated evidence location.


I found Bliss' old 1867 stone of record. The stone was broken in pieces in the muck and water with the base off plumb. I set an iron pipe on the Northeast side of this "off plumb" base. Placed pieces of stone on the ground near the pipe.

Describe or show any material discrepancy between the location of the restored corner and that of the corner previously restored or reestablished.

NONE KNOWN.


RECORD OF DURABLE WITNESS MONUMENTS

NO	DESCRIPTION	BEARING	DISTANCE
1	SET A 3/4" x 15" ROUND IRON BAR IN THE PASTURE	WEST ±	33.01 FT.
2	SET A NAIL IN S.E.-SIDE 31" BURR OAK (UNBLAZED)	S'WESTERLY ±	131.78 FT.
3	SET A NAIL IN N.W.-SIDE 24" BURR OAK (UNBLAZED)	S'WESTERLY ±	139.69 FT.
4	DISTANCE TO CENTER OF 28" BURR OAK (UNBLAZED)	S 07° W (MAG.)	161' ±

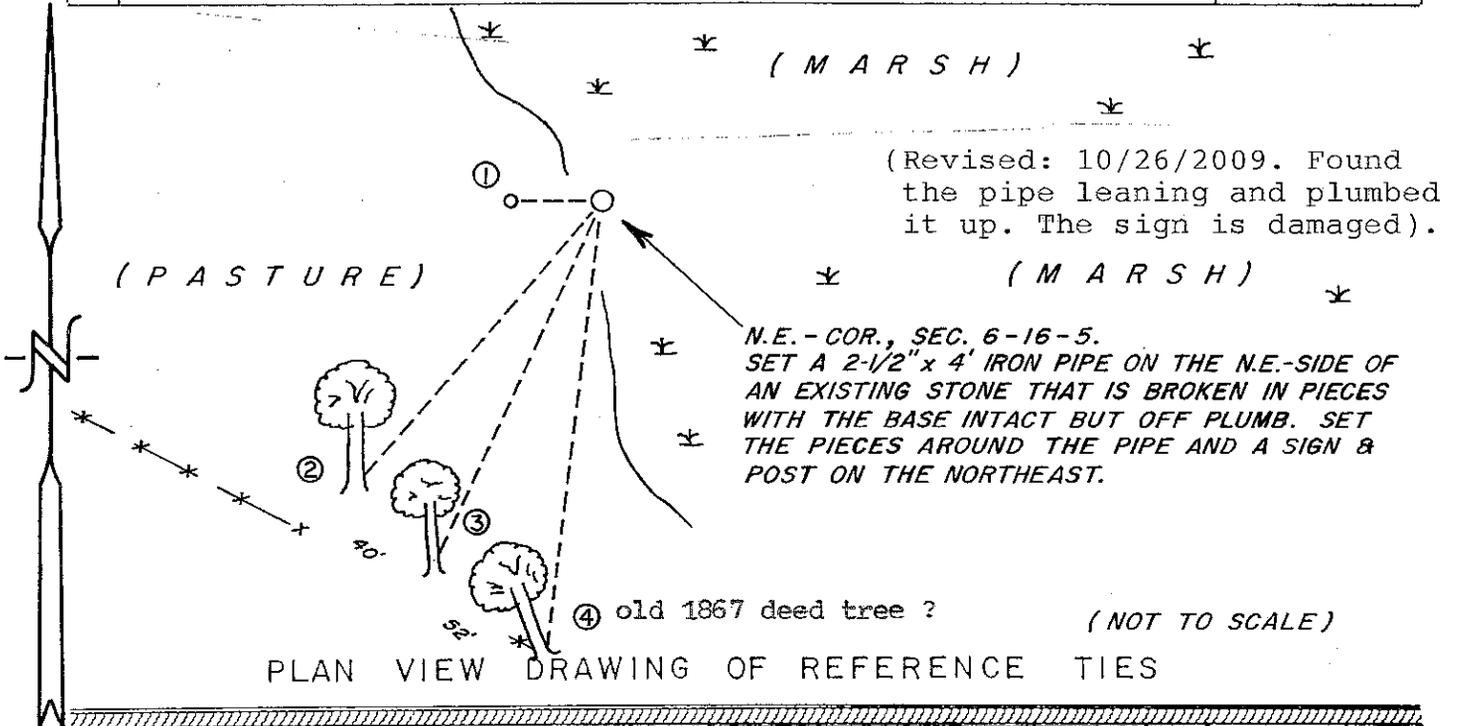

MAP SHOWING DISTANCE AND DIRECTION TO OTHER PUBLIC LAND SURVEY CORNERS USED FOR REESTABLISHING THE CORNER

(Grid bearings and distances)  
(Grid Factor: 0.9999381)  
(Not to scale)  
(Revised: 10/26/2009)

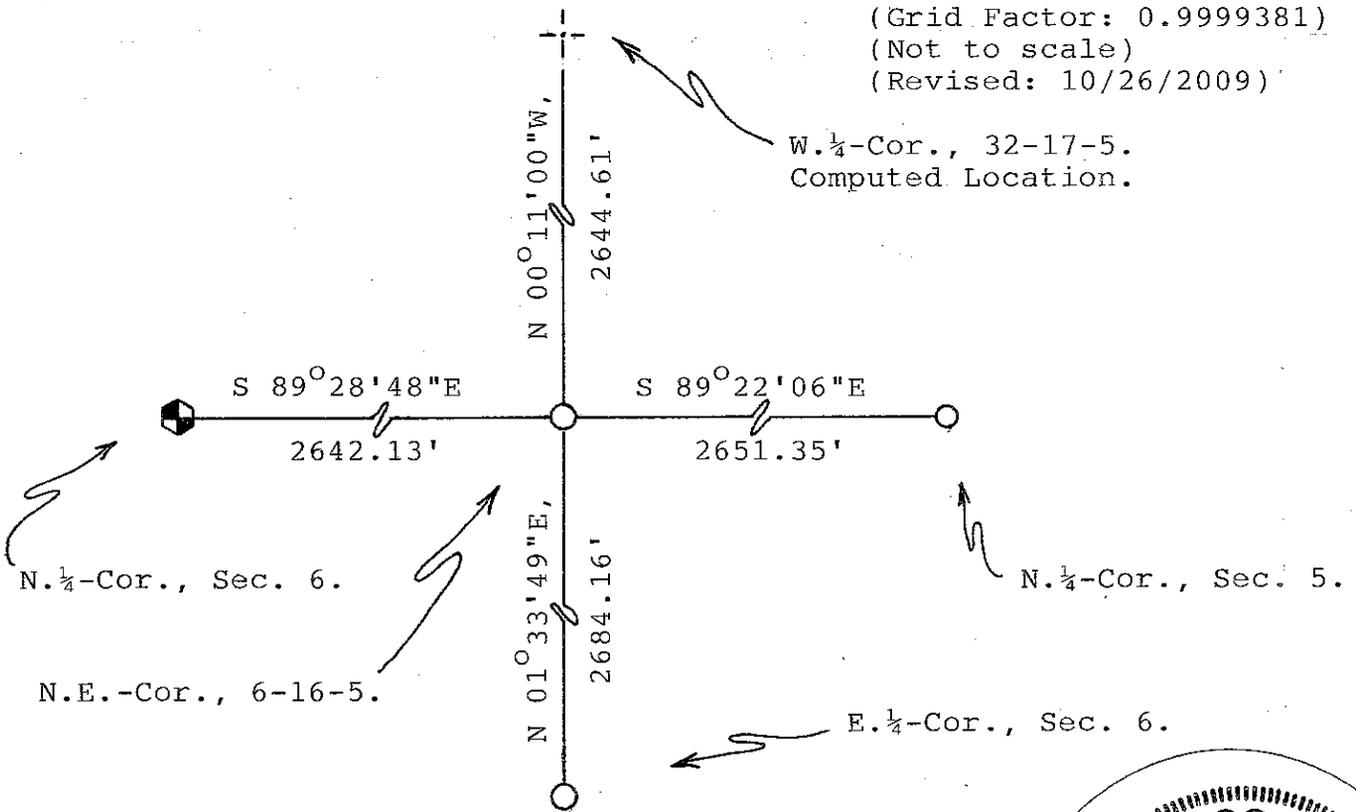

I, WILLIAM C. JUNG, COUNTY SURVEYOR  
HEREBY CERTIFY THAT THE CORNER LOCATION SHOWN ON THIS RECORD WAS DETERMINED BY ME OR UNDER MY DIRECTION AND CONTROL AND THAT THIS U. S. PUBLIC LAND SURVEY MONUMENT RECORD IS CORRECT AND COMPLETE TO THE BEST OF MY KNOWLEDGE AND BELIEF.

William C. Jung March 5, 1998  
Signature Date




Seal

21705310000

## U. S. PUBLIC LAND SURVEY MONUMENT RECORD

SECTION 6 T 16 N, R 5 W, TOWN OF BANGOR  
 LA CROSSE COUNTY

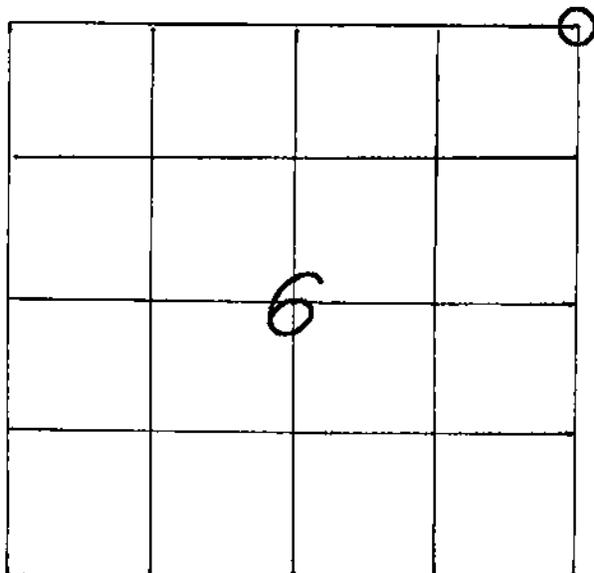

WISCONSIN COORDINATE SYSTEM

North

East

Theta Angle

Horiz. Order

Vert. Order

TYPE OF LANDMARK

2-1/2" x 4' IRON PIPE. (O.D.)

BEARINGS ARE REFERENCED TO

TRUE NORTH ( $\pm 02'$ )

LOCATION OF LANDMARK

CREW: WILLIAM C. JUNG  
 PETER F. FOLLANSBEE  
 DATE: 9/11/1997

Describe any record evidence, monument evidence, testimonial evidence or any other material evidence you considered and whether the monument was found or restored through acceptance of an obliterated evidence location.


I found Bliss' old 1867 stone of record. The stone was broken in pieces in the muck and water with the base off plumb. I set an iron pipe on the Northeast side of this "off plumb" base. Placed pieces of stone on the ground near the pipe.

Describe or show any material discrepancy between the location of the restored corner and that of the corner previously restored or reestablished.

**NONE KNOWN.**


RECORD OF DURABLE WITNESS MONUMENTS

NO	DESCRIPTION	BEARING	DISTANCE
1	SET A 3/4" x 15" ROUND IRON BAR IN THE PASTURE	WEST ±	33.01 FT.
2	SET A NAIL IN S.E.-SIDE 31" BURR OAK (UNBLAZED)	S'WESTERLY±	131.78 FT.
3	SET A NAIL IN N.W.-SIDE 24" BURR OAK (UNBLAZED)	S'WESTERLY±	139.69 FT.
4	DISTANCE TO CENTER OF 28" BURR OAK (UNBLAZED)	S 07° W (MAG.)	161' ±

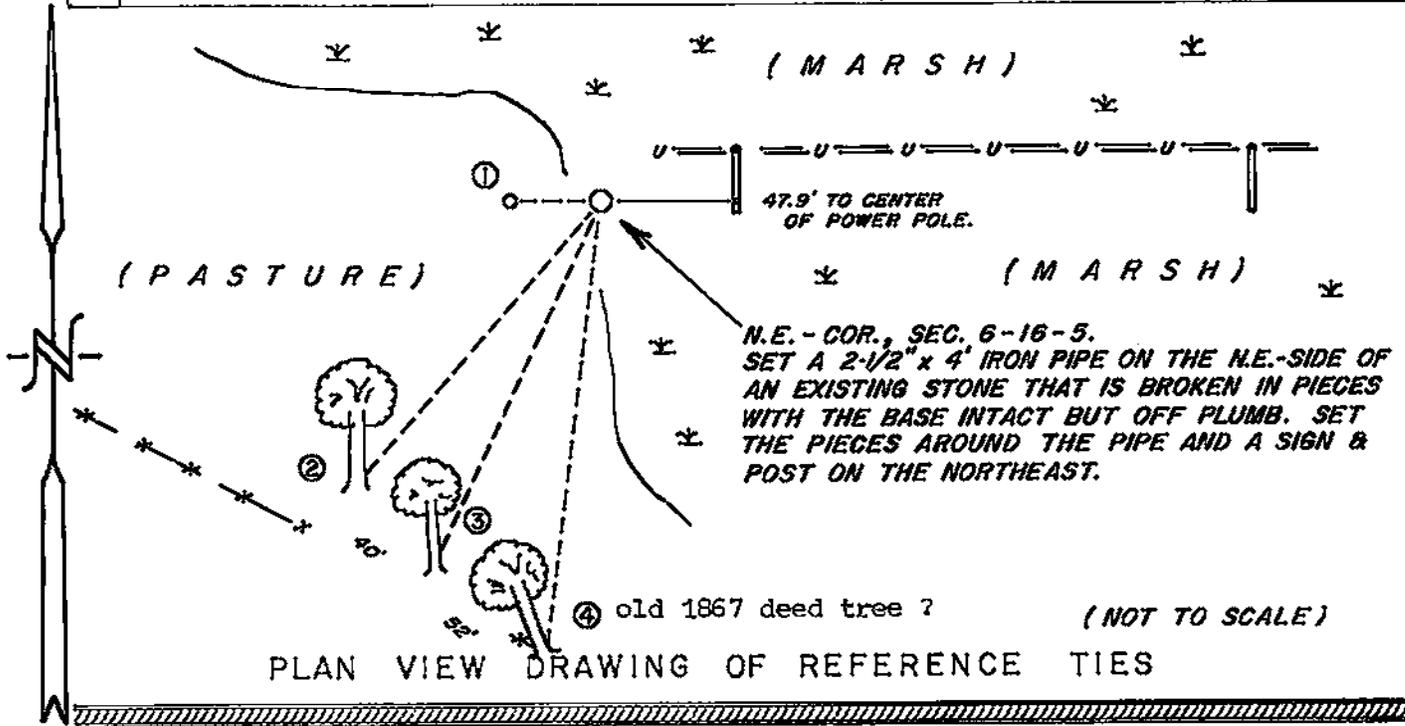

MAP SHOWING DISTANCE AND DIRECTION TO OTHER PUBLIC LAND SURVEY CORNERS USED FOR REESTABLISHING THE CORNER

(not to scale)

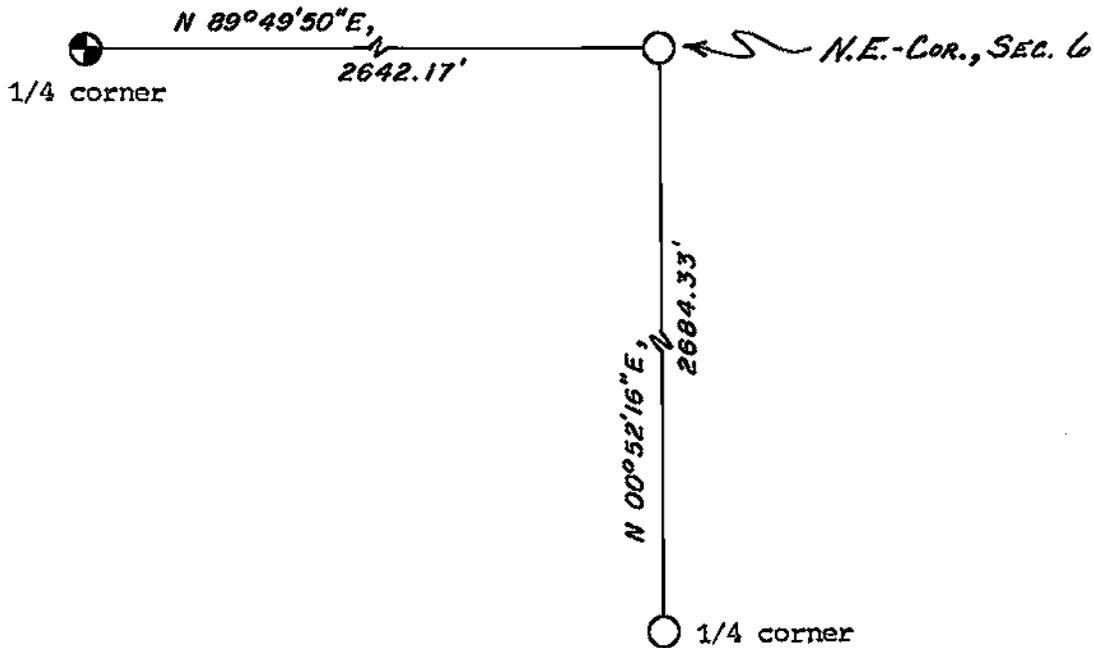

I, WILLIAM C. JUNG, COUNTY SURVEYOR  
 HEREBY CERTIFY THAT THE CORNER LOCATION SHOWN ON THIS RECORD WAS DETERMINED BY ME OR UNDER MY DIRECTION AND CONTROL AND THAT THIS U. S. PUBLIC LAND SURVEY MONUMENT RECORD IS CORRECT AND COMPLETE TO THE BEST OF MY KNOWLEDGE AND BELIEF.

William C. Jung March 5, 1998  
 Signature Date



Seal