


21705332000

U. S. PUBLIC LAND SURVEY MONUMENT RECORD

SECTION 34 T. 17 N, R. 5 W, TOWN OF BURNS

LA CROSSE COUNTY

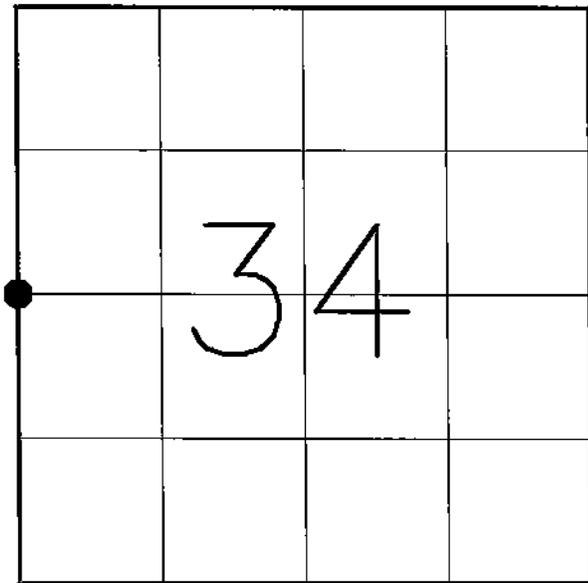

LOCATION OF LANDMARK

WISCONSIN COORDINATE SYSTEM

NORTH

EAST

THETA ANGLE

HORIZ. ORDER

VERT. ORDER

TYPE OF LANDMARK

FOUND 1 1/4" IRON BAR

BEARINGS ARE REFERENCE TO
LA CROSSE COUNTY COORDINATE SYSTEM
(UNLESS OTHERWISE NOTED)

DESCRIBE ANY RECORDED EVIDENCE, MONUMENT EVIDENCE, TESTIMONIAL EVIDENCE, OR ANY OTHER MATERIAL EVIDENCE YOU CONSIDERED AND WHETHER THE MONUMENT WAS FOUND OR RESTORED THROUGH ACCEPTANCE OF AN OBLITERATED EVIDENCE LOCATION.

THERE IS NO EVIDENCE FOUND OF THE ORIGINAL MONUMENT OR TIES. THE QUARTER CORNER WAS SET IN A NORTH/SOUTH FENCE LINE EQUIDISTANT FROM THE NORTHWEST CORNER AND SOUTHWEST SECTION CORNERS.

DESCRIBE OR SHOW ANY MATERIAL DISCREPANCY BETWEEN THE LOCATION OF THE RESTORED CORNER AND THAT OF THE CORNER PREVIOUSLY RESTORED OR REESTABLISHED.

NONE KNOWN


RECORDED

FEB 2 2008


OFFICE

RECORD OF DURABLE WITNESS MONUMENT

NO	DESCRIPTION	BEARING	DISTANCE
1	SET 3/4" IRON BAR	N 01°25'23" E	19.09
2	SET 3/4" IRON BAR	N 87°44'18" E	67.70
3	SET 3/4" IRON BAR	S 00°59'53" E	22.13
4	SET 3/4" IRON BAR	N 78°22'30" W	33.09
5	BLAZED 16" TREE	N 77°43'37" W	35.74

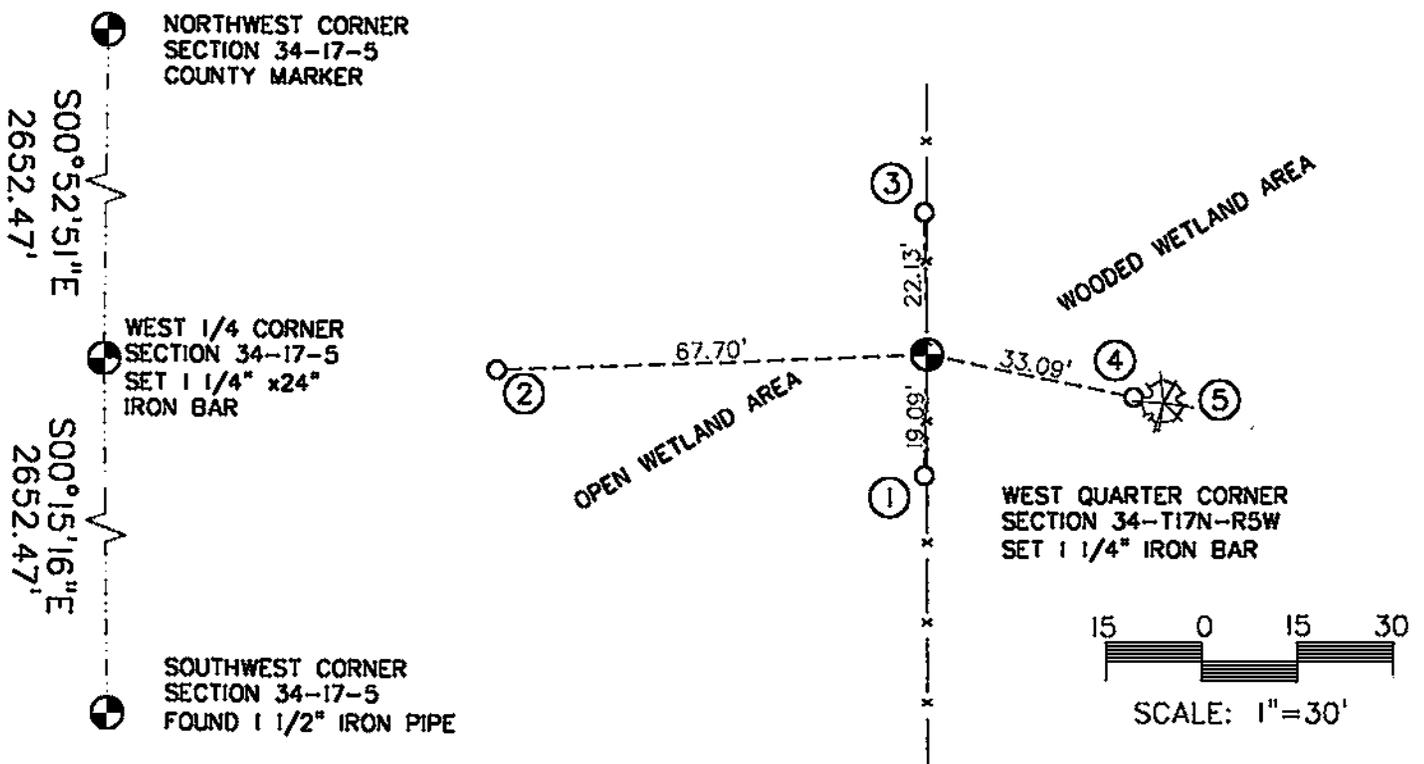

MAP SHOWING DISTANCE AND DIRECTION TO OTHER PUBLIC LAND SURVEY CORNER USED FOR REESTABLISHING THE CORNER.

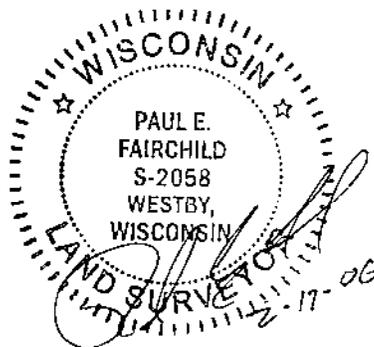

I, PAUL E. FAIRCHILD HEREBY CERTIFY THAT THE CORNER LOCATION SHOWN ON THIS RECORD WAS DETERMINED BY ME OR UNDER MY DIRECTION AND CONTROL AND THAT THIS U.S. PUBLIC LAND SURVEY MONUMENT IS CORRECT AND COMPLETE TO THE BEST OF MY KNOWLEDGE AND BELIEF.

2-17-06

 SIGNATURE DATE