


21705340020

U. S. PUBLIC LAND SURVEY MONUMENT RECORD

SECTION 34 T 17 N, R 5 W, TOWN OF Burns

LA CROSSE COUNTY

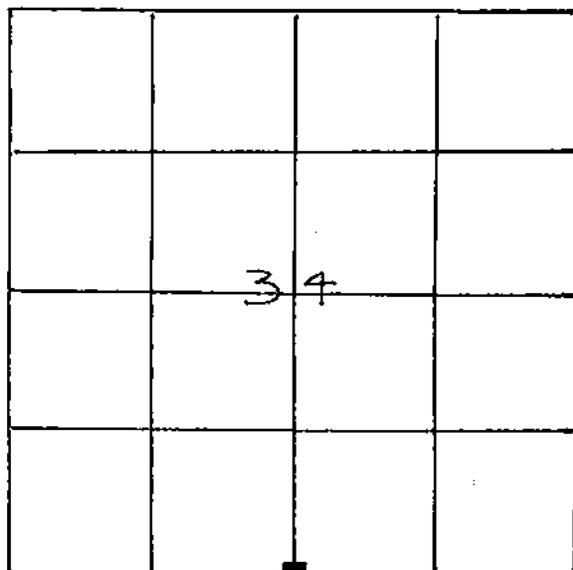

LOCATION OF LANDMARK

WISCONSIN COORDINATE SYSTEM

North

East

Theta Angle

Horiz. Order

Vert. Order

TYPE OF LANDMARK

6"x6" stone

BEARINGS ARE REFERENCED TO

N-S 1/4 line 34-17-5

Assumed to bear as shown


Describe any record evidence, monument evidence, testimonial evidence or any other material evidence you considered and whether the monument was found or restored through acceptance of an obliterated evidence location.

Found 6"x6" stone per previous tie sheet.
Some ties missing - so am filing a new tie sheet.


Describe or show any material discrepancy between the location of the restored corner and that of the corner previously restored or reestablished.

RECORD OF DURABLE WITNESS MONUMENTS

| NO | DESCRIPTION | BEARING | DISTANCE |
|----|------------------------------------------------------|------------|----------|
| 1 | Spike set- ground level NE side 33" Burr Oak | N53-30-16W | 43.35 |
| 2 | RR. Spike set - CL Town road @ CL residence driveway | N52-51-25E | 20.84 |
| 3 | Found 16d nail - E. side 8"x8" fence post | S06-09-45W | 16.41 |
| 4 | Set P.K. nail W. Side Utility Pole | S01-58-02W | 106.08 |

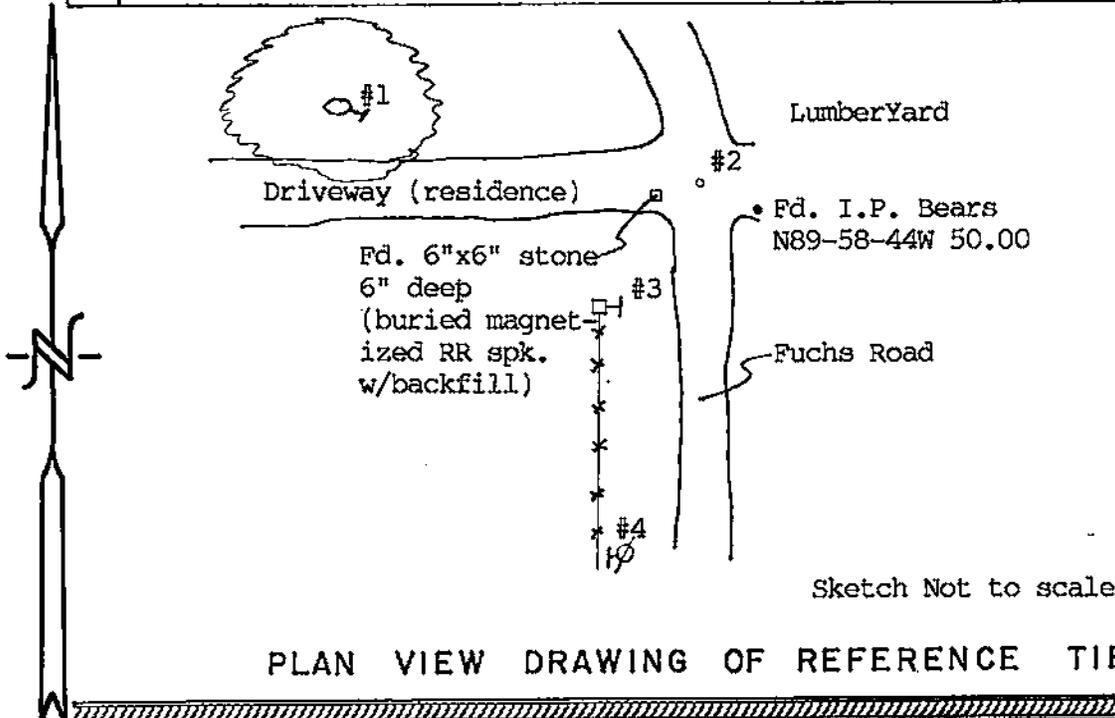


MAP SHOWING DISTANCE AND DIRECTION TO OTHER PUBLIC LAND SURVEY CORNERS USED FOR REESTABLISHING THE CORNER

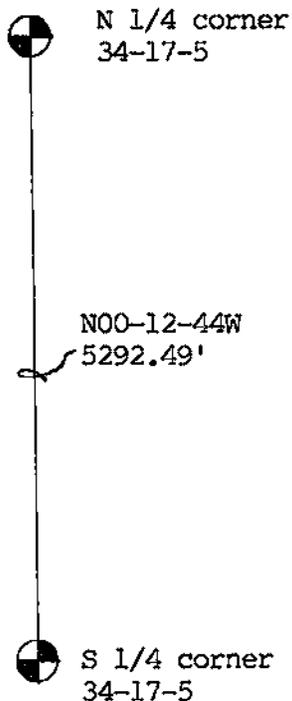

I, Paul E. Fairchild, Registered Land Surveyor
 HEREBY CERTIFY THAT THE CORNER LOCATION SHOWN ON THIS RECORD
 WAS DETERMINED BY ME OR UNDER MY DIRECTION AND CONTROL AND
 THAT THIS U. S. PUBLIC LAND SURVEY MONUMENT RECORD IS CORRECT
 AND COMPLETE TO THE BEST OF MY KNOWLEDGE AND BELIEF.


Signature

1/5/98
Date

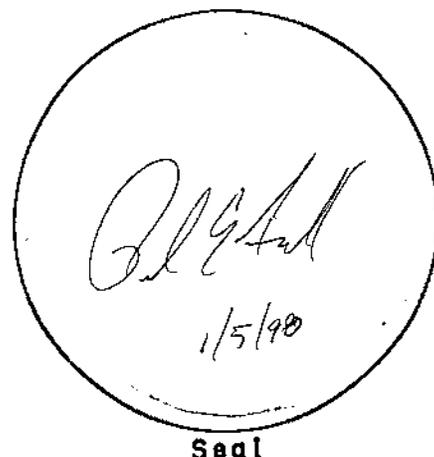

U. S. PUBLIC LAND SURVEY MONUMENT RECORD

SECTION 3 T 16 N, R 5 W, TOWN OF Bangor
 LA CROSSE COUNTY

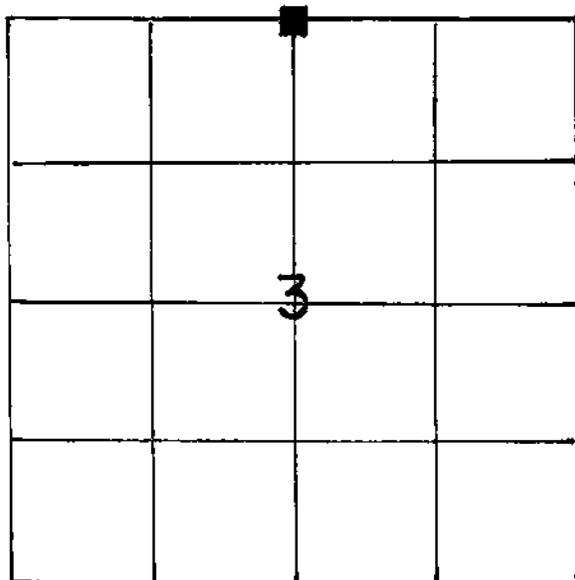

LOCATION OF LANDMARK

Crew: William C. Jung
 Perry L. Dahl
 11-19-86

| |
|-----------------------------|
| WISCONSIN COORDINATE SYSTEM |
| North |
| East |
| Theta Angle |
| Horiz. Order |
| Vert. Order |
| TYPE OF LANDMARK |
| Stone |
| BEARINGS ARE REFERENCED TO |
| True |

Describe any record evidence, monument evidence, testimonial evidence or any other material evidence you considered and whether the monument was found or restored through acceptance of an obliterated evidence location.


There was supposed to be a pipe at this corner but it apparently was knocked out. I also found the old stone which had been knocked out many years ago. I set the old stone at the location of the missing pipe as shown on previous surveys and accepted this location as the best available evidence of the original government corner position.

Describe or show any material discrepancy between the location of the restored corner and that of the corner previously restored or reestablished.

None known.


RECORD OF DURABLE WITNESS MONUMENTS

| NO | DESCRIPTION | BEARING | DISTANCE |
|----|--------------------------------------------|-------------------|----------|
| 1 | P.K. nail in unblazed 33" burr oak | N56W (Magnetic) | 44.51 |
| 2 | Replaced bent iron pipe with new iron pipe | N89-49-19E (True) | 50.00 |
| 3 | P.K. nail in unblazed 18" burr oak | N85E (Magnetic) | 73.00 |
| 4 | Existing iron pipe (see reference to ②) | ----- | ----- |

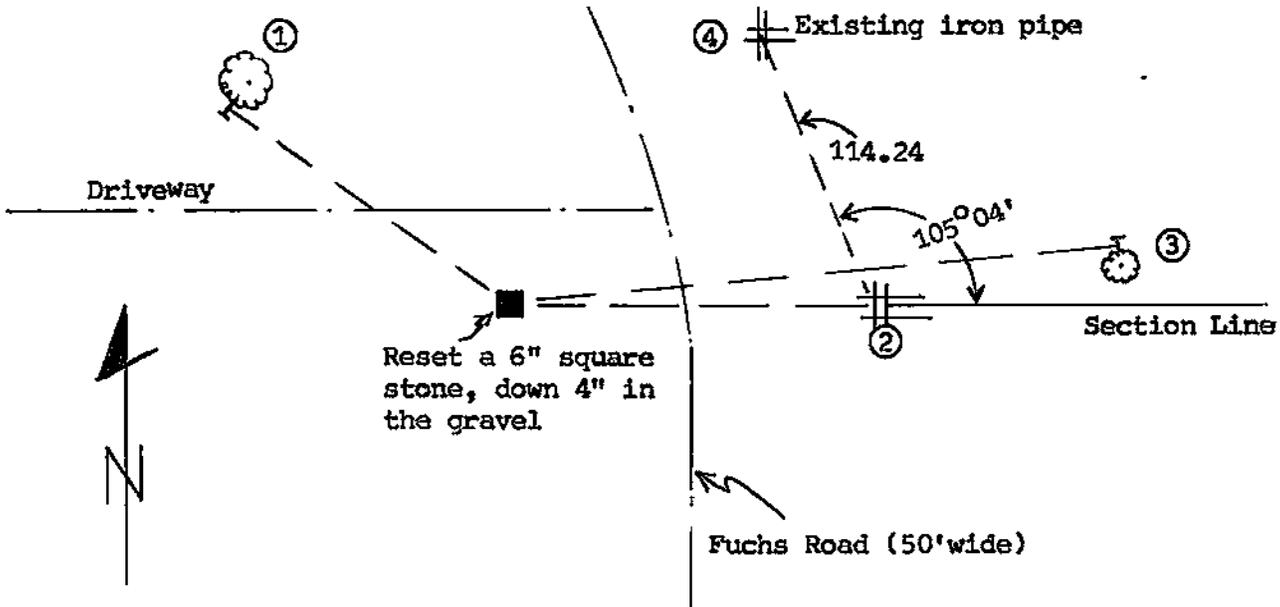

MAP SHOWING DISTANCE AND DIRECTION TO OTHER PUBLIC LAND SURVEY CORNERS USED FOR REESTABLISHING THE CORNER


(not to scale)

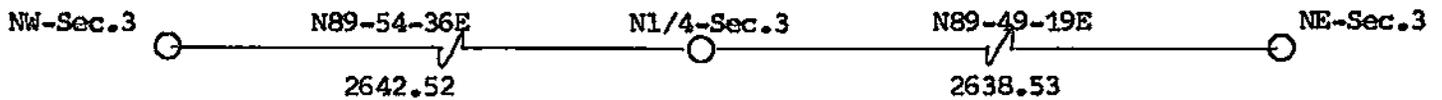

I, William C. Jung, Deputy County Surveyor,
 HEREBY CERTIFY THAT THE CORNER LOCATION SHOWN ON THIS RECORD
 WAS DETERMINED BY ME OR UNDER MY DIRECTION AND CONTROL AND
 THAT THIS U. S. PUBLIC LAND SURVEY MONUMENT RECORD IS CORRECT
 AND COMPLETE TO THE BEST OF MY KNOWLEDGE AND BELIEF.

William C. Jung
 Signature

March 18, 1987
 Date

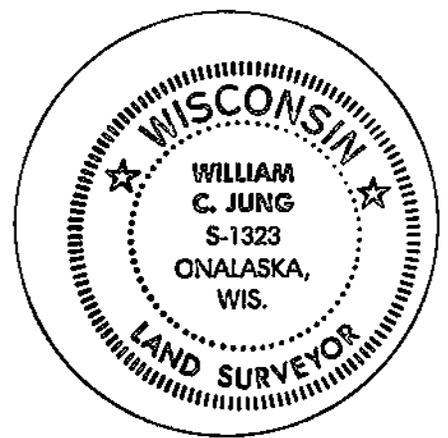

Seal