


21705342000

U. S. PUBLIC LAND SURVEY MONUMENT RECORD

SECTION 34 T 17 N, R 5 W, TOWN OF BURNS

LA CROSSE COUNTY

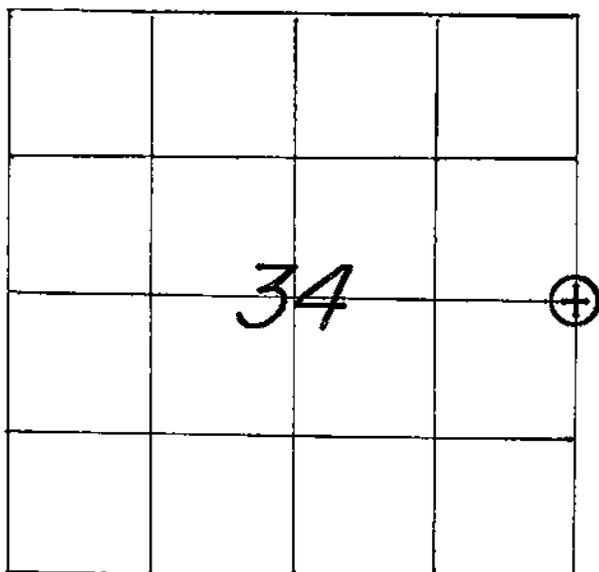

LOCATION OF LANDMARK

CREW: **WILLIAM G. JUNG**
PETER F. FOLLANSBEE
 DATE: **2/10/2004**

WISCONSIN COORDINATE SYSTEM

North

East

Theta Angle

Horiz. Order

Vert. Order

TYPE OF LANDMARK

3/4" IRON BAR WITH ALUMINUM CAP.

BEARINGS ARE REFERENCED TO

ASSUMED NORTH AS PER SECTION DATA.

(LaCrosse County Coordinate System)

Describe any record evidence, monument evidence, testimonial evidence or any other material evidence you considered and whether the monument was found or restored through acceptance of an obliterated evidence location.

Paul Fairchild arrived at the position of this corner after surveying to the section corners that I had tied off to the North and South. I agree with his location. It also falls almost at the occupied corner. I placed a Berntsen cap on his iron bar. This final corner location fits very well.

Describe or show any material discrepancy between the location of the restored corner and that of the corner previously restored or reestablished.

NONE KNOWN.

