


21705352000

U. S. PUBLIC LAND SURVEY MONUMENT RECORD

SECTION 36 T 17 N, R 5 W, TOWN OF BURNS

LA CROSSE COUNTY

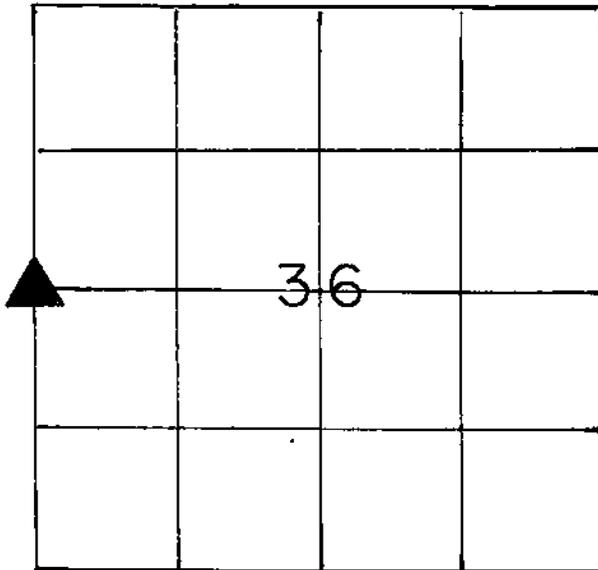

LOCATION OF LANDMARK

Crew: William Jung
Perry Dahl
3/26/86

Crew: William Jung
Peter Follansbee
8/18/00 and 7/20/01

Describe any record evidence, monument evidence, testimonial evidence or any other material evidence you considered and whether the monument was found or restored through acceptance of an obliterated evidence location.

I set the corner at a computed location so as to best fit the existing deeds and field evidence. I set a railroad spike at the corner.

7/20/01 - We set another railroad spike at the corner after the first was knocked out during the repaving of the road.

Describe or show any material discrepancy between the location of the restored corner and that of the corner previously restored or reestablished.

None known.

WISCONSIN COORDINATE SYSTEM

North

East

Theta Angle

Horiz. Order

Vert. Order

TYPE OF LANDMARK

Railroad Spike


BEARINGS ARE REFERENCED TO

Assumed

RECORD OF DURABLE WITNESS MONUMENTS

NO	DESCRIPTION	BEARING	DISTANCE
1	Set a 3/4"x19" iron bar	North \pm	33.00
2	To the Southwest corner of the Jerome tombstone, located 28' East of the fence.	-----	46.49
3	To the center NE corner of the phone box	-----	46.00
4			


45.80

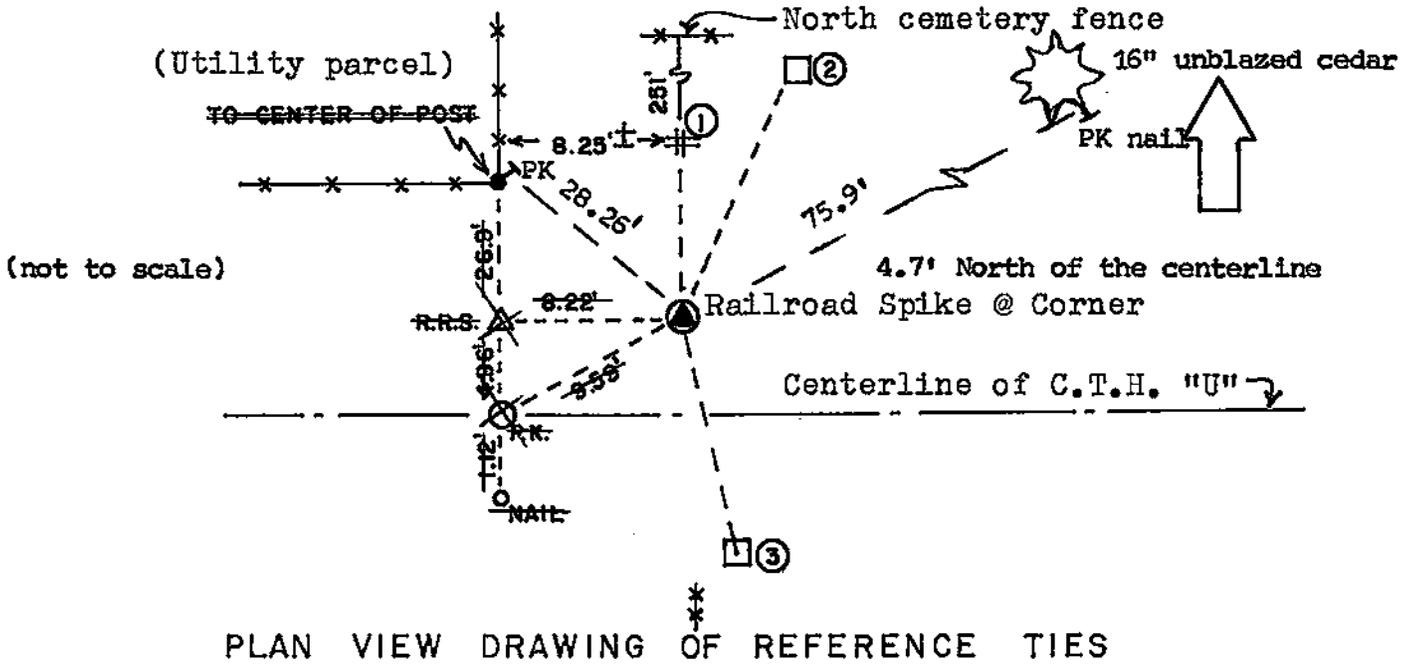

PLAN VIEW DRAWING OF REFERENCE TIES

MAP SHOWING DISTANCE AND DIRECTION TO OTHER PUBLIC LAND SURVEY CORNERS USED FOR REESTABLISHING THE CORNER

(not to scale)

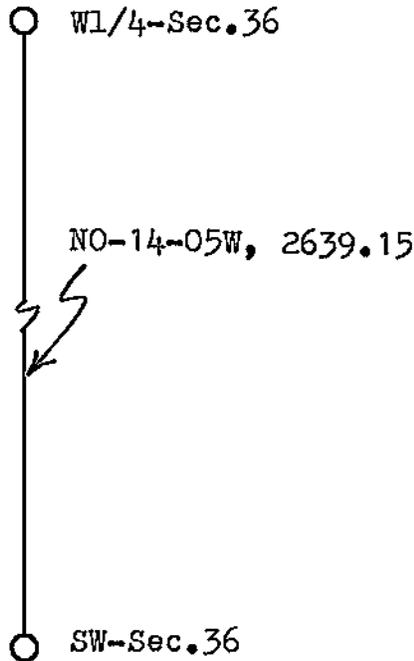


I, William C. Jung, Deputy County Surveyor,
 HEREBY CERTIFY THAT THE CORNER LOCATION SHOWN ON THIS RECORD
 WAS DETERMINED BY ME OR UNDER MY DIRECTION AND CONTROL AND
 THAT THIS U. S. PUBLIC LAND SURVEY MONUMENT RECORD IS CORRECT
 AND COMPLETE TO THE BEST OF MY KNOWLEDGE AND BELIEF.

William C. Jung
 Signature

4/28/86

Date

Revised: 4/30/02 *wcj*

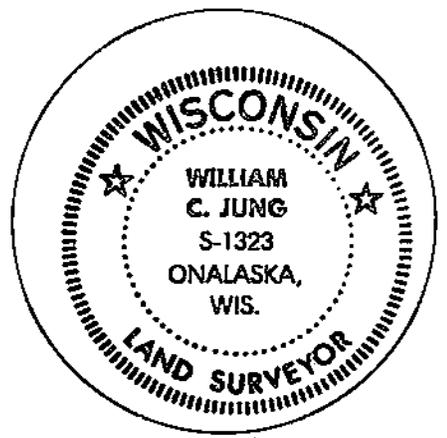

Seal