

CERTIFICATE

CERTIFIED LAND CORNER

No. 124

History of original corner establishment:

I, Harley A. Sime, do hereby certify that on the 22 day of October 1975, I found (re-established) (no evidence) of the corner of Section 31, T 17 N, R 4W Fourth Principal Meridian, and I re-established said corner according to the Wisconsin Statutes as shown and described hereon.

Dated this 5 day of March 1976.

County Surveyor

Description of corner evidence found:  
 Accepted, the existing field conditions. By the aerial photo, the centerline of the road at this location matched well with the quarterline fence to the East. The 1/2 mile distance to the CW corner, Sec. 36, T17N-R5W (existing 2" iron pipe) fit reasonably well. The North-South fence at the corner is in fair condition. I placed the corner at the intersection of the fence extended and the centerline of the road.


Description of corner and witness monuments, references and accessories used to perpetuate the original or re-established location of this corner:

Set Harrison monument, down 2"

Witnesses to corner location:

D.I. Malliet - Grew Chief, Reg. Surveyor

A. Ineck

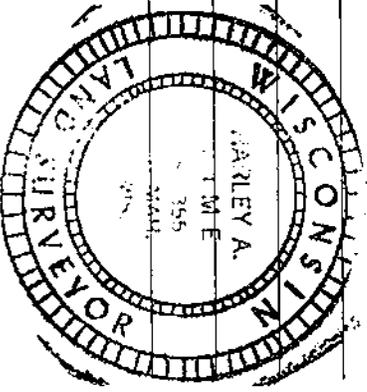

SURVEY CONTROL ORDER

Horizontal

Vertical

East (X)

North (Y)

Elevation (Z)

Zone




WISCONSIN COORDINATE SYSTEM

City, Village or Town Sparta

County of Monroe

"LaCrosse County" sign

Harrison down 2"

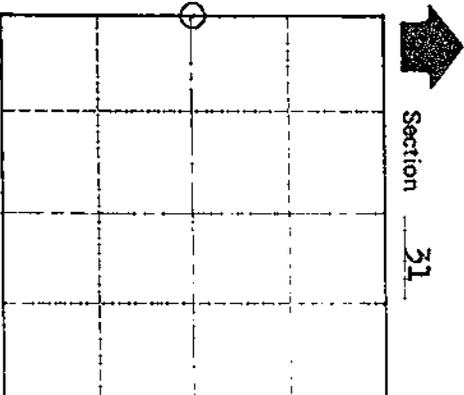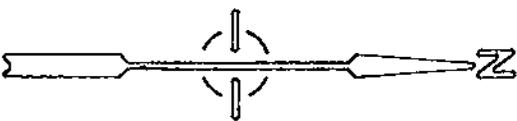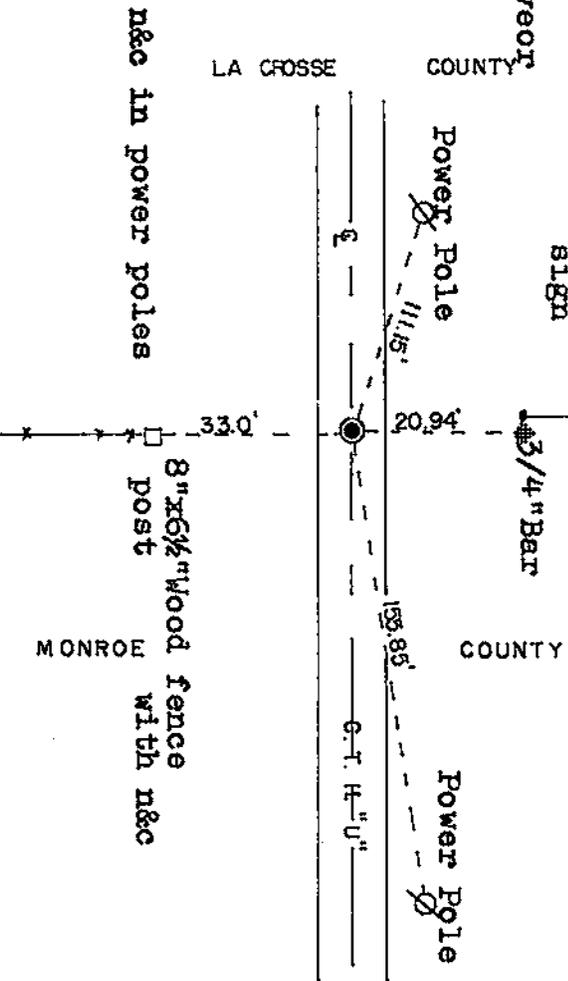

Section 31

O = LOCATION CORNER

T 17 N R 4W

WISCONSIN