


U. S. PUBLIC LAND SURVEY MONUMENT RECORD

SECTION 7 T 17 N, R 5 W, TOWN OF Burns

LA CROSSE COUNTY

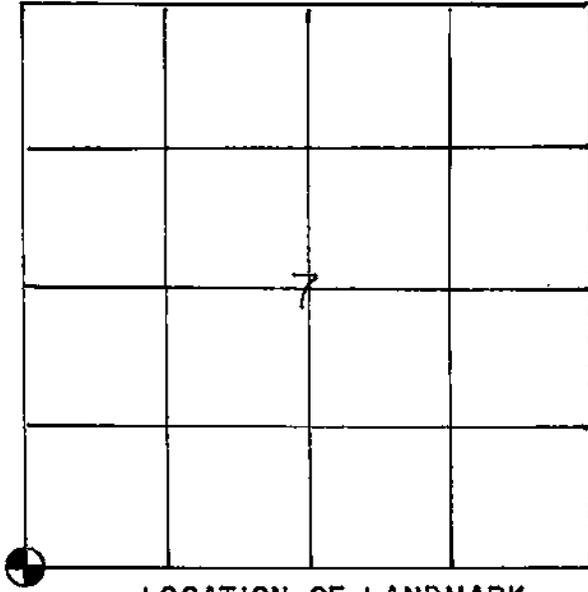

LOCATION OF LANDMARK

Crew: William C. Jung	William C. Jung
Perry L. Dahl	Peter Follansbee
2-4-87	6-28-05

WISCONSIN COORDINATE SYSTEM

North
East
Theta Angle
Horiz. Order
Vert. Order

TYPE OF LANDMARK
 1 1/2" iron pipe w/red plastic plug

BEARINGS ARE REFERENCED TO
 Bearings are referenced to True North as per Hofmeister's survey in 1983.

Describe any record evidence, monument evidence, testimonial evidence or any other material evidence you considered and whether the monument was found or restored through acceptance of an obliterated evidence location.


I found an iron pipe at the corner that Greg Hofmeister either found or set in 1983. He apparently used this pipe as the corner. I accepted the pipe as the best available evidence of the original government corner position. There also was tie wire at this location. I also chained North and searched for the old government line tree but found no sign of it.

Describe or show any material discrepancy between the location of the restored corner and that of the corner previously restored or reestablished.

None known.

RECORD OF DURABLE WITNESS MONUMENTS
MAGNETIC


NO	DESCRIPTION	BEARING	DISTANCE	
1	P.K. ^{new} nail in double blazed hickory ^{existing} 8"	N 8° E N12° E	22.41'	22.23'
2	new nail " " 9"	N48° W N44° W	36.99'	37.02'
3	" " 7"	N58° W N50° W	29.13'	28.76'
4	" " 10"	S10° W S12° W	11.46'	

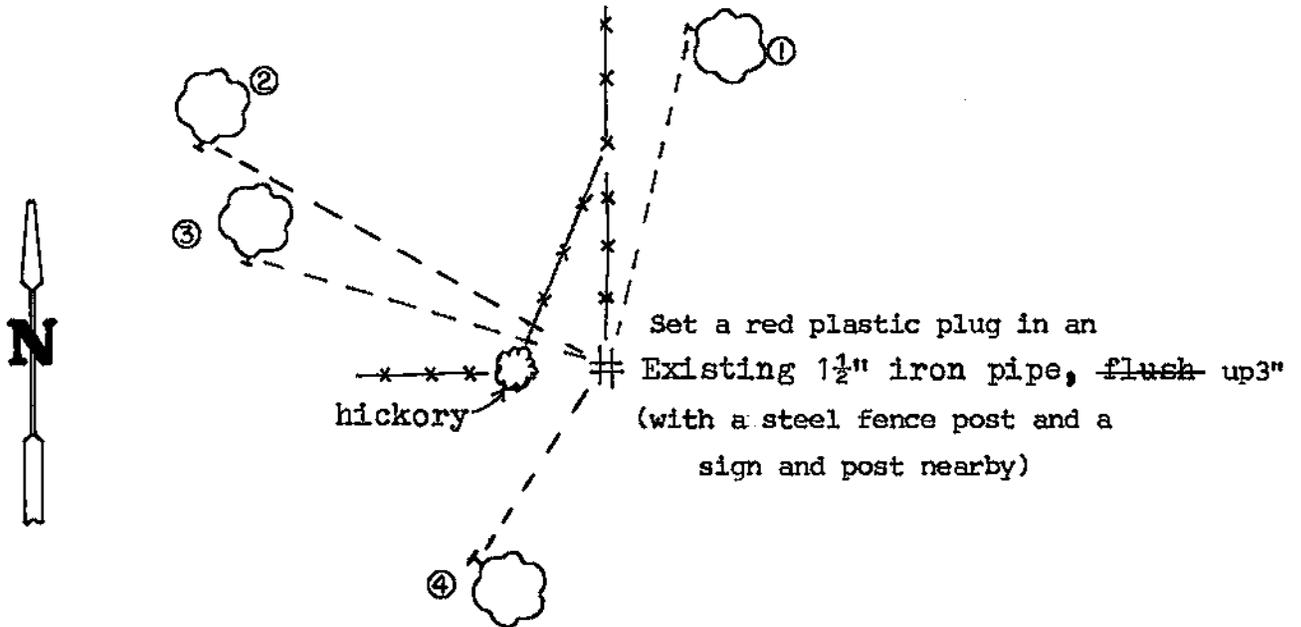

PLAN VIEW DRAWING OF REFERENCE TIES

MAP SHOWING DISTANCE AND DIRECTION TO OTHER PUBLIC LAND SURVEY CORNERS USED FOR REESTABLISHING THE CORNER


(not to scale)

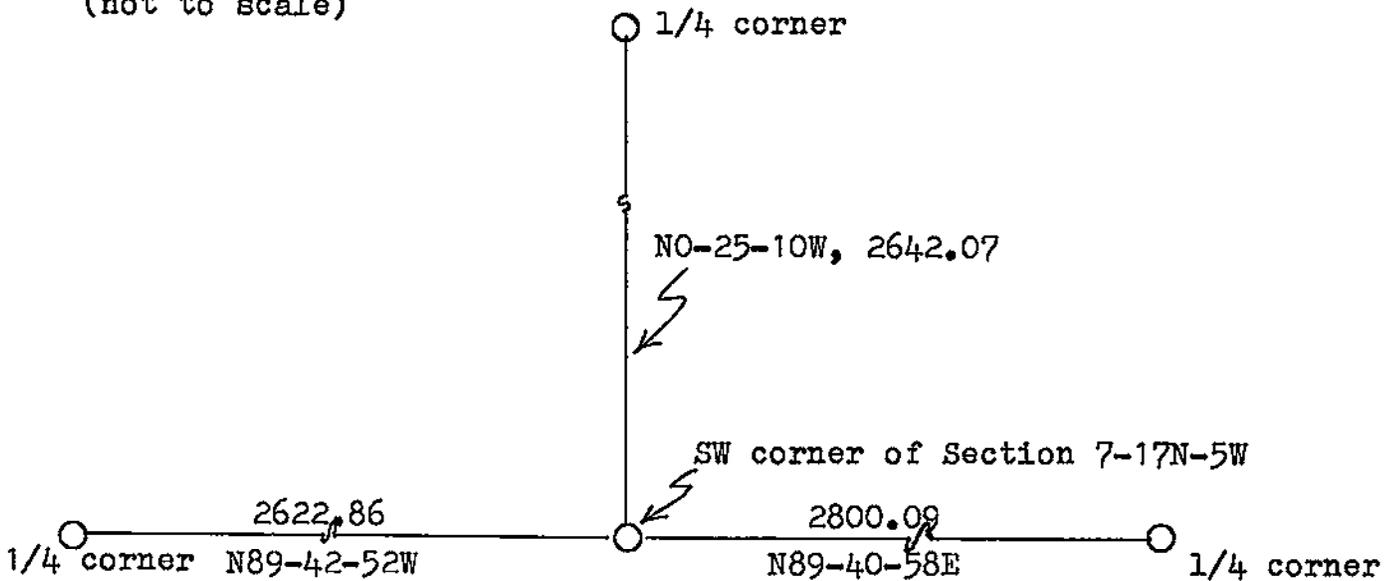

I, William C. Jung, Deputy County Surveyor,
HEREBY CERTIFY THAT THE CORNER LOCATION SHOWN ON THIS RECORD
WAS DETERMINED BY ME OR UNDER MY DIRECTION AND CONTROL AND
THAT THIS U. S. PUBLIC LAND SURVEY MONUMENT RECORD IS CORRECT
AND COMPLETE TO THE BEST OF MY KNOWLEDGE AND BELIEF.

William C. Jung
Signature

February 9, 1987
Date

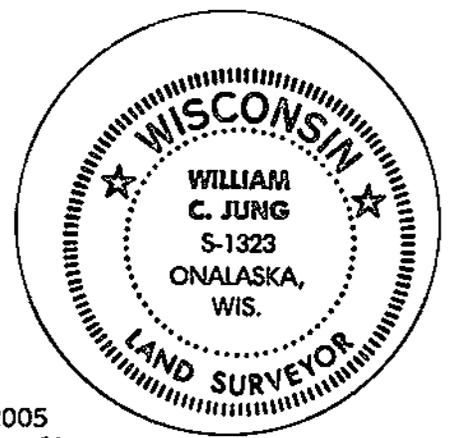

Revised: Sept. 9, 2005

asej

Seal