


U. S. PUBLIC LAND SURVEY MONUMENT RECORD

SECTION 30 T 17 N, R 5 W, TOWN OF BURNS

LA CROSSE COUNTY

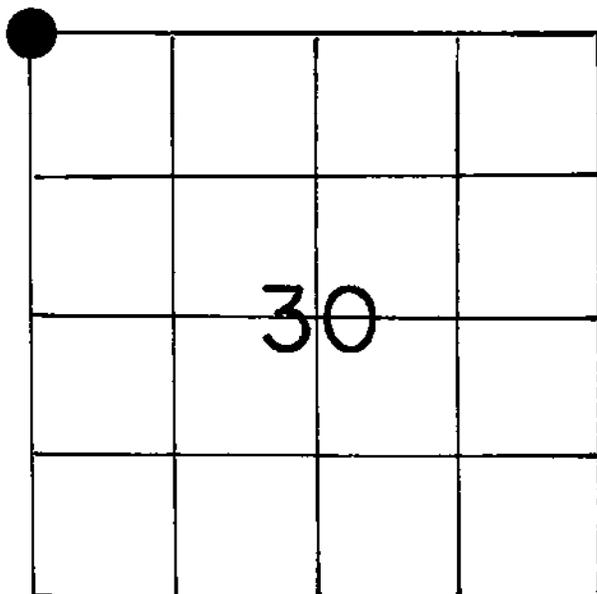

LOCATION OF LANDMARK

Crew: WILLIAM C. JUNG  
 PETER F. FOLLANSBEE

Date: 5-03-1990

Describe any record evidence, monument evidence, testimonial evidence or any other material evidence you considered and whether the monument was found or restored through acceptance of an obliterated evidence location.

I accepted the occupied corner as the best available evidence of the original government corner position and monumented the corner with a Lunde marker.


Describe or show any material discrepancy between the location of the restored corner and that of the corner previously restored or reestablished.

None Known

WISCONSIN COORDINATE SYSTEM
North
East
Theta Angle
Horiz. Order
Vert. Order
TYPE OF LANDMARK
BRASS CAPPED LUNDE MARKER
BEARINGS ARE REFERENCED TO
TRUE

**RECORD OF DURABLE WITNESS MONUMENTS**  
MAGNETIC


NO	DESCRIPTION	BEARING	DISTANCE
1	Set P.K. in SW-side of 6" Hickory	N 33° W	36.10 Ft.
2	Set P.K. in West side of double Hickory	N 18° E	31.92 Ft.
3	Set P.K. in NW-side of 16" Oak	Easterly	16.71 Ft.
4	Set P.K. in North side of 6" Hickory	Easterly	37.51 Ft.

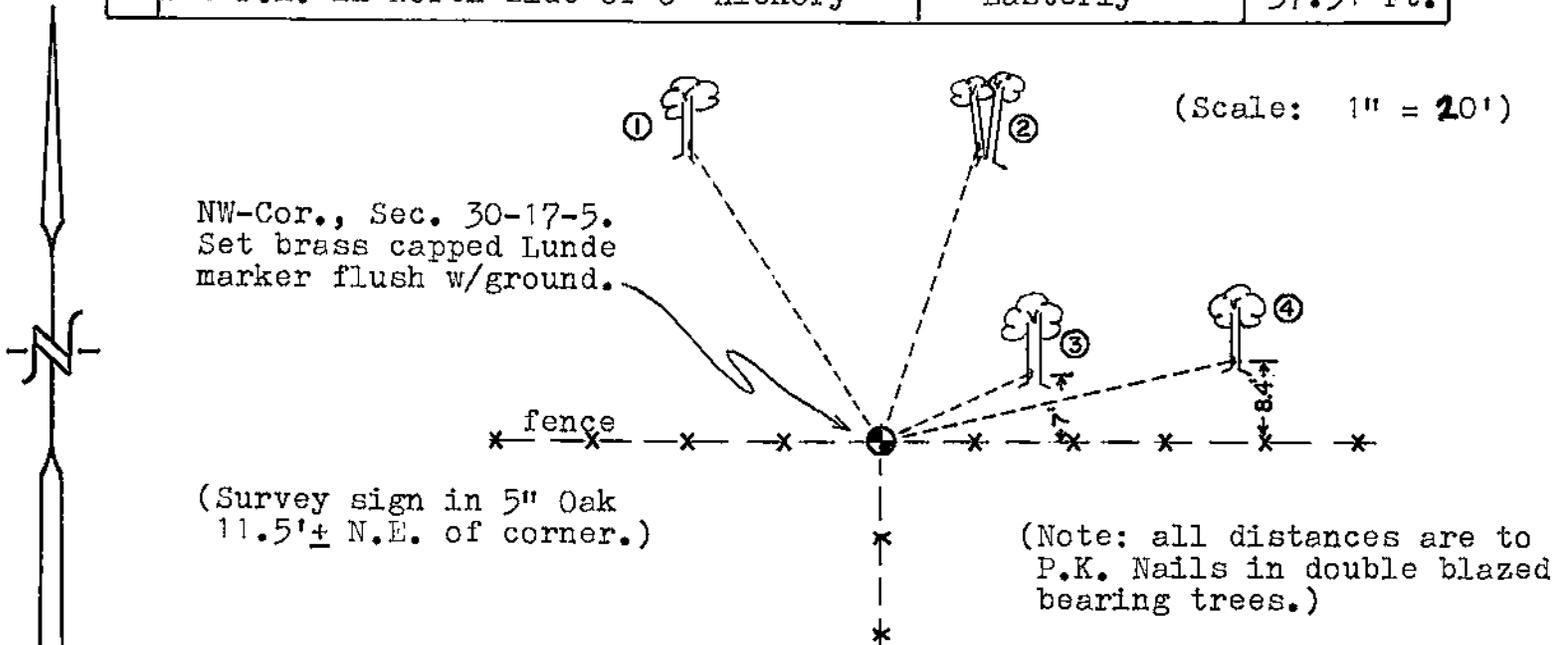

PLAN VIEW DRAWING OF REFERENCE TIES


**MAP SHOWING DISTANCE AND DIRECTION TO OTHER PUBLIC LAND SURVEY CORNERS USED FOR REESTABLISHING THE CORNER**

(not to scale)

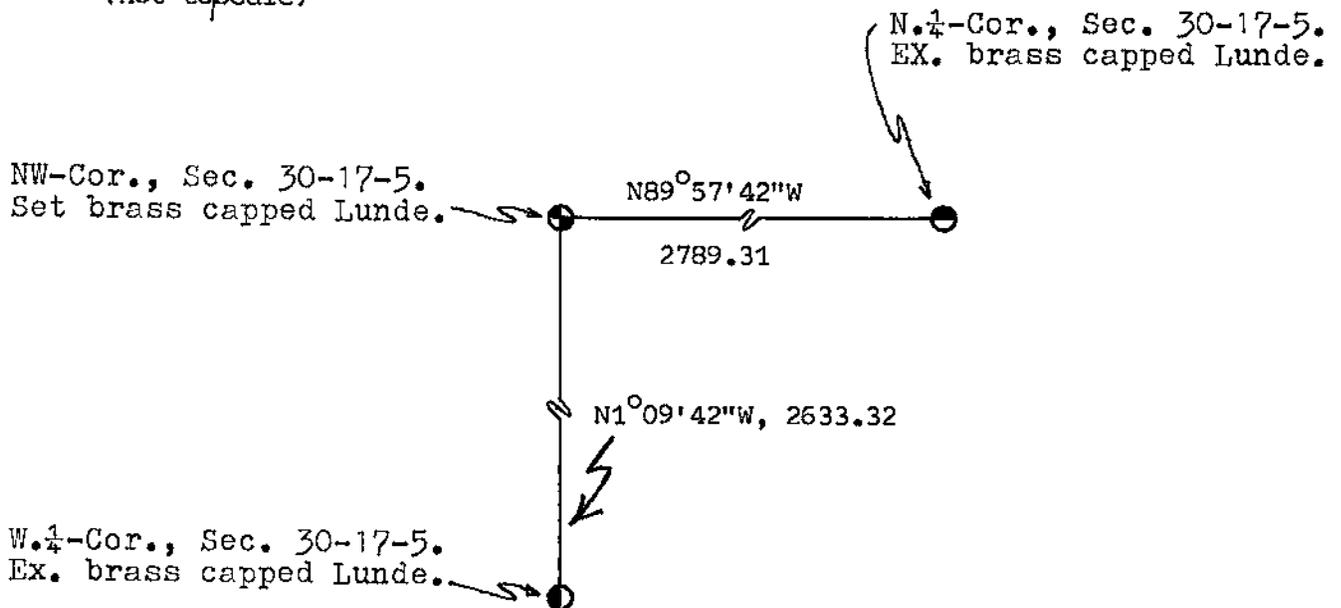

I, William C. Jung, Deputy County Surveyor  
HEREBY CERTIFY THAT THE CORNER LOCATION SHOWN ON THIS RECORD  
WAS DETERMINED BY ME OR UNDER MY DIRECTION AND CONTROL AND  
THAT THIS U. S. PUBLIC LAND SURVEY MONUMENT RECORD IS CORRECT  
AND COMPLETE TO THE BEST OF MY KNOWLEDGE AND BELIEF.

William C. Jung February 12, 1991  
Signature Date

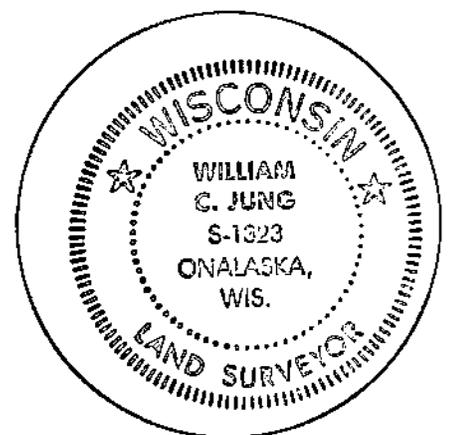

Seal