


21706362000

## U. S. PUBLIC LAND SURVEY MONUMENT RECORD

SECTION 31 T 17 N, R 5 W, TOWN OF BURNS

LA CROSSE COUNTY

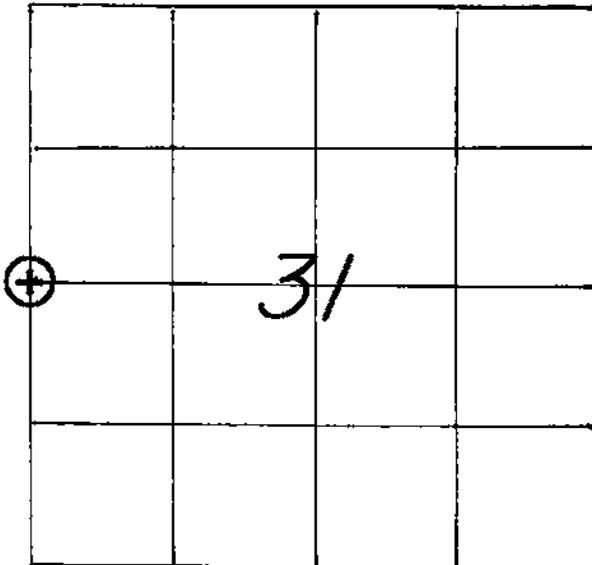

LOCATION OF LANDMARK

CREW: **WILLIAM C. JUNG**  
**PETER F. FOLLANSBEE**  
 DATE: **12/15/2000**

WISCONSIN COORDINATE SYSTEM	
North	<b>696,516.310</b>
East	<b>1,696,756.710</b>
Theta Angle	
Horiz. Order	
Vert. Order	
DATUM:	<b>83 ('91)</b>
TYPE OF LANDMARK	
<b>3/4" x 30" IRON BAR WITH ALUMINUM CAP.</b>	
BEARINGS ARE REFERENCED TO	
<b>GRID NORTH AS PER SECTION DATA.</b>	

Describe any record evidence, monument evidence, testimonial evidence or any other material evidence you considered and whether the monument was found or restored through acceptance of an obliterated evidence location.


I set the corner in the old North-South fence and equidistant between the section corners. Set as such the North-South fence at the W1/16NW corner is right on line. The corner was monumented with an iron bar and cap.

Describe or show any material discrepancy between the location of the restored corner and that of the corner previously restored or reestablished.


**NONE KNOWN.**

RECORD OF DURABLE WITNESS MONUMENTS  
MAGNETIC

NO	DESCRIPTION	BEARING	DISTANCE
1	SET A NAIL IN THE N.W.-SIDE 12" TRIPLE ASH ?	N 45° E	20.99 FT.
2	SET A NAIL IN THE S.W.-SIDE 13" ASH ?	S 69° E	47.38 FT.
3	SET A NAIL IN THE S.W.-SIDE 13" DOUBLE OAK ?	S 15° E	16.19 FT.
4	SET A NAIL IN THE W.-SIDE 16" DOUBLE OAK ?	S 08° E	22.31 FT.

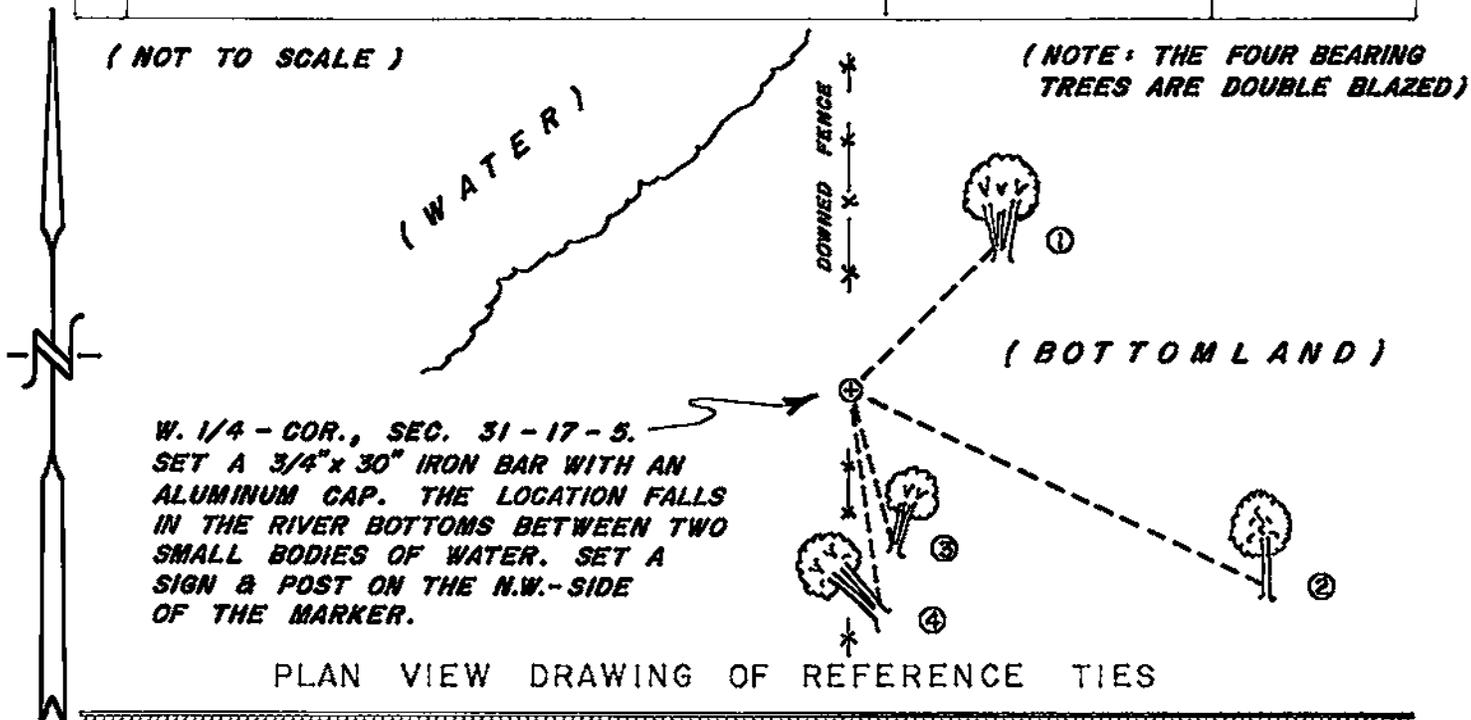

MAP SHOWING DISTANCE AND DIRECTION TO OTHER PUBLIC LAND SURVEY CORNERS USED FOR REESTABLISHING THE CORNER

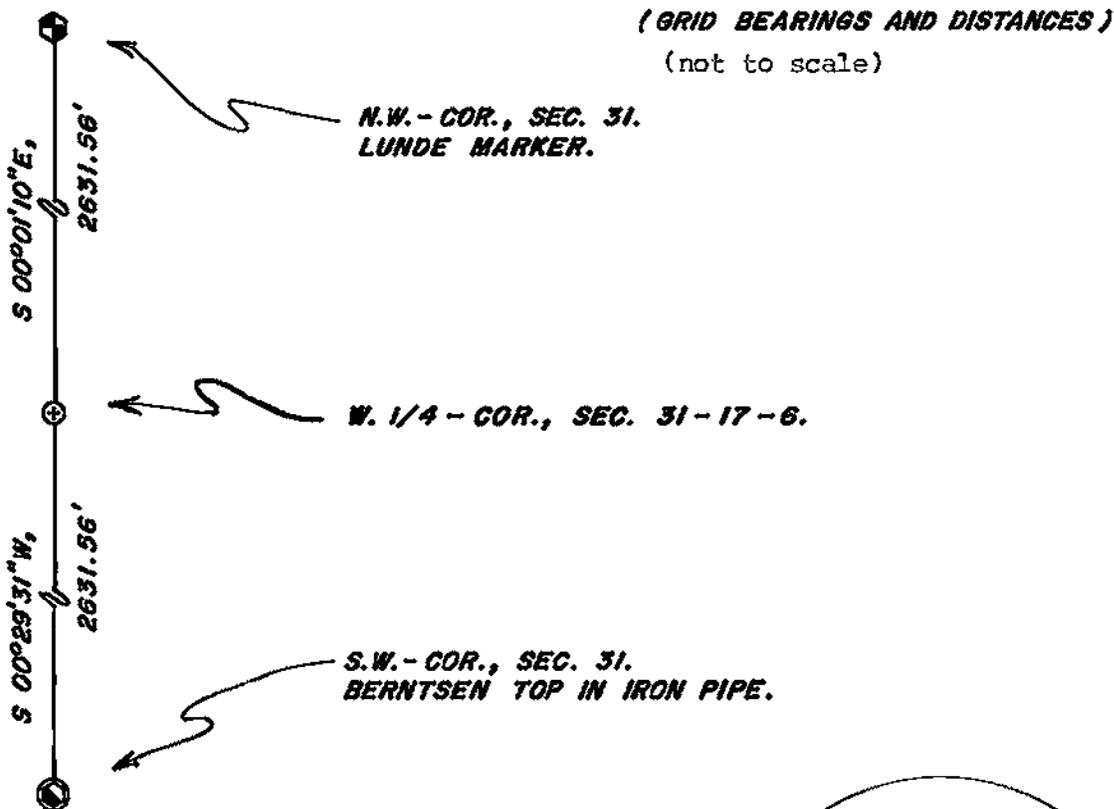

I, WILLIAM C. JUNG, COUNTY SURVEYOR  
HEREBY CERTIFY THAT THE CORNER LOCATION SHOWN ON THIS RECORD WAS DETERMINED BY ME OR UNDER MY DIRECTION AND CONTROL AND THAT THIS U. S. PUBLIC LAND SURVEY MONUMENT RECORD IS CORRECT AND COMPLETE TO THE BEST OF MY KNOWLEDGE AND BELIEF.

William C. Jung 12/21/00  
Signature Date



Seal