


## U. S. PUBLIC LAND SURVEY MONUMENT RECORD

SECTION 2 T 17 N, R 5 W, TOWN OF BURNS

LA CROSSE COUNTY

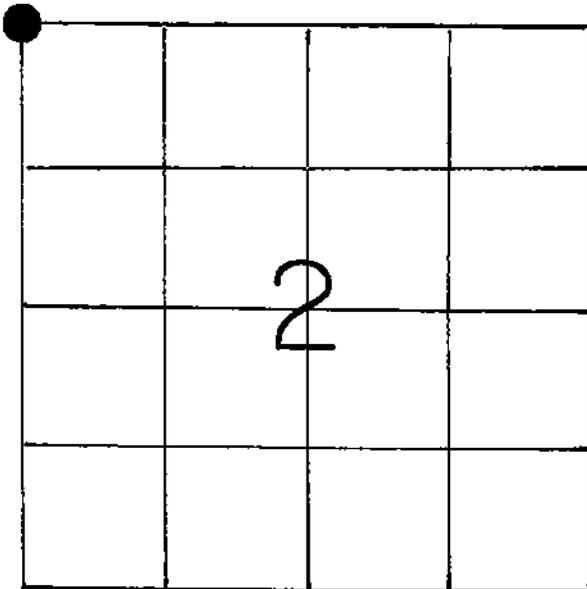

LOCATION OF LANDMARK

Crew: WILLIAM C. JUNG  
PETER F. FOLLANSBEE

Date: 9/21/1992

Describe any record evidence, monument evidence, testimonial evidence or any other material evidence you considered and whether the monument was found or restored through acceptance of an obliterated evidence location.

I set a Lunde marker at the old occupied corner which I accepted as the best available evidence of the original government corner position. Marlin Young said that this location has been the accepted corner as long as he can remember.

Describe or show any material discrepancy between the location of the restored corner and that of the corner previously restored or reestablished.

None Known.

## WISCONSIN COORDINATE SYSTEM

North

East

Theta Angle

Horiz. Order

Vert. Order

## TYPE OF LANDMARK


Set brass cap Lunde marker.

## BEARINGS ARE REFERENCED TO

True (  $\pm 02'$  )


**RECORD OF DURABLE WITNESS MONUMENTS  
MAGNETIC**

NO	DESCRIPTION	BEARING	DISTANCE
1	Set P.K. Nail in NW-side 19" White Oak	S 63° W	33.20 Ft.
2	Set P.K. Nail in NE-side 12" White Oak	N 60° W	18.24 Ft.
3	Set P.K. Nail in SE-side 9" White Oak	N 63° E	28.84 Ft.
4	Set P.K. Nail in S-side 21" White Oak	N 86° E	47.83 Ft.

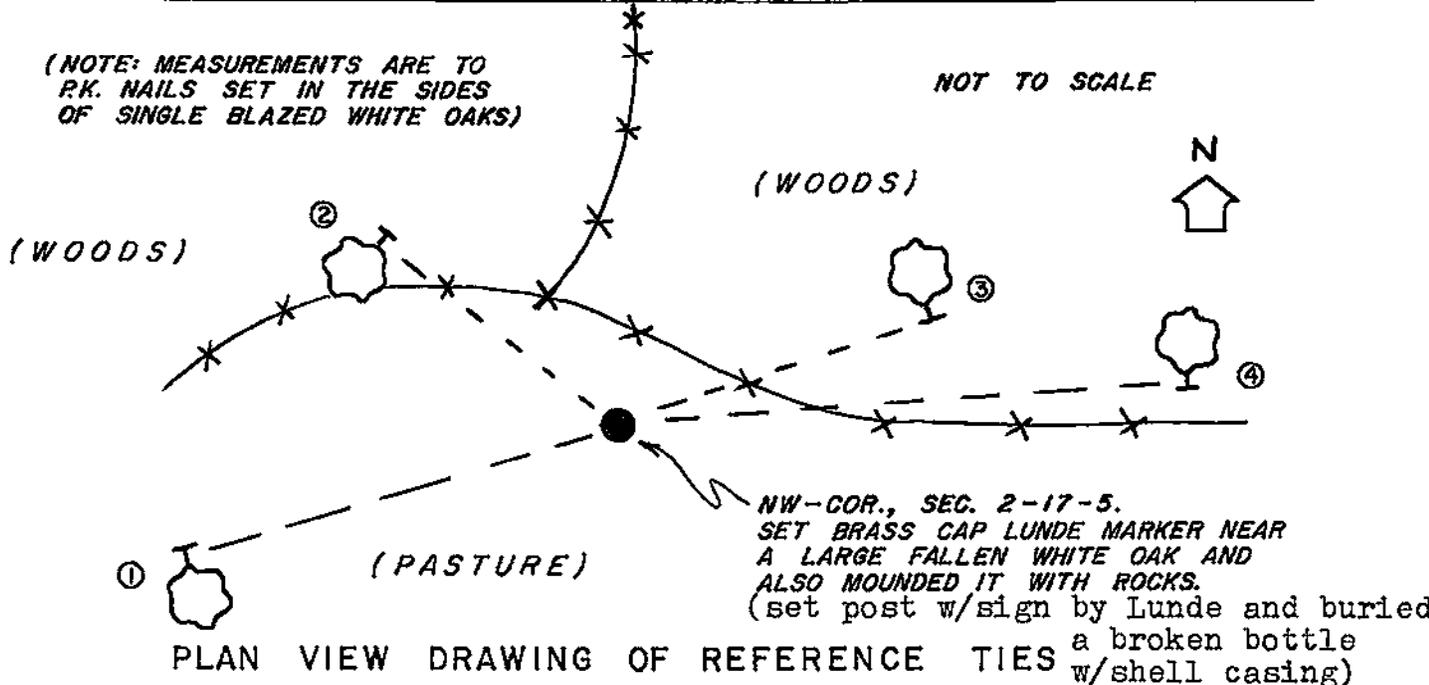

**MAP SHOWING DISTANCE AND DIRECTION TO OTHER PUBLIC LAND SURVEY CORNERS USED FOR REESTABLISHING THE CORNER**

(not to scale)

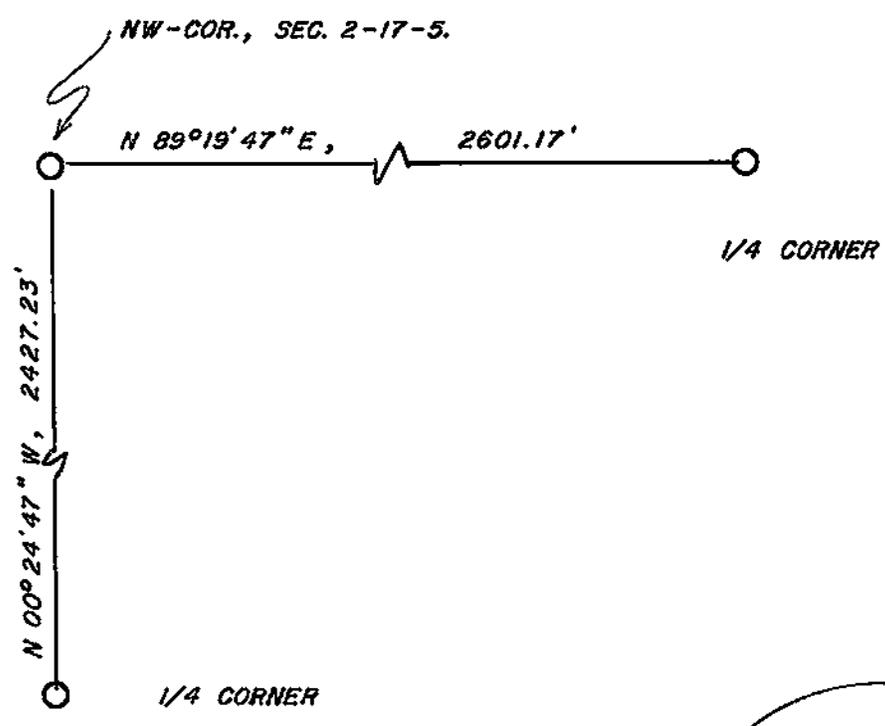

I, William C. Jung, Deputy County Surveyor  
HEREBY CERTIFY THAT THE CORNER LOCATION SHOWN ON THIS RECORD WAS DETERMINED BY ME OR UNDER MY DIRECTION AND CONTROL AND THAT THIS U. S. PUBLIC LAND SURVEY MONUMENT RECORD IS CORRECT AND COMPLETE TO THE BEST OF MY KNOWLEDGE AND BELIEF.

William C. Jung  
Signature

December 29, 1992  
Date

